


Application No. E-77440
Permit No.


Burns
1960
W.H. Beal

71031

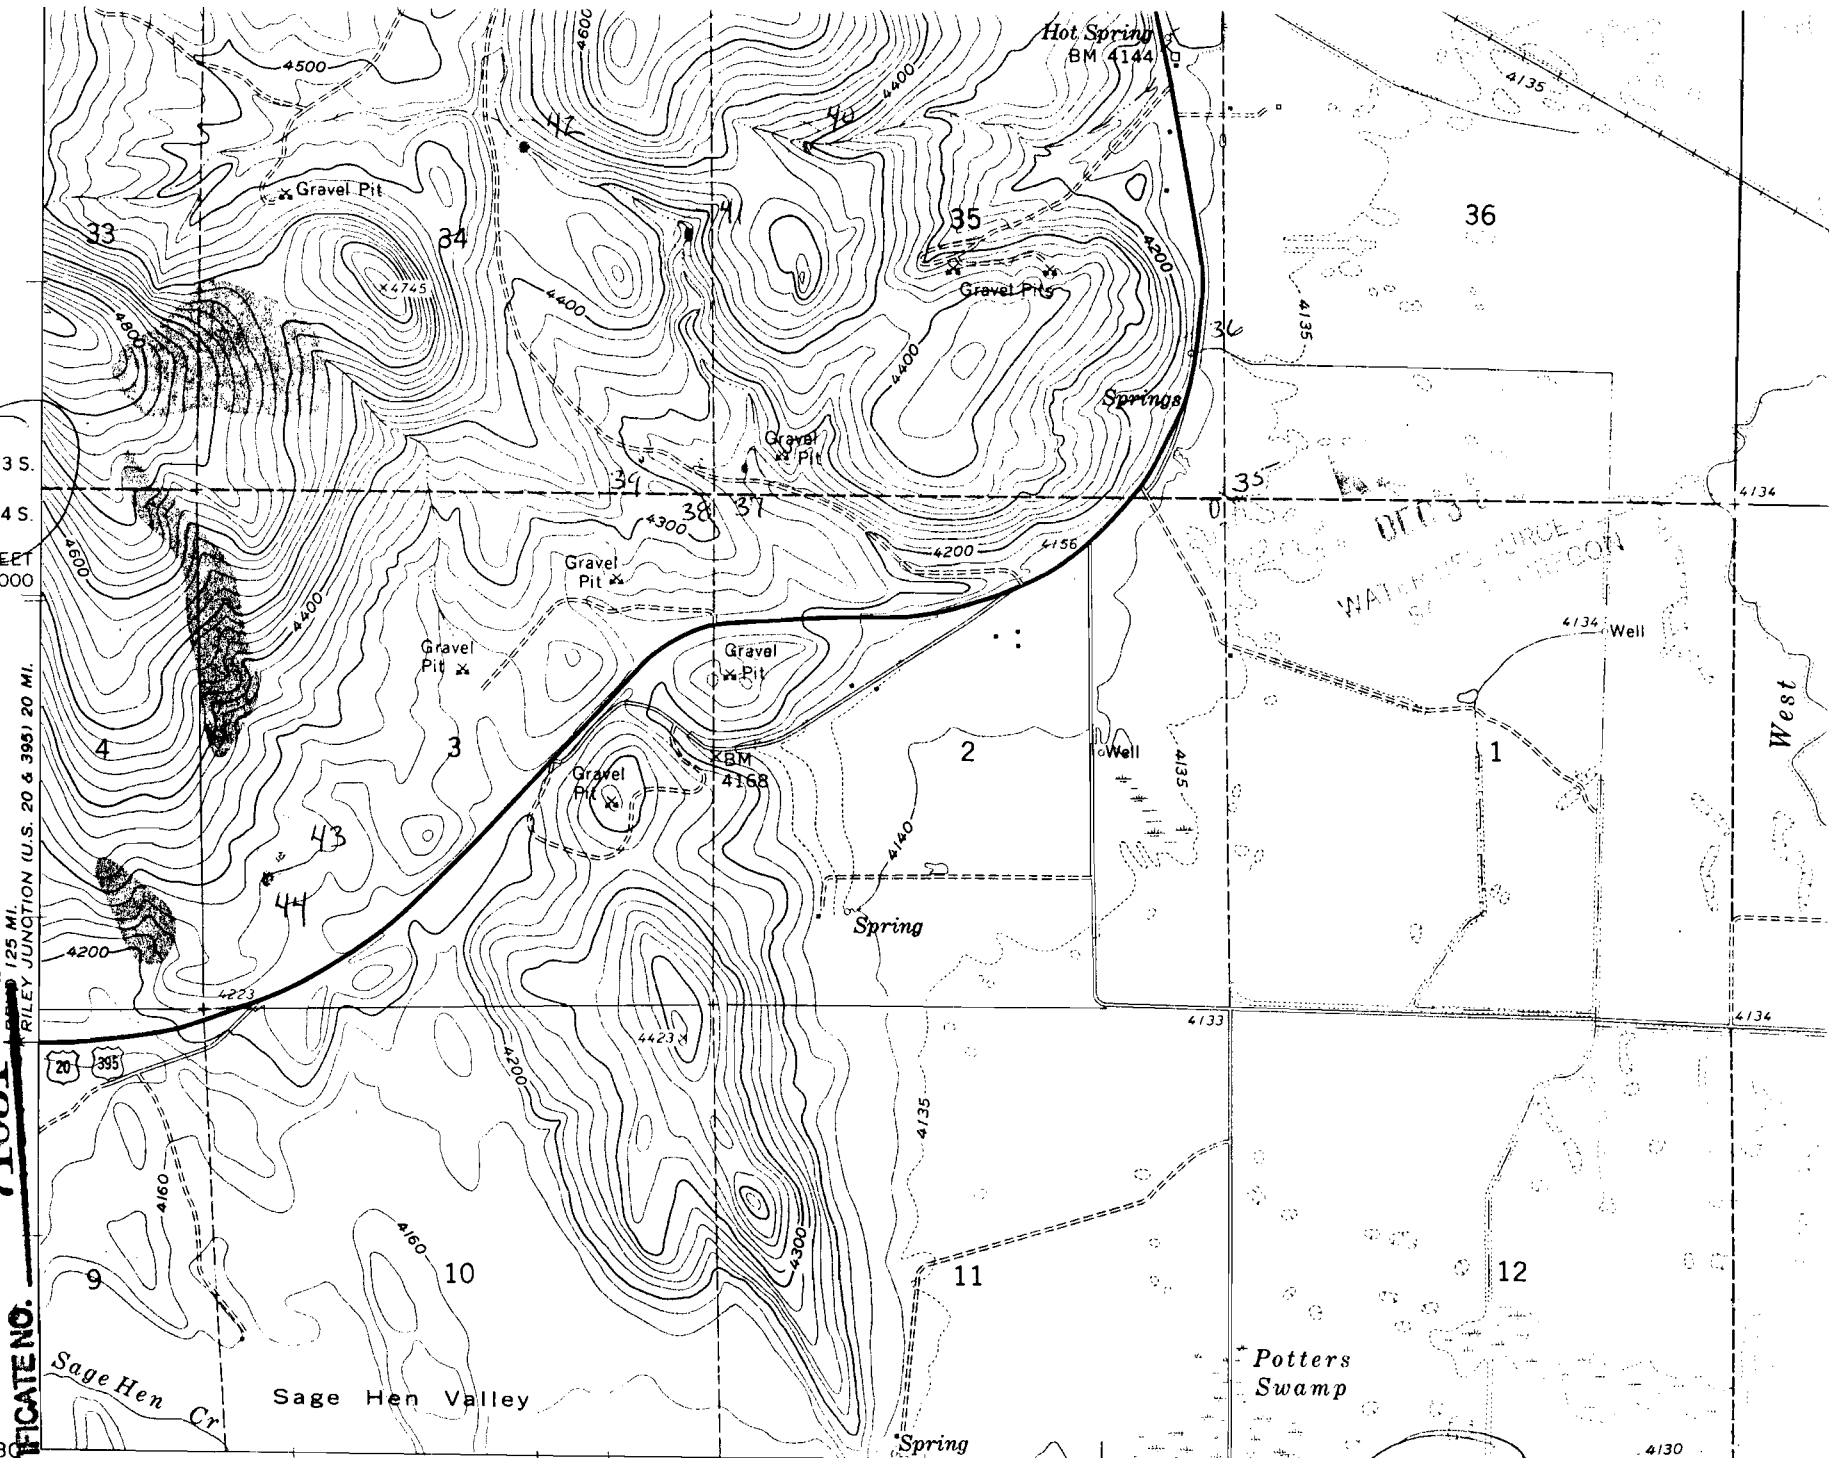

119° 07' 30" 2 370 000 FEET 5'

Maped, edited, and published by the Geological Survey
Control by USGS and USC&GS
Topography by photogrammetric methods from aerial

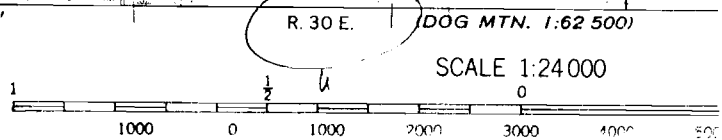

1:62 500