


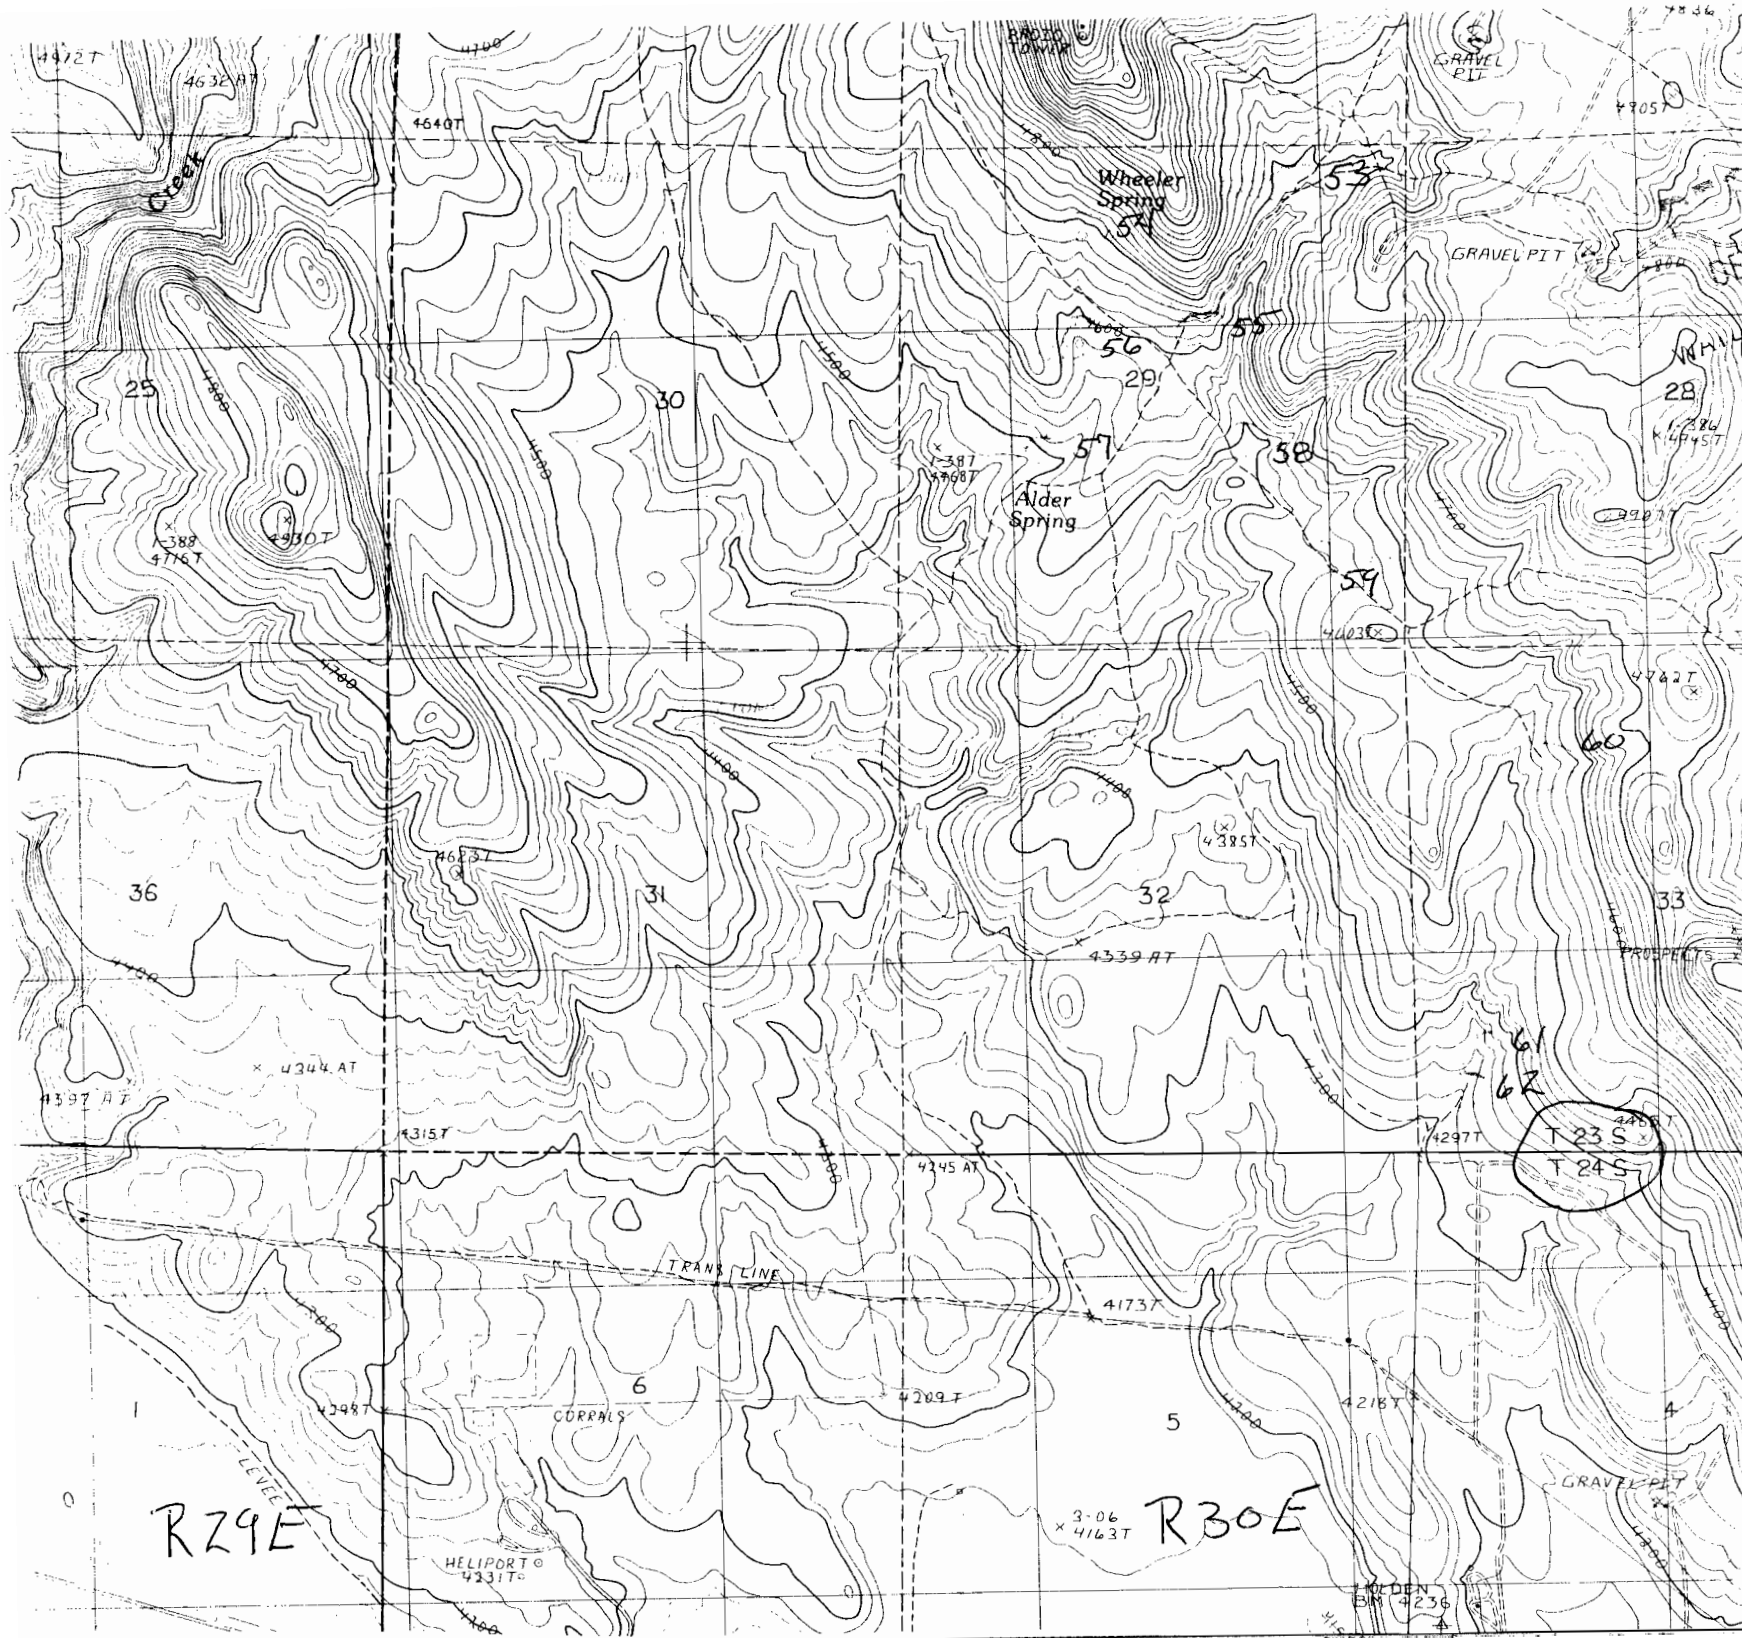

RECEIVED
DEC 30 1994
SALEM, OREGON

Burns Butte

1990
W.H.B.

32' 30"

Application No. R-77443
Permit No.

CERTIFICATE NO. 71034

R29E

R30E

HELIPORT
4331T

GOLDEN
BM 4236