


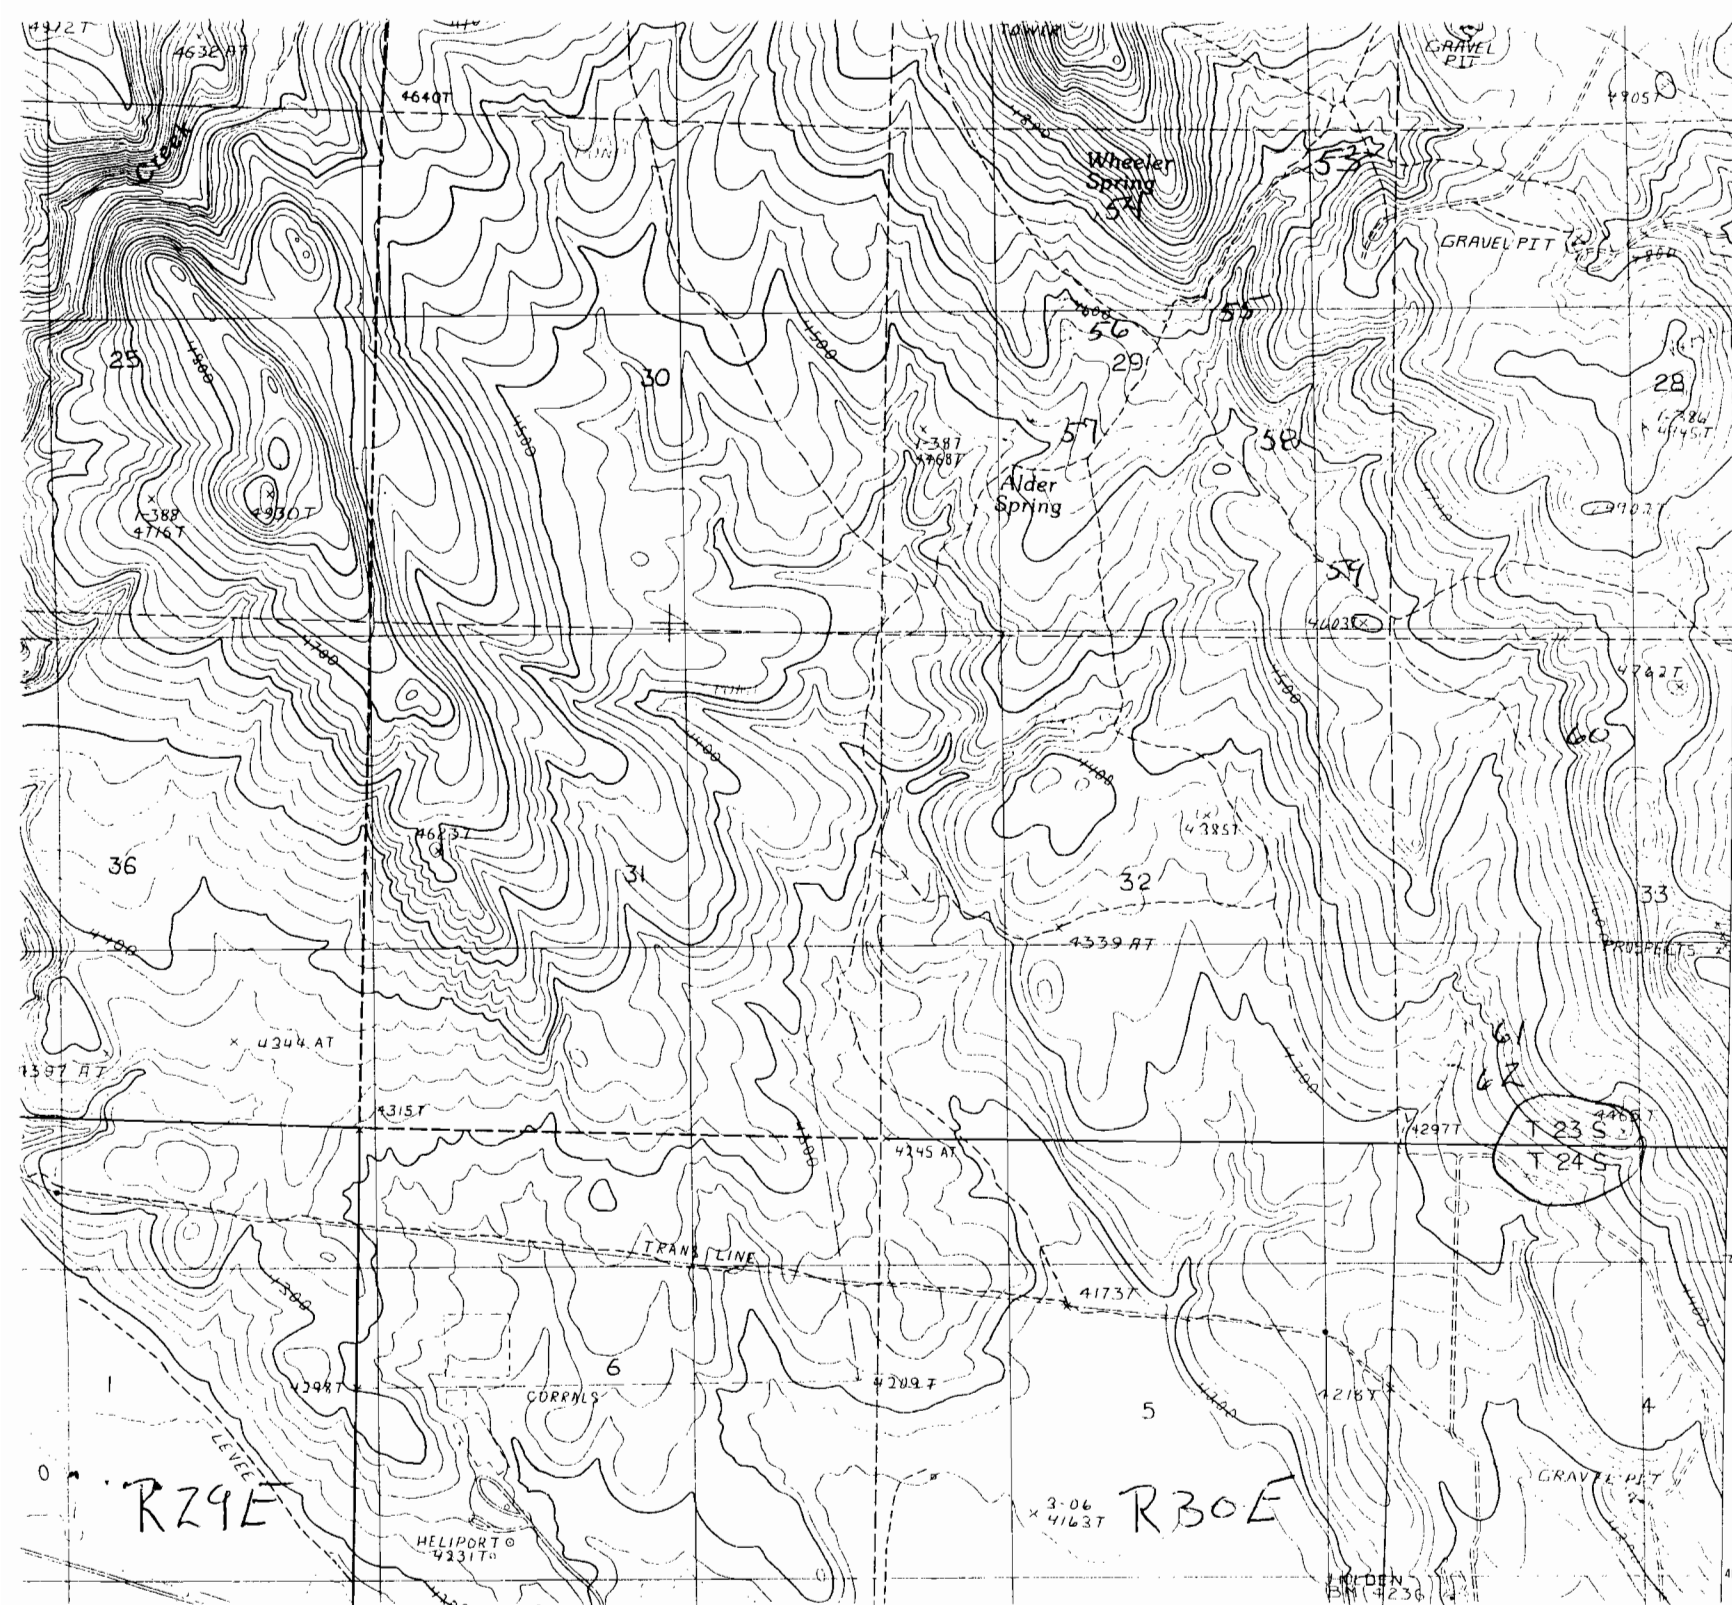

30 1994
24 SOURCES L.
SALEM, OREGON

Burns Butte

1990
W. H. R.

32' 30"

Application No. R-77444

Permit No.

71035

CERTIFICATE

4820