


Application No. R-77445

Permit No.

CERTIFICATE NO. 71036

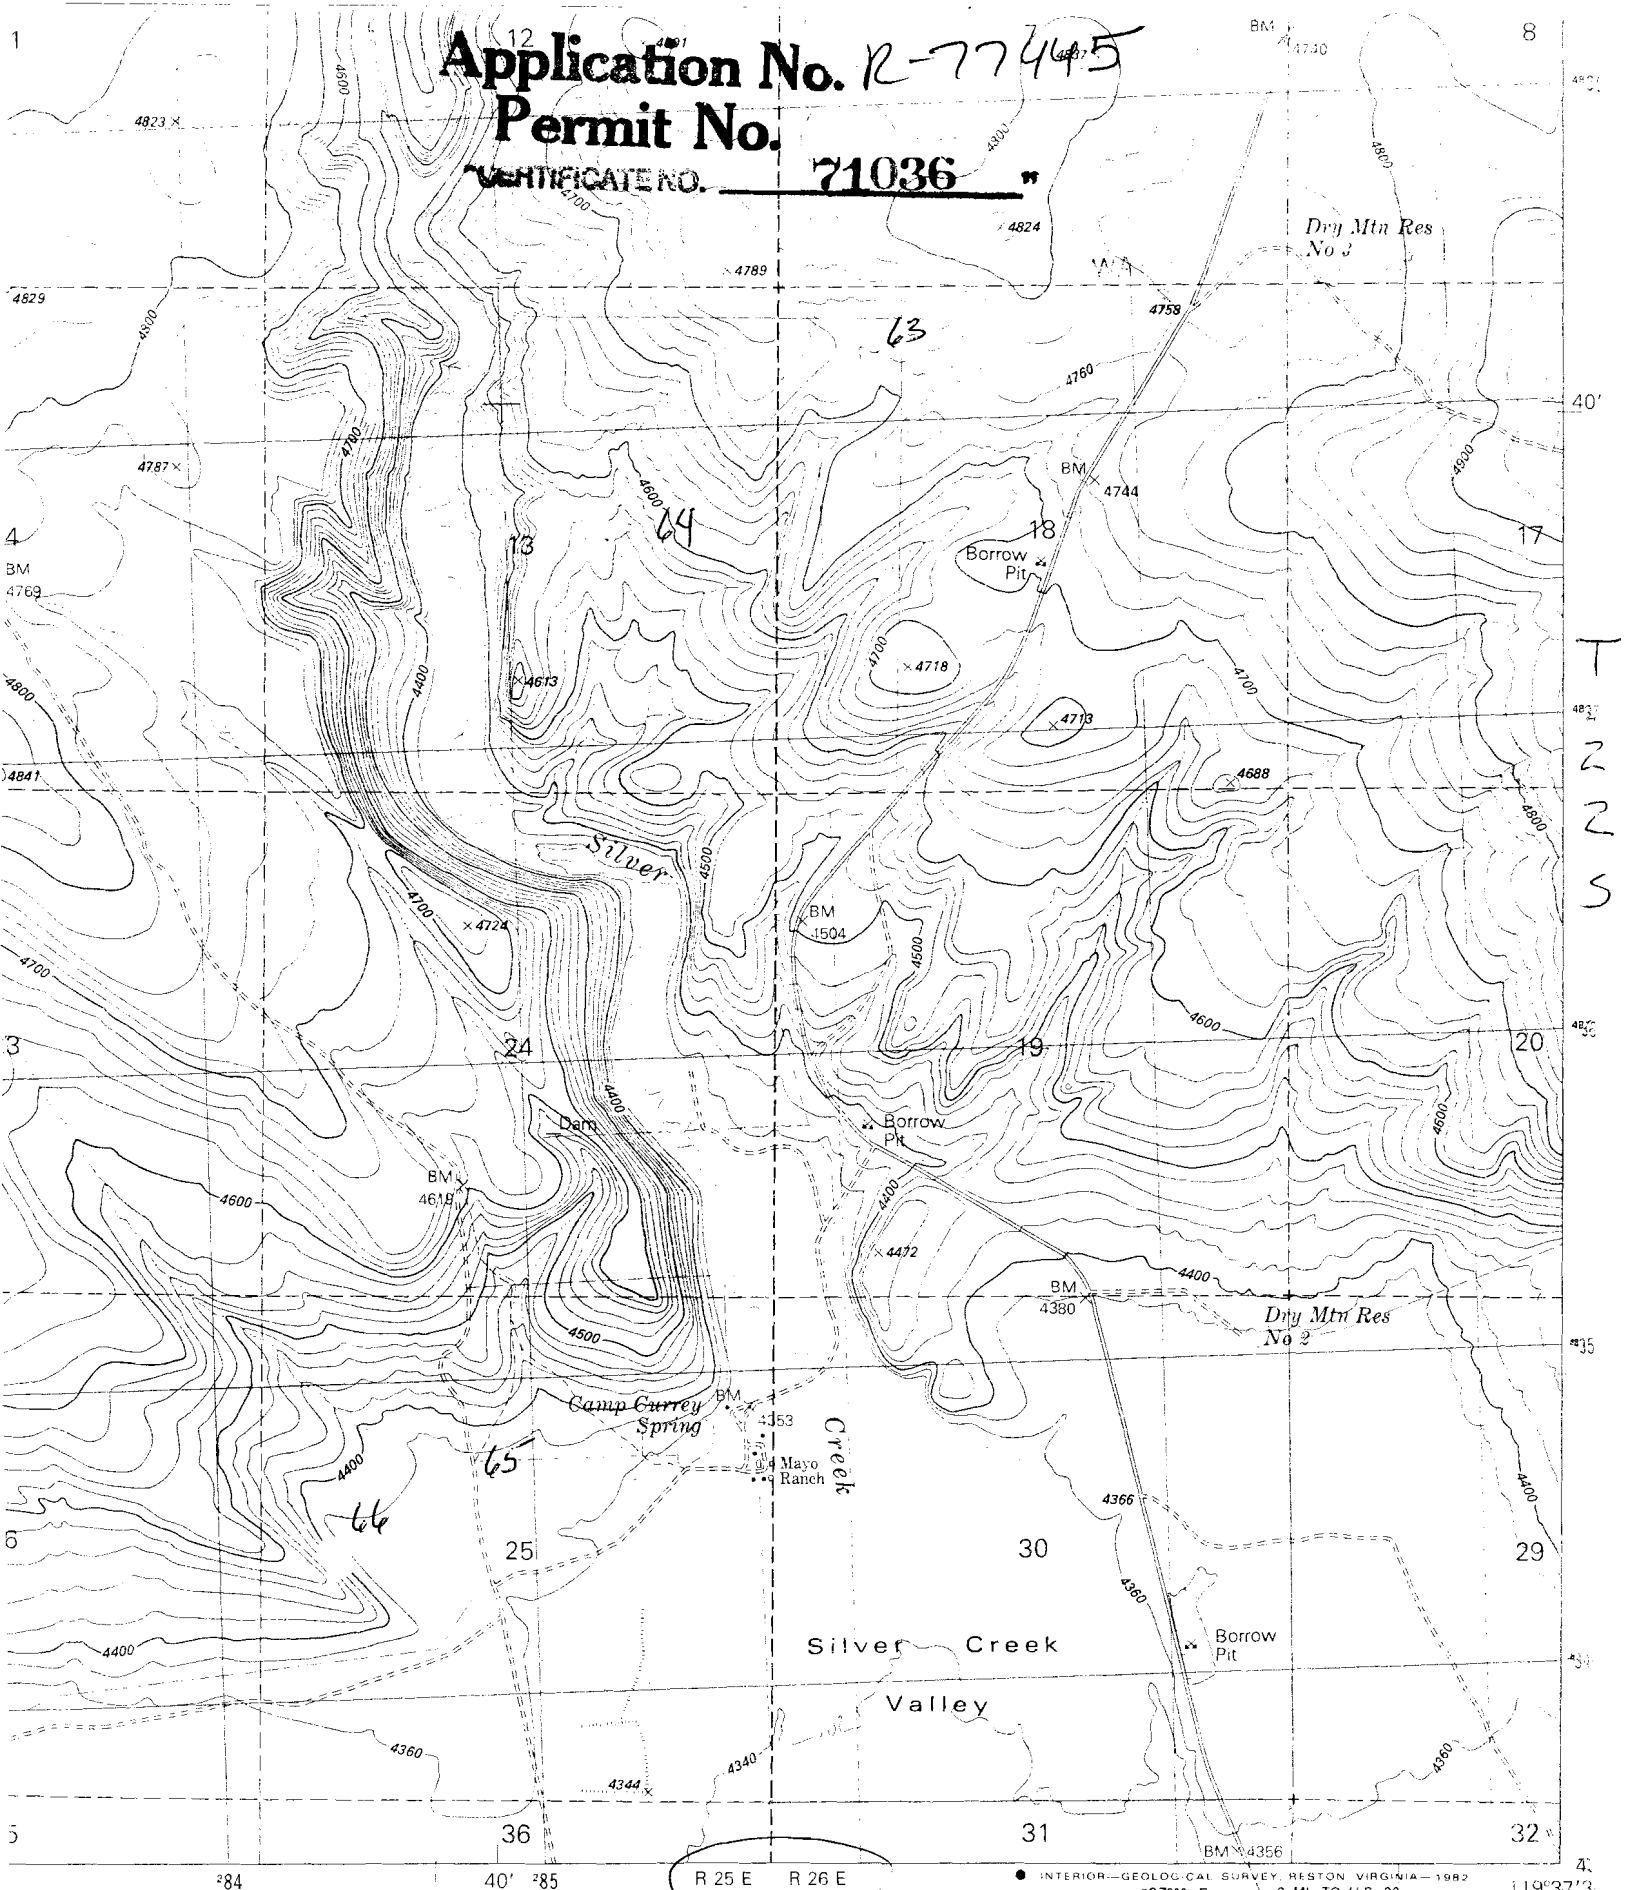

R 25 E R 26 E

INTERIOR—GEOLOGICAL SURVEY, RESTON, VIRGINIA—1982
287000mE 9 MI. TO U.S. 20 119°37'3

ROAD CLASSIFICATION

Primary highway,
hard surface

Light-duty road, hard or
improved surface

Secondary highway,
hard surface

Unimproved road

1 Mile
Camp Curry Spring
1981 ED
W+I Best

Application No. **R-77445**
Permit No.

7.5 MINUTE SERIES (TOPOGRAPHIC)

R 25 E R 26 E

2 230 000 FEET

119°37'30"

"CERTIFICATE NO. **71036**"

T 22 S

710 000
FEET

T 23 S

Suntex
1981 Ed
W.H. Reed

