


DEC 27 1994

WATER RESOURCES DEPT
SALEM, OREGON

T2S R2W

SEE MAP
1S 2 36

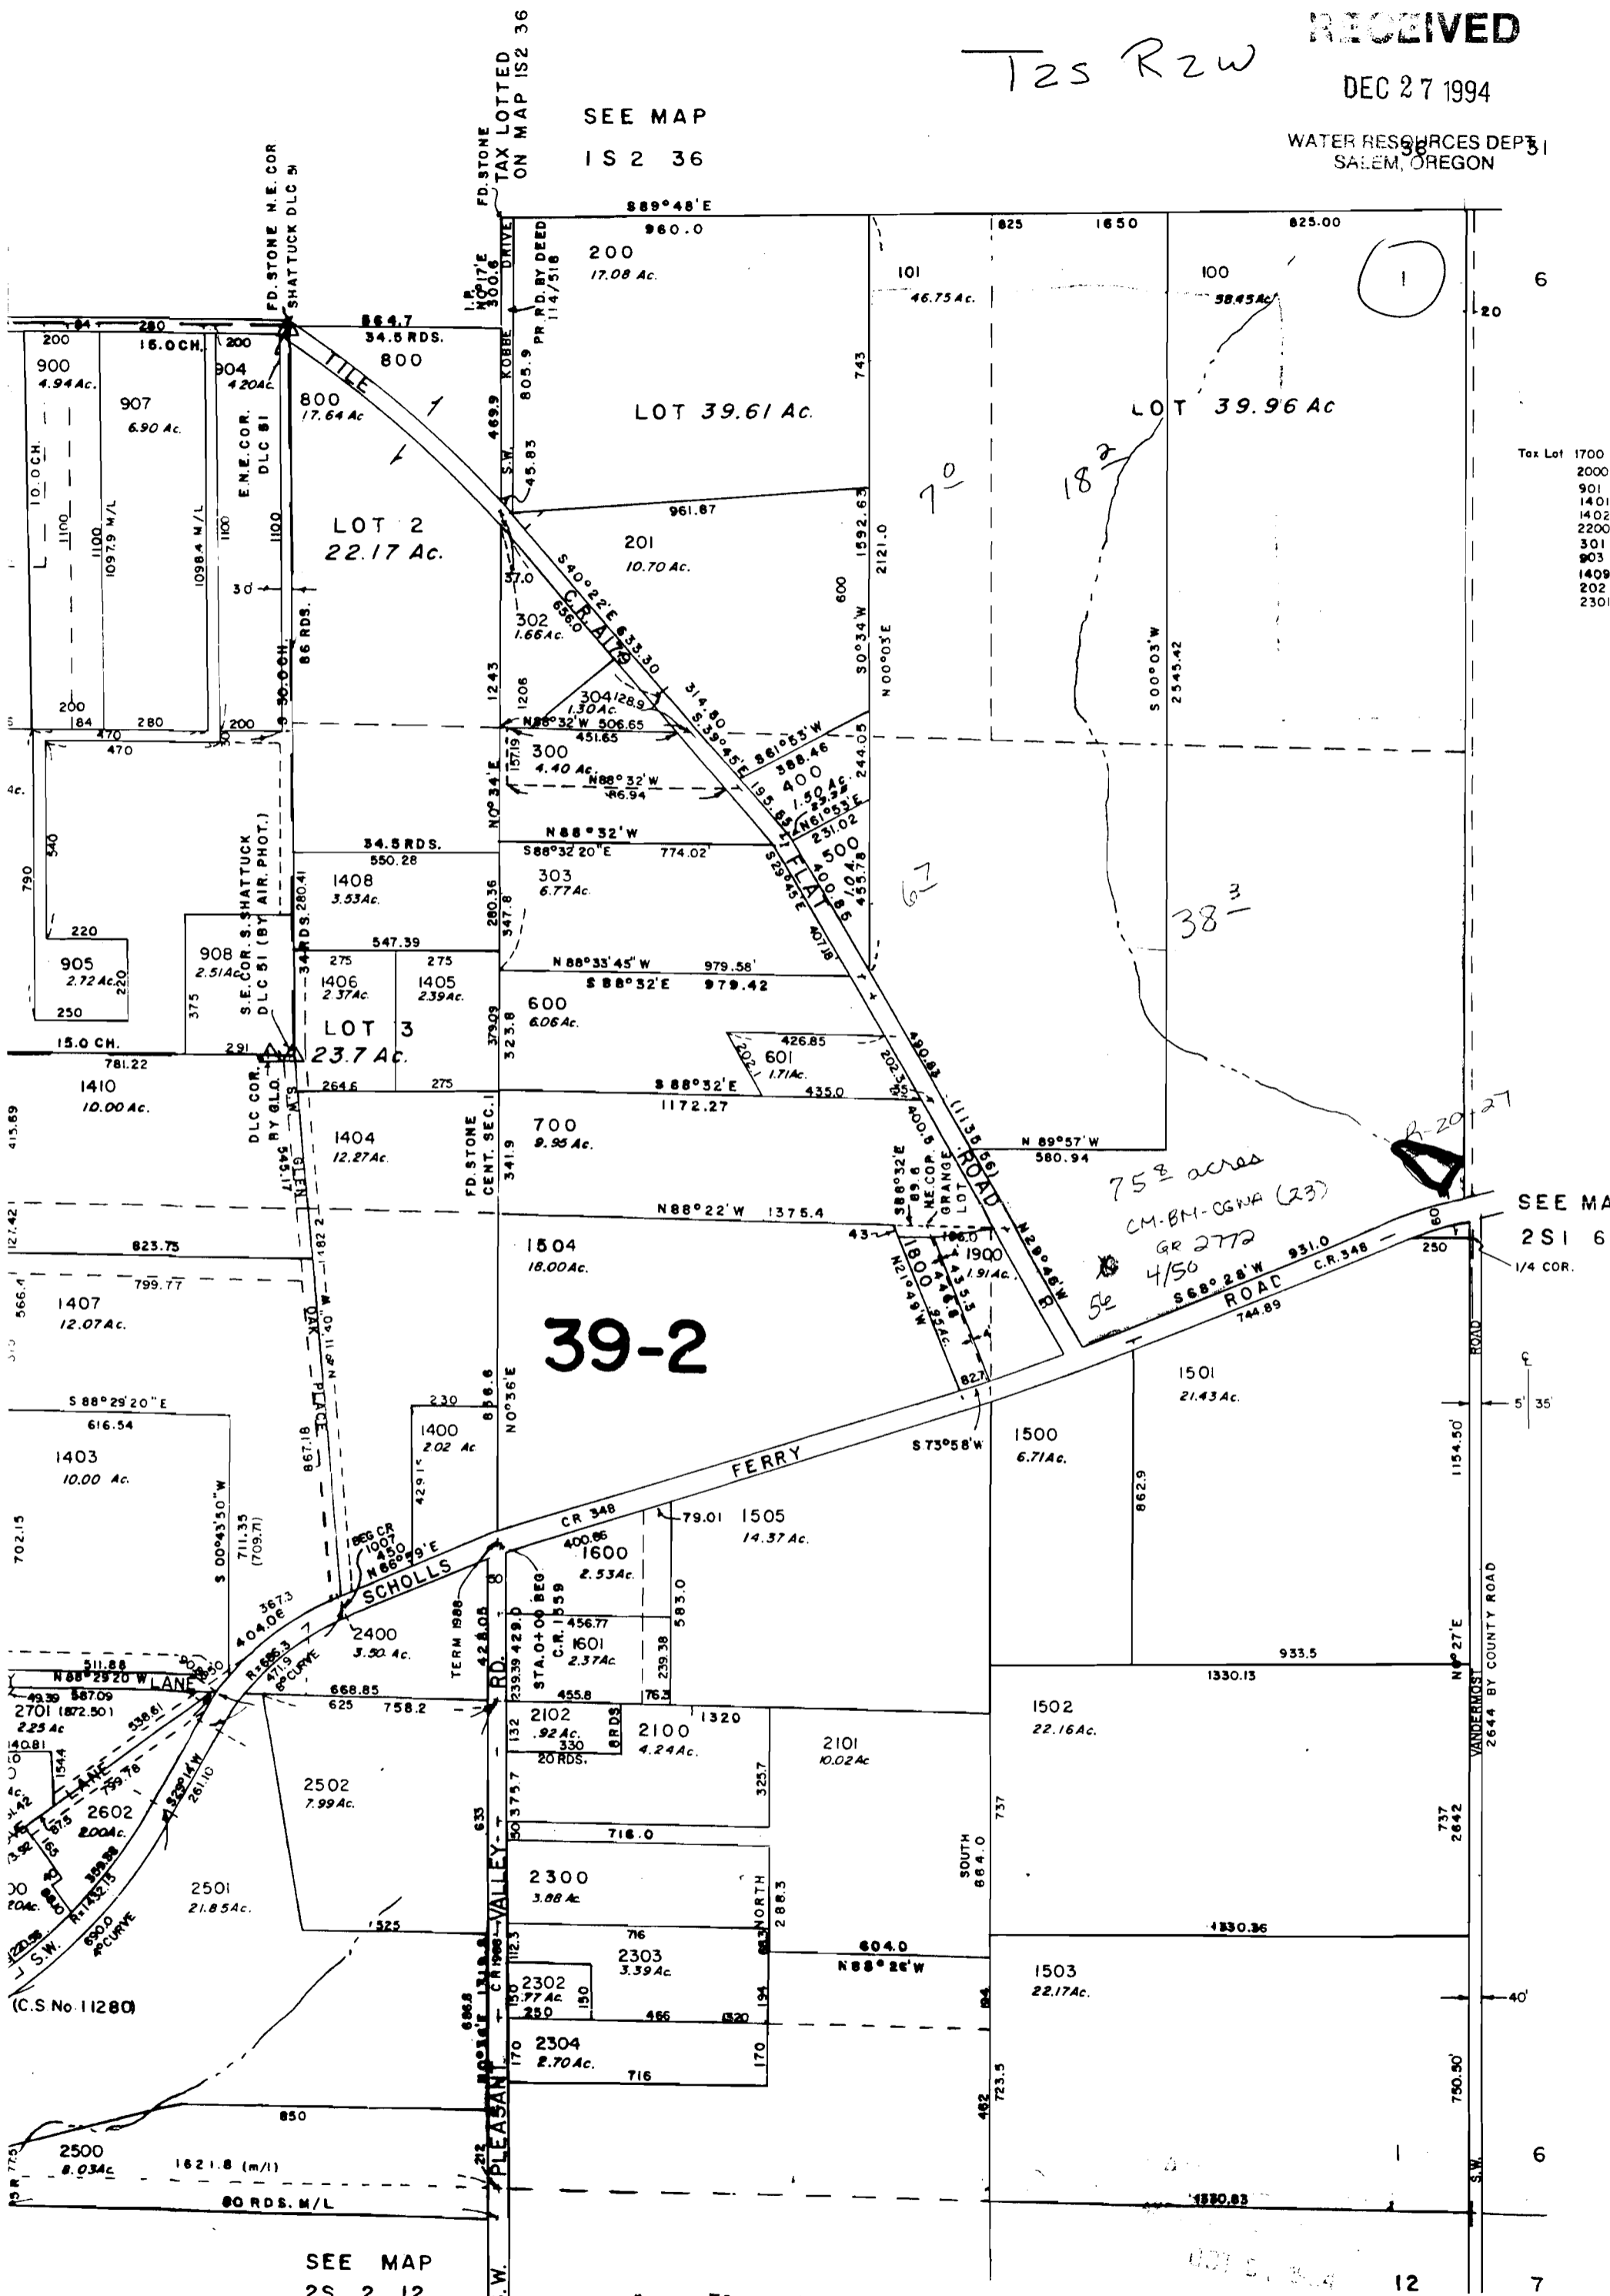

Tax Lot

1700
2000
901
1401
1402
2200
301
903
1409
202
2301

75[±] acres
CM-BM-OGWA (23)
GR 2772
4/50
S 68°28'W 931.0
C.R. 348
744.89

39-2

SEE MAP
2S 2 12

Application No. R-77448
Permit No.

CERTIFICATE NO. 71029

2S 2