

SCALE 1:9600



SEE MAP 3 SE 17


RECEIVED

DEC 27 1994

**WATER RESOURCES DEPT.
SALEM, OREGON**

Application No. R-77449
Permit No.

CERTIFICATE NO. 21040

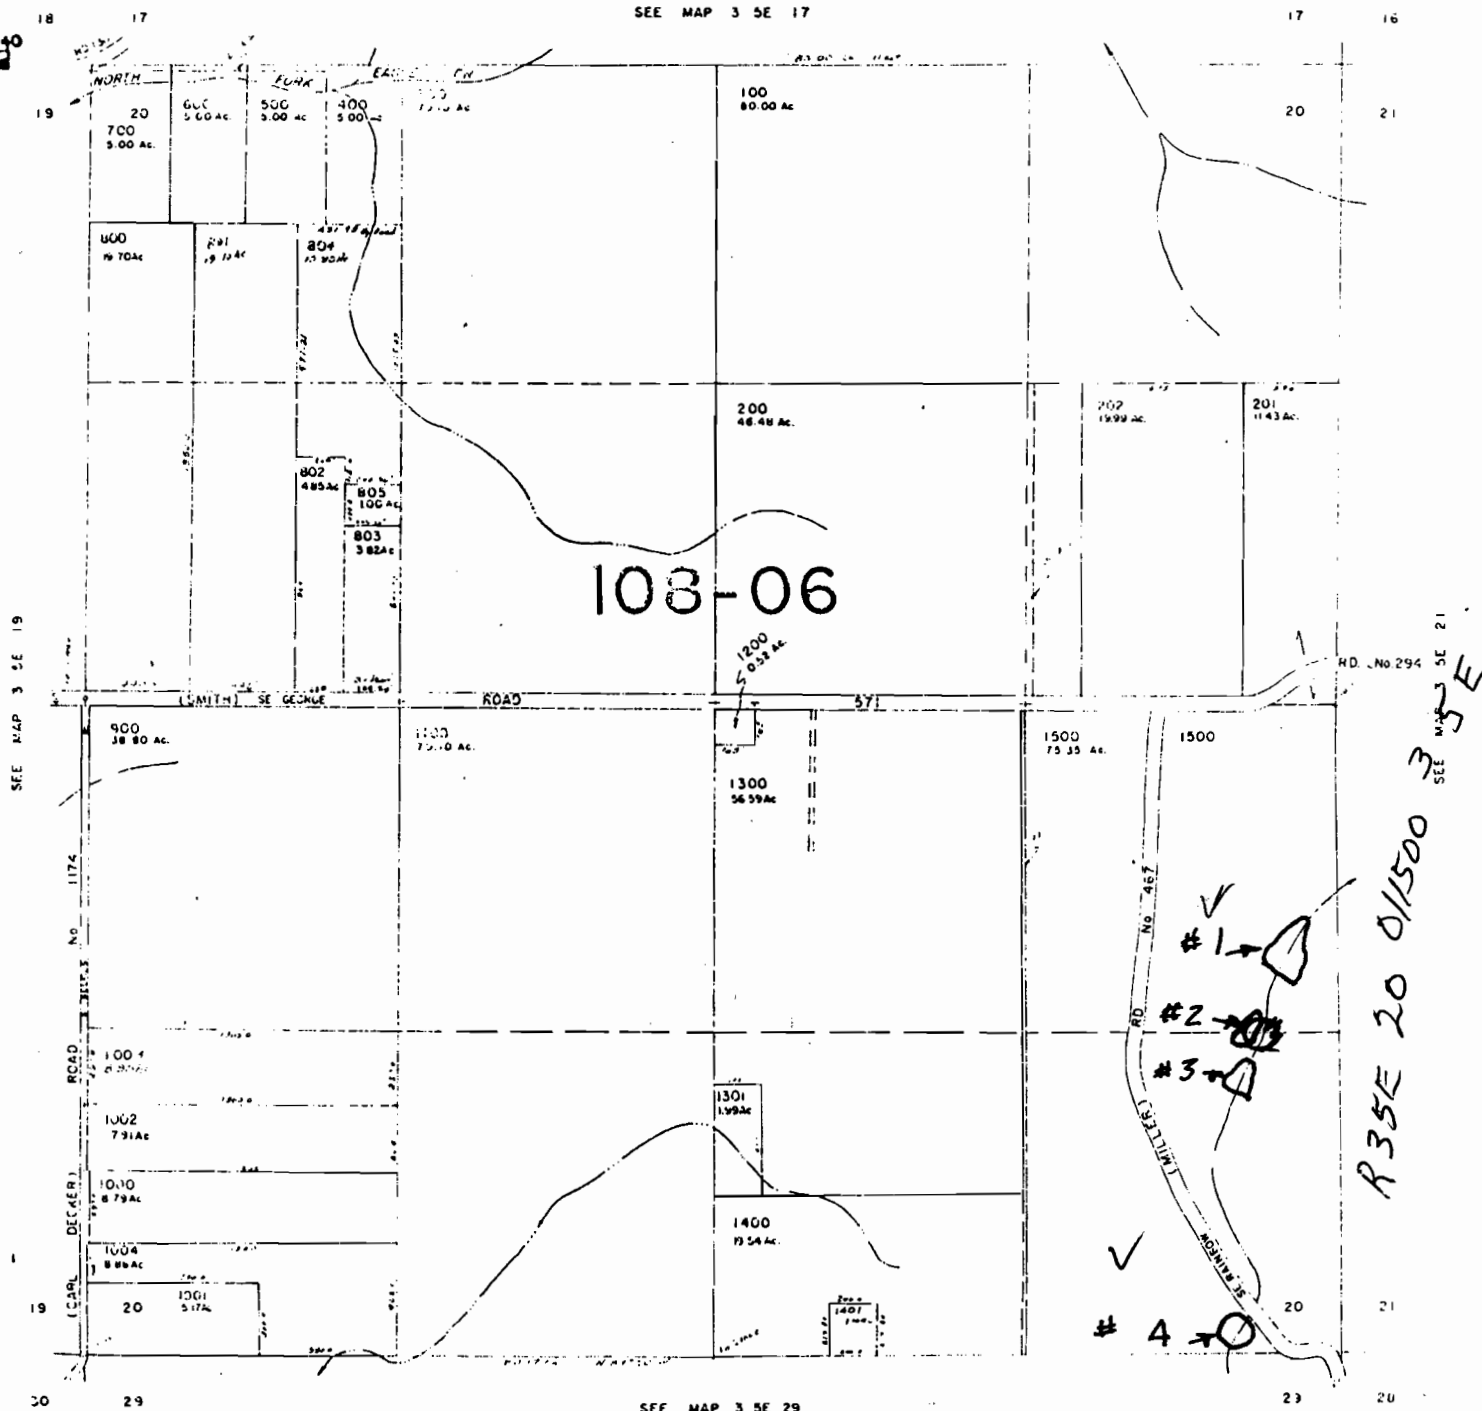

R35E 20 01/500

SEE MAP 3 5E 29

3 5F 20