


Application No. 23-74-53
Permit No. NO. 4

TRACT

"CERTIFICATE NO."

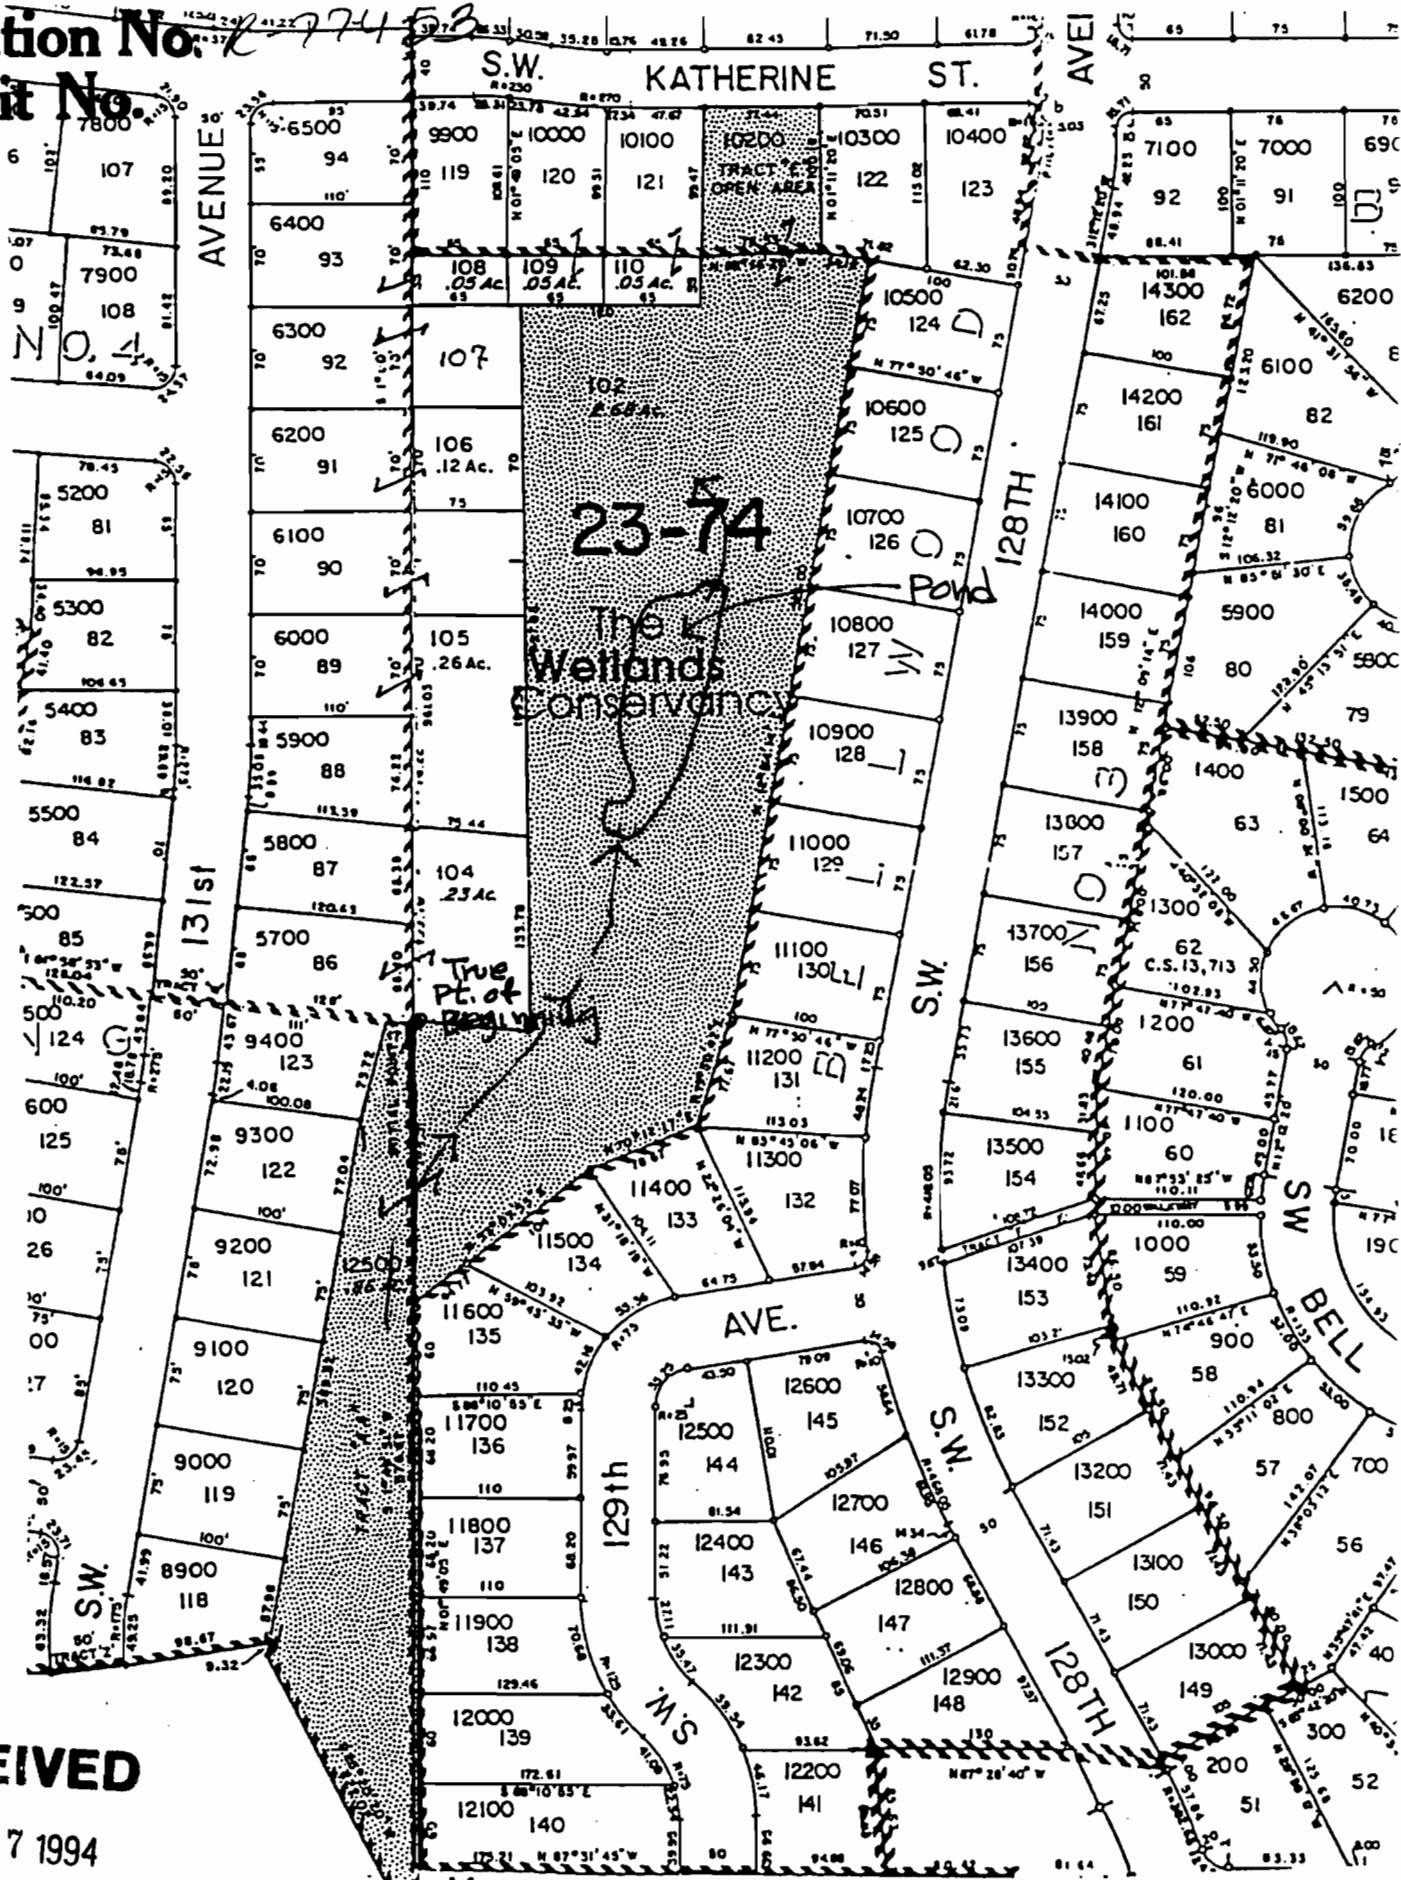

RECEIVED

DEC 27 1994

WATER RESOURCES DEPT.
SALEM, OREGON

Map 2S1-4AB Map 2S1-4AA

Figure 1. Adjacent tax lots (Washington County Tax Maps 2S1 4AA and 2S1 4AB), one inch = 150 feet, 1992.