

"CERTIFICATE NO

71053

Application No

R-77462

RECEIVED

Permit No.

DEC 27 1994

WATER RESOURCES DEPT. SALEM, OREGON

SEE MAP B 2W 20A


1/4 COR

1366000

445000

SEE MAP B 2W 21A

20 21

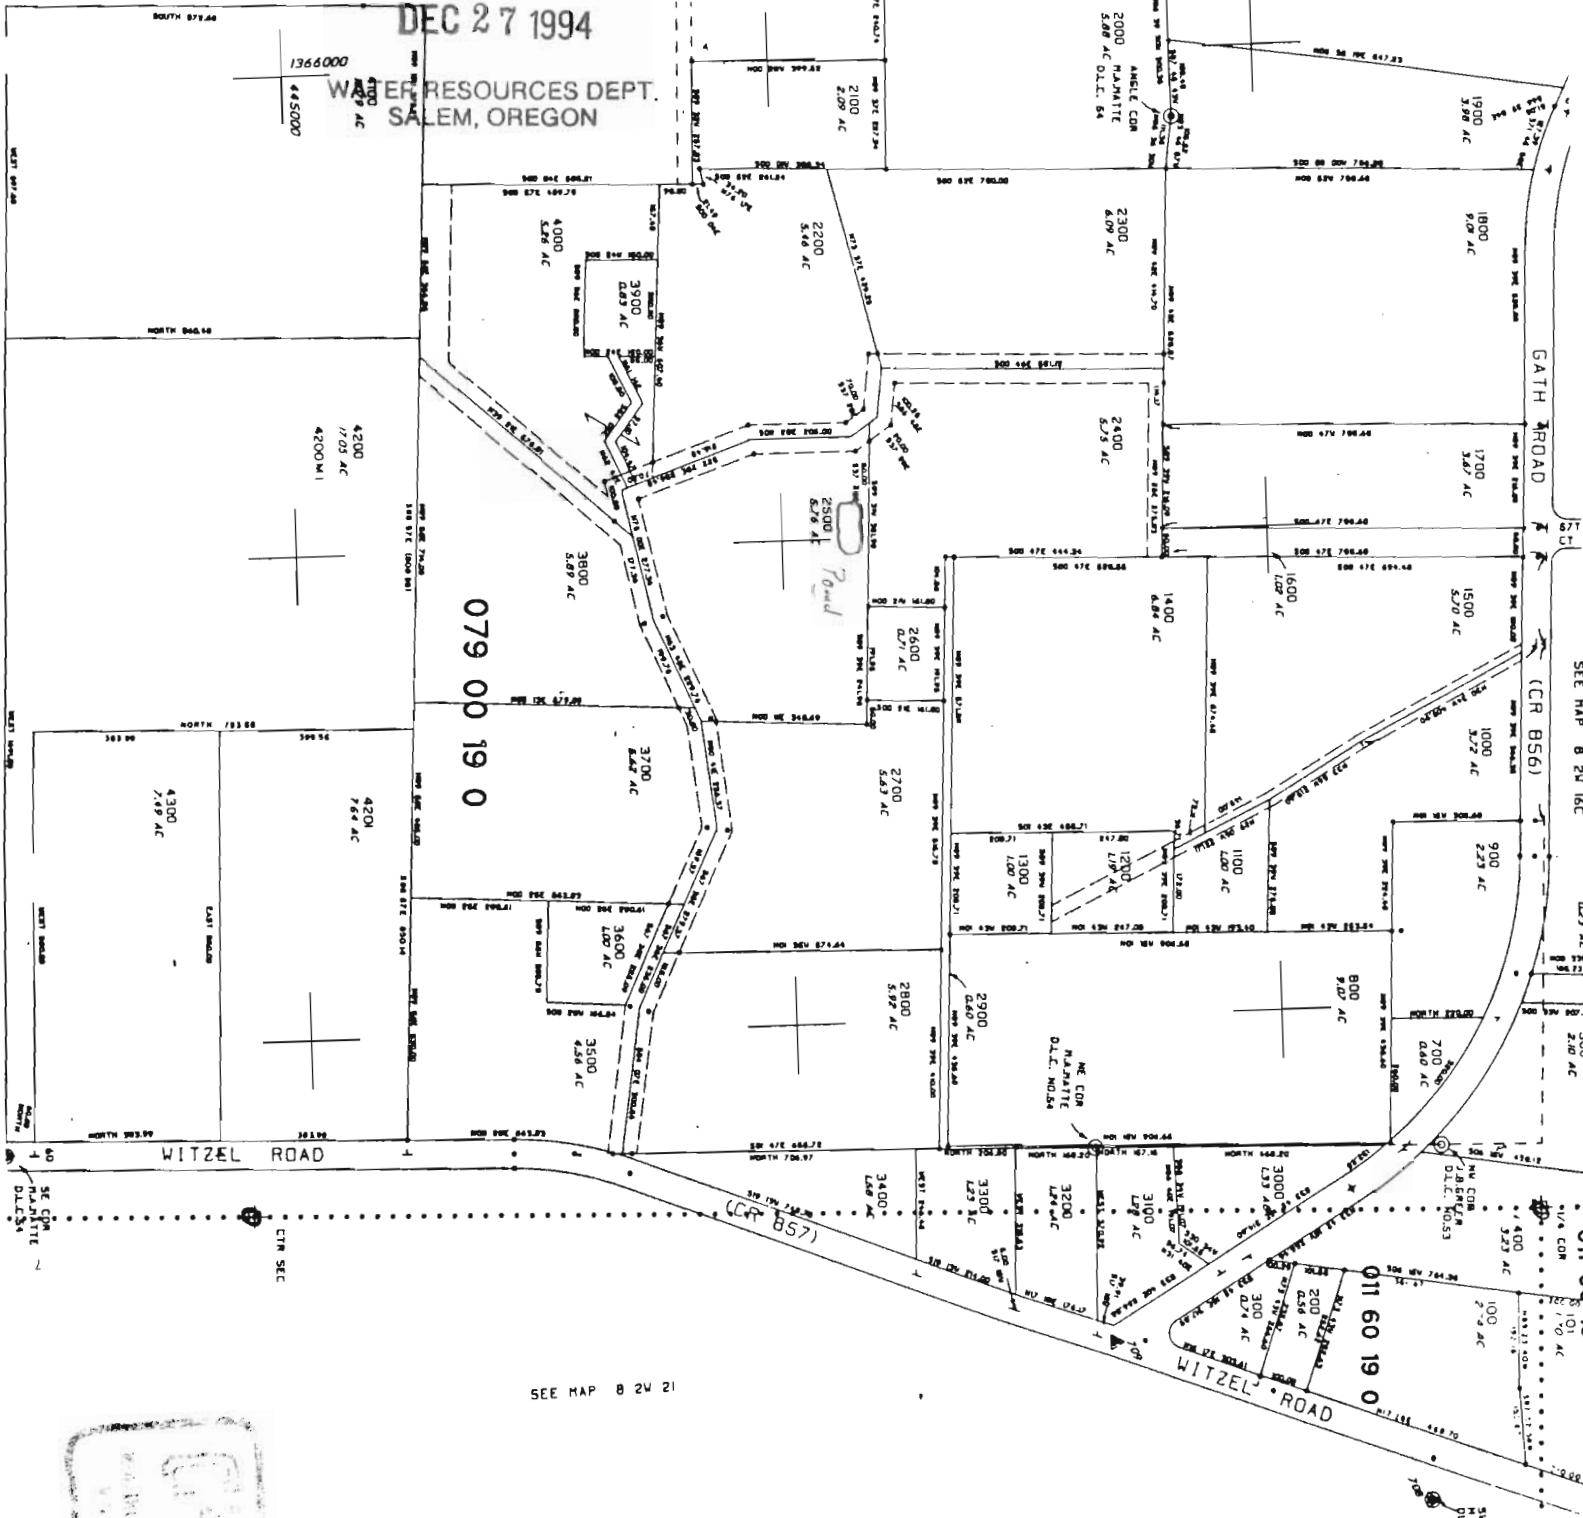


079 00 19 0


SEE MAP B 2W 16C

011 60 19 0

SEE MAP B 2W 21

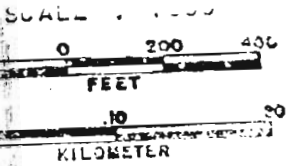

1"=200'  
02-JUL-82

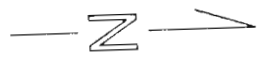

B 2W 21B

W. PERSON  
B 2W 21B