

USDA ASCS Photo - 1989 - Kwikah USDA WRCI 12/2/94

RECEIVED

I7L 1A

DEC 27 1994

SOURCES DEPT
OREGON


No R-77464

Section 51
Township 8s
Range 6W

2
4

71057

71057

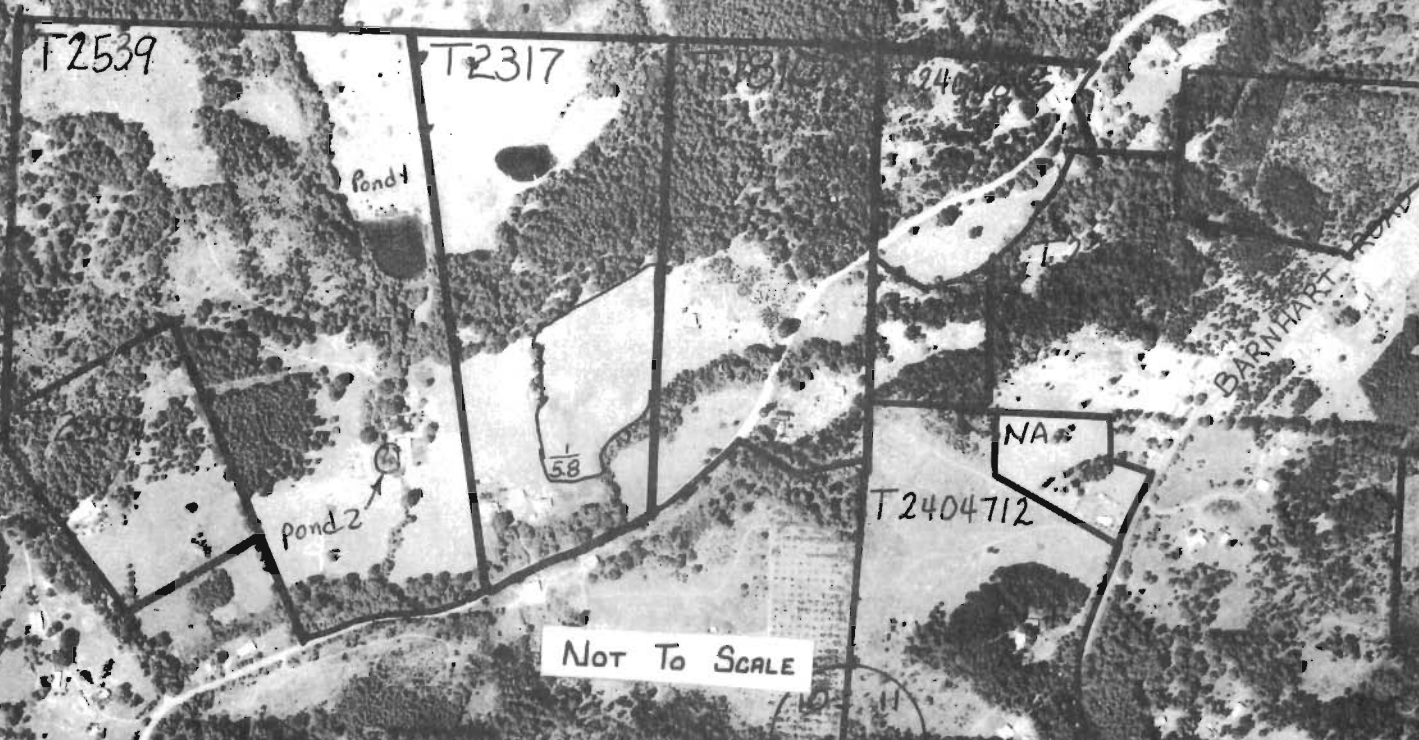

NOT TO SCALE