

EARL D JONES
D. L. C. No. 50

"CERTIFICATE NO. 71058"

RECEIVED

DEC 27 1994

WATER RESOURCES DEPT.
SALEM, OREGON

TAX LOT
47247-000

2613-3630

399.73'

47261-000

308°00'W 336.3'

2312-3700

372°11'E 323.56'

517°45'W 200'

512°11'E 200'

148.80'

148.80'

Subject Property

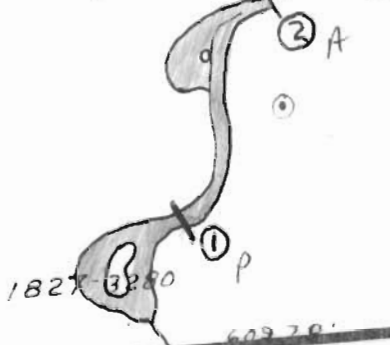

No. 602
S 85° 45' W 173 CH. (858)

589° W 577 CA (380.82)
SEE SURVEY
432 P 116 CSR

N. 85° W. 1553 CA. (102)

MARKET ROAD
12.80 CA. (851.40)

1047-3573

(869.22')

JONES



Plat Map