


SE 1/4 Section 27 T3N R10E W. M.
Hood River County

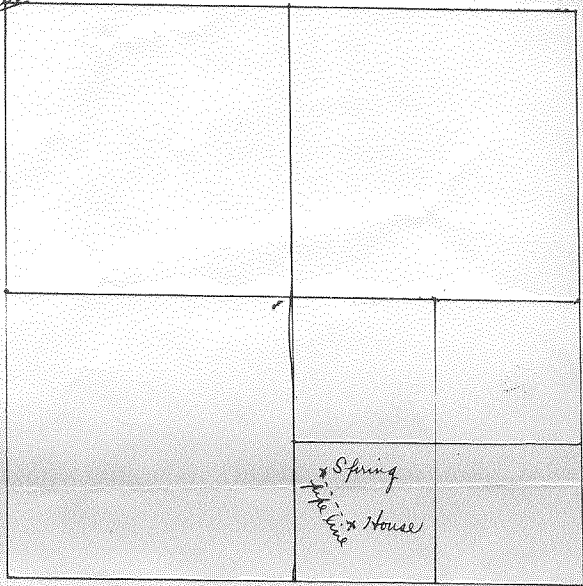

Section 27
Center



STATE ENGINEER
REGISTERED

OFFICE OF THE STATE ENGINEER

