

SEC.30 TWP.9S. RGE.3E. WM
MARION COUNTY, OREGON

9 3E 30
& INDEX

71006
Application No R-77834
Permit No.

LEGEND

LINE TYPES

- TAX LOT BOUNDARIES
- OLD PROPERTY LINES
- RIVERS, LAKES, ETC.
- CREEKS, POND, ETC.
- RAILROADS
- TAX CODE BOUNDARIES
- SUBDIVISION BOUNDARIES

SYMBOL TYPES


- CONTROL POINTS
- SURVEY MONUMENTS
- G.L.O. CORNERS (APPROX) (FOUND)
- SECTION
- 1/4 SEC
- 1/16 SEC
- D.L.C.

OREGON STATE PLANE
COORDINATE SYSTEM
GRID MARKS - NAD 27

NUMBERS
TAX CODE NO.
000 00 00 0


ACREAGE - ALL ACREAGES EXCLUDE
ANY PORTION THAT MAY LIE
WITHIN THE INDICATED PUBLIC
RIGHT OF WAYS.

TICK MARKS - WHEN A TICK MARK IS
INDICATED ON THE EXTENSION OF
A LINE, THEN THE DIMENSION GOES
TO THE TICK MARK. GENERALLY THIS
IS USED WHEN DIMENSIONS GO INTO
PUBLIC RIGHT OF WAYS.

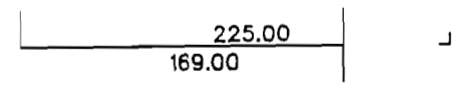


ARROWS ARE USED WITH DIMENSIONS
IN AREAS OF GREATER COMPLEXITY.

WARNING: This map was created by digitizing assorted existing maps. NO Research was done. Created for Assessor's Office use ONLY.

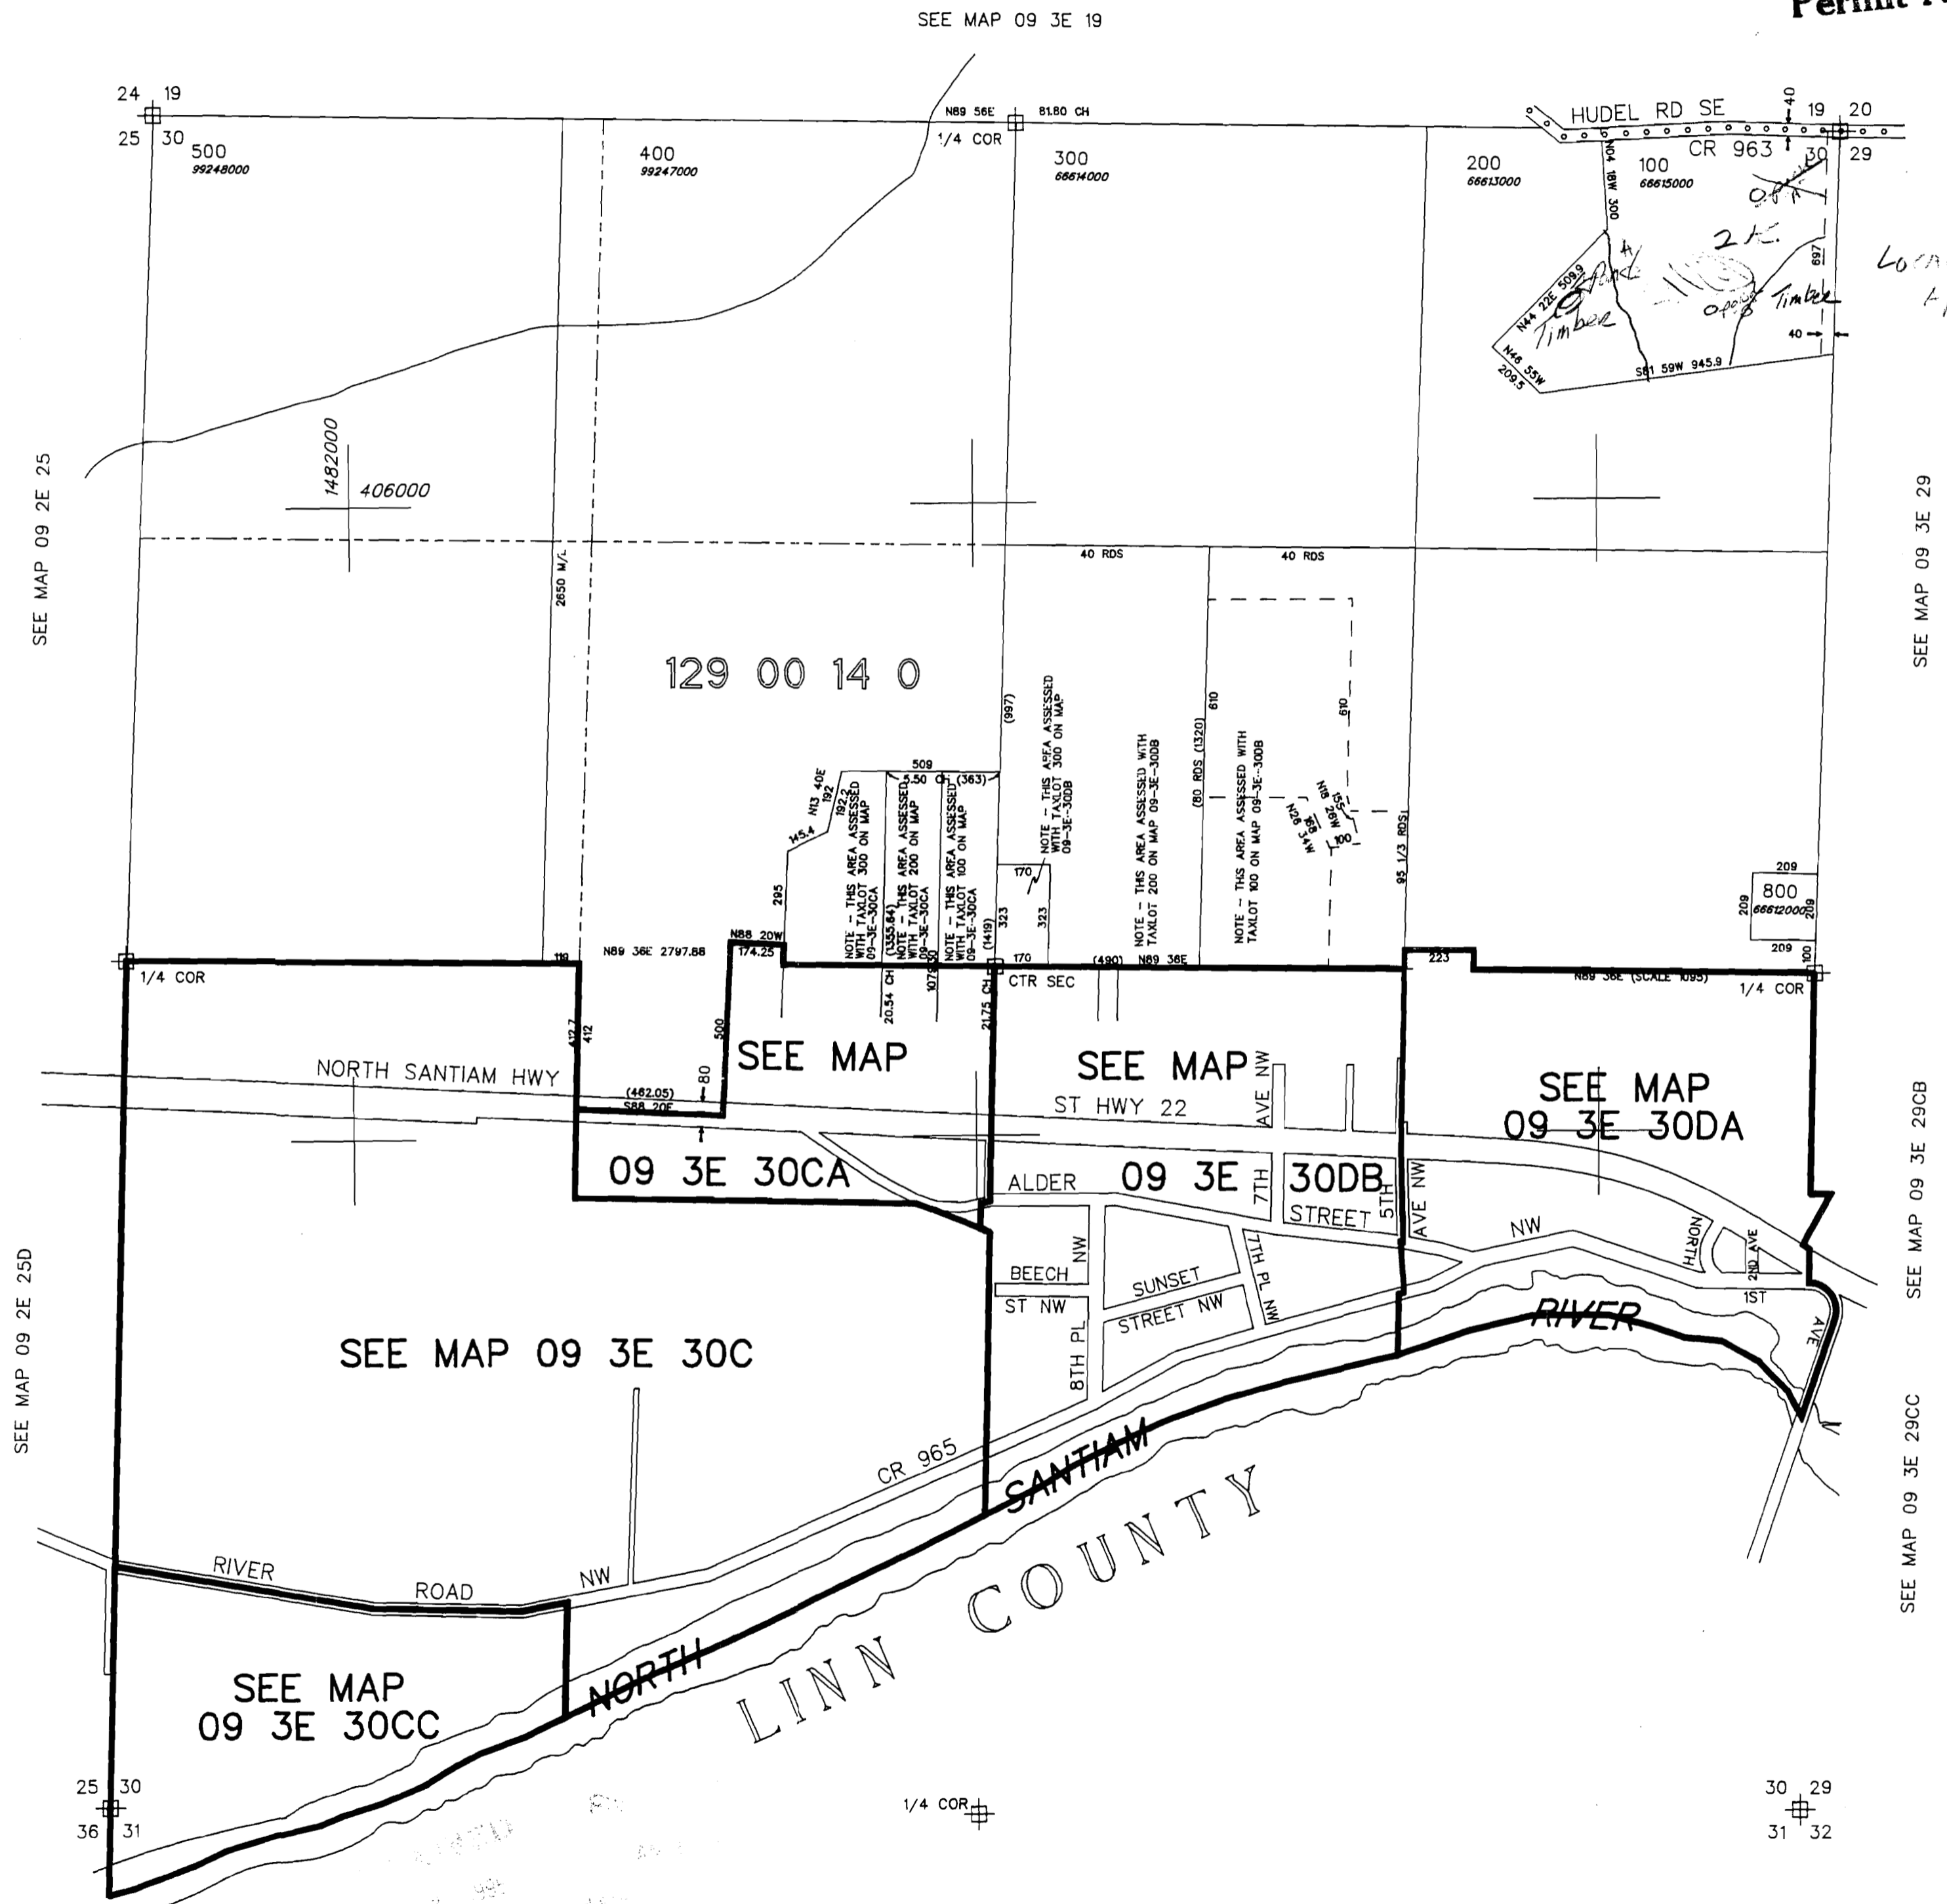

Location
App

JAN 5 1992

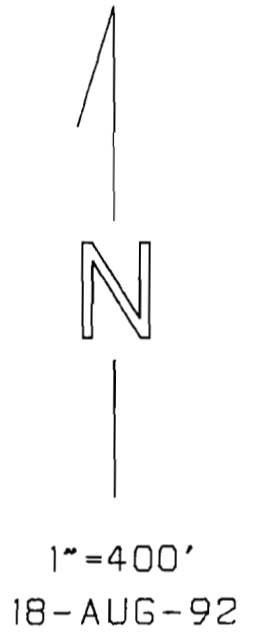

SEE MAP 09 2E 25

SEE MAP 09 2E 25D

SEE MAP 09 3E 29

SEE MAP 09 3E 29CB

SEE MAP 09 3E 29CC