


JAN 4 1935
 WATER RIGHTS
 SALE

T.6S. R.23E.
 GILLIAM CO.
 1" = 2000'
 SEE MAP 5S 23

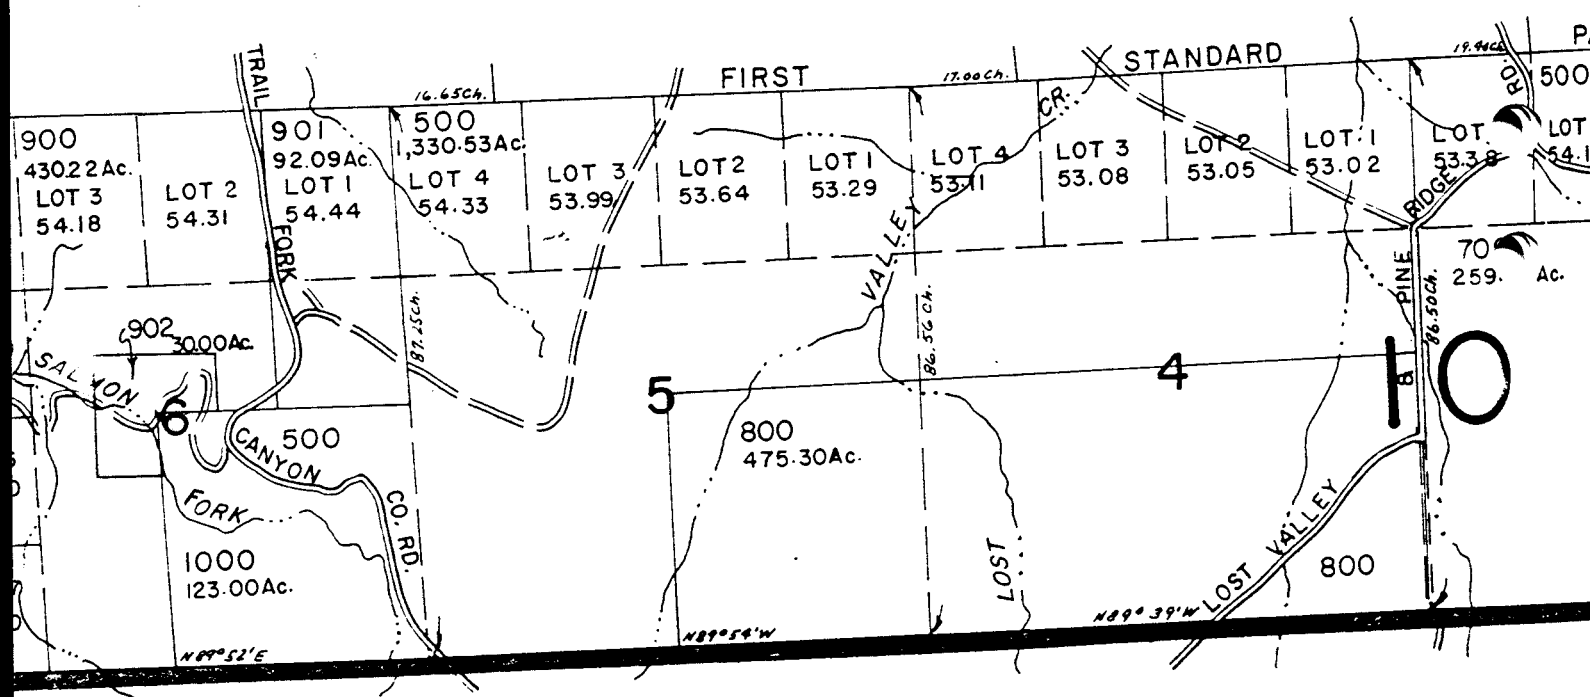

Application No. R-77843
 Permit No.


WHEELER

71103

6S 23

3E. W.M.
COUNTY

00'
S 23

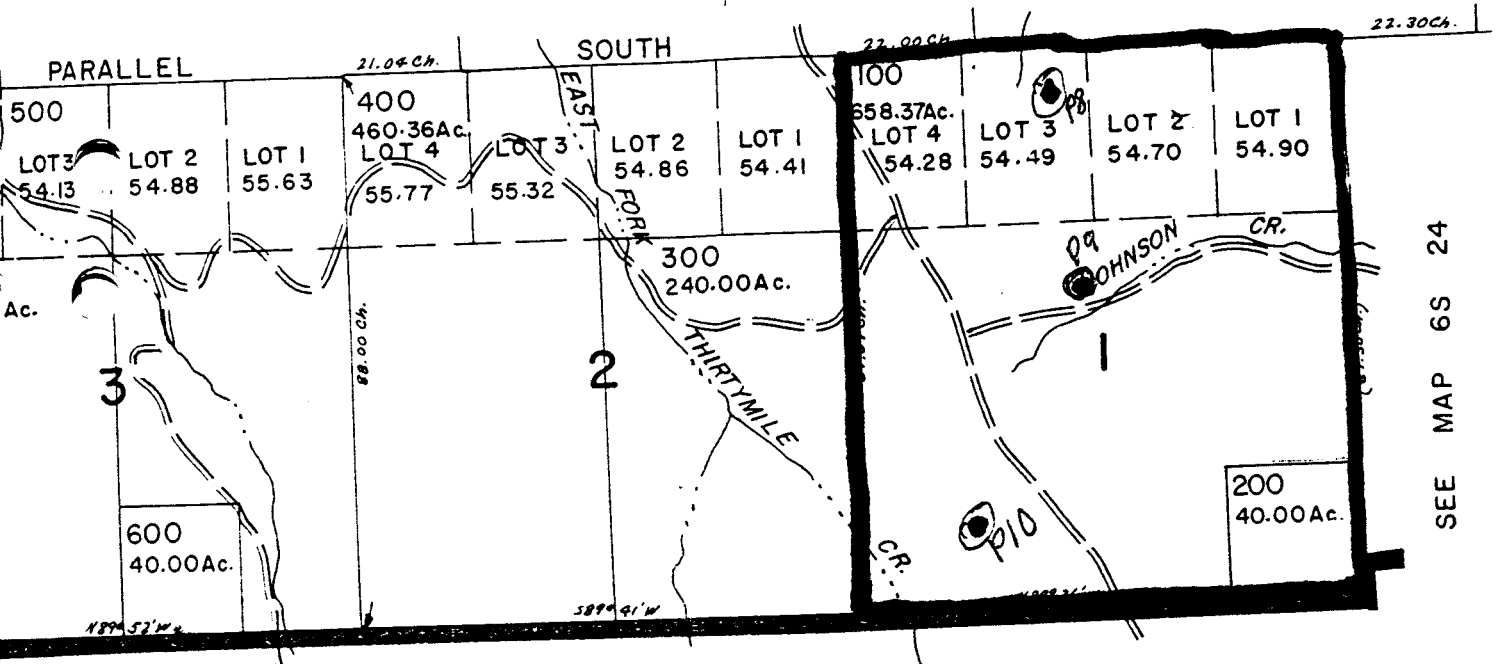

COUNTY


1 copy

Application No. R-77843
Permit No.

T.5S. R.23E
GILLIAM C
1" = 2000'

71103

SEE MAP 4S 23

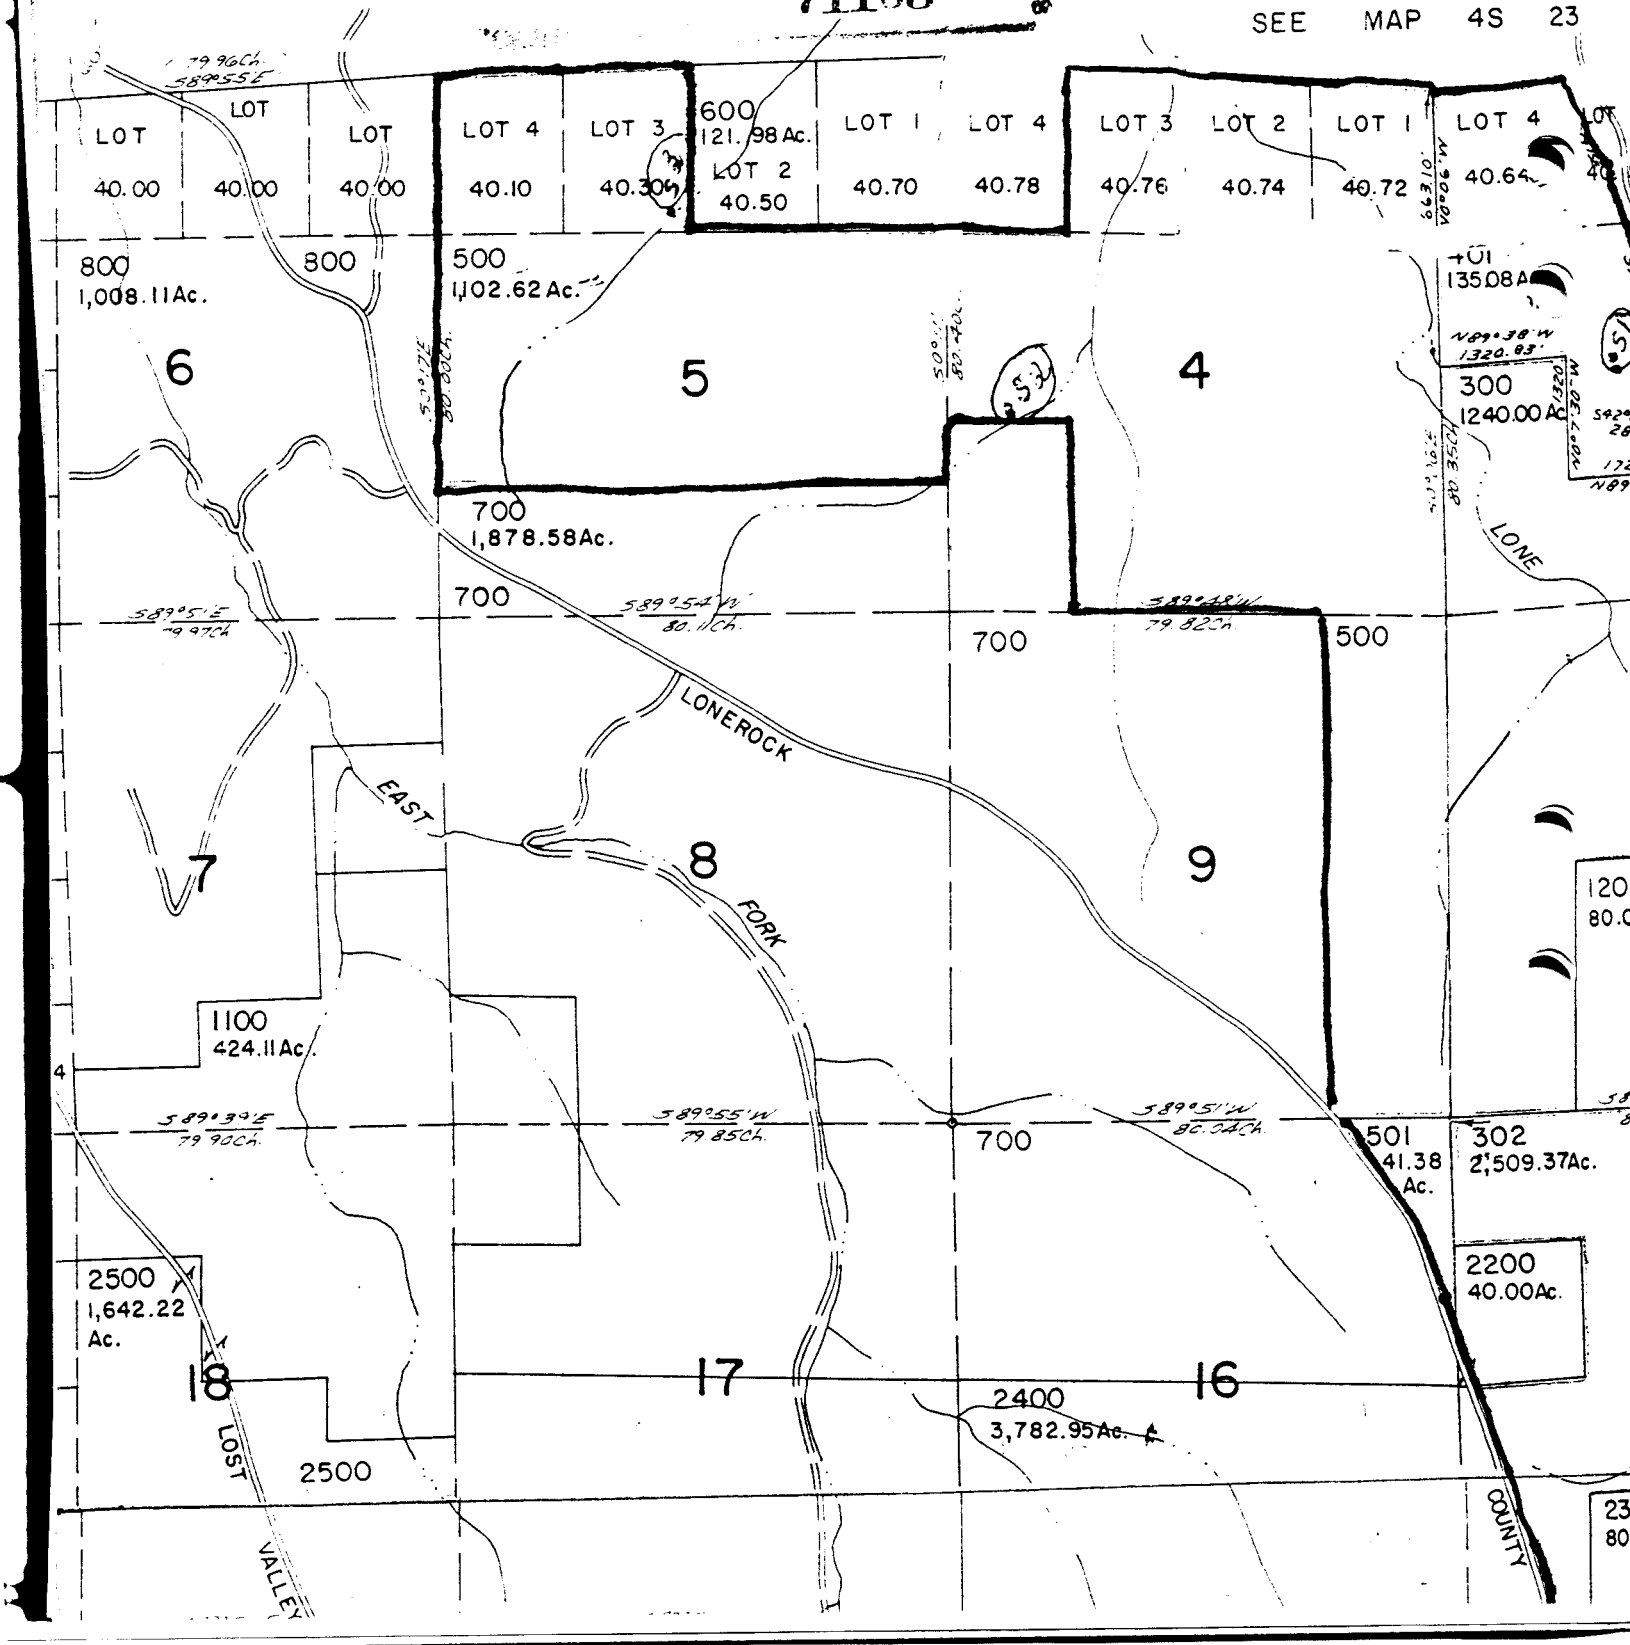


3E. W.M.
COUNTY

5S 23
LONEROCK


- Campbell, Margaret Alma as per deed m65-372
- Campbell, Peter C. as per deed m65-373
- Campbell, Peter + Margaret
- Campbell, Margaret ALMAN-4 1995
- Campbell, Peter C.


WATER RESOURCES
SALEM, OREGON

CANCELLED
NUMBERS
600U1
600U2

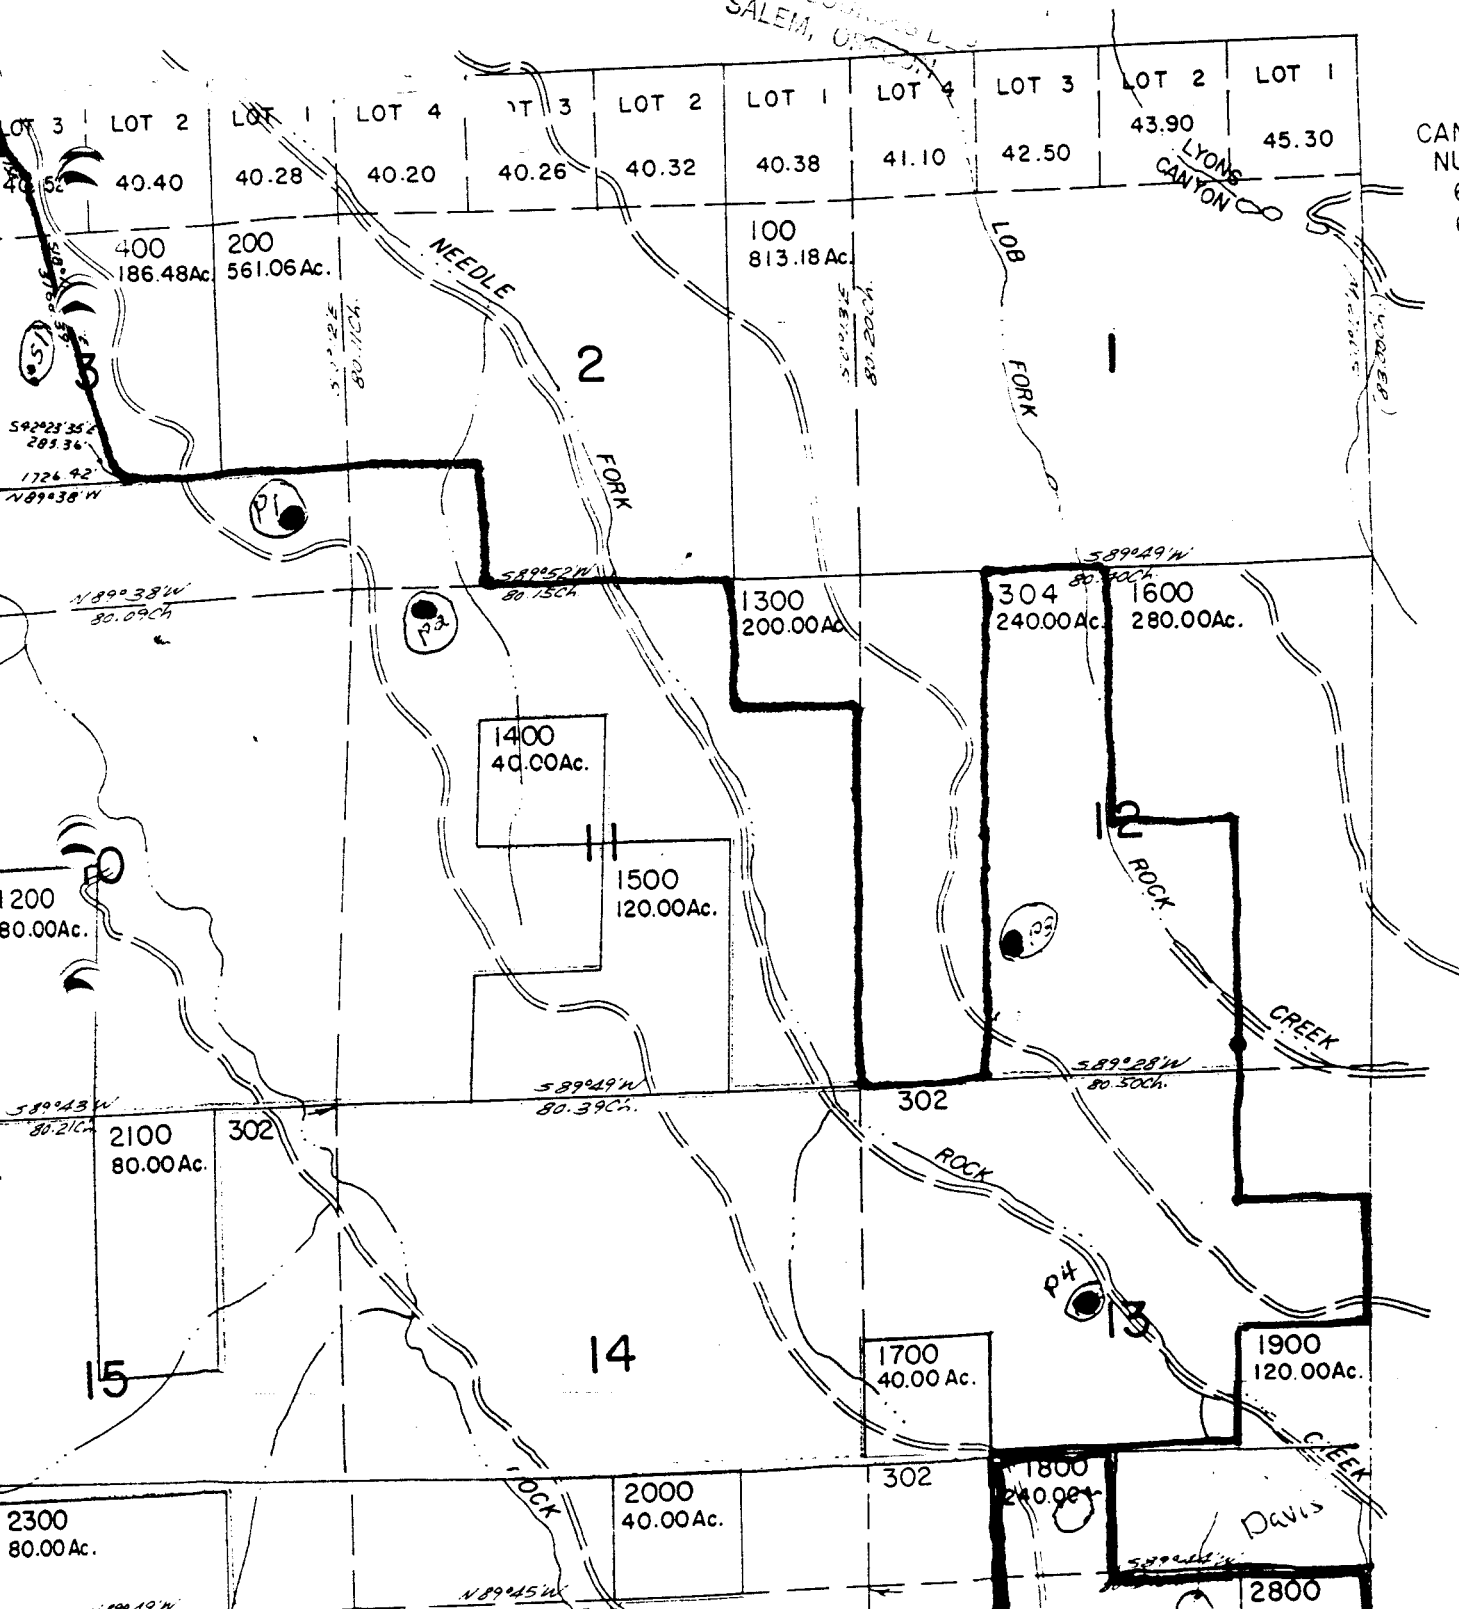

12 5S 21

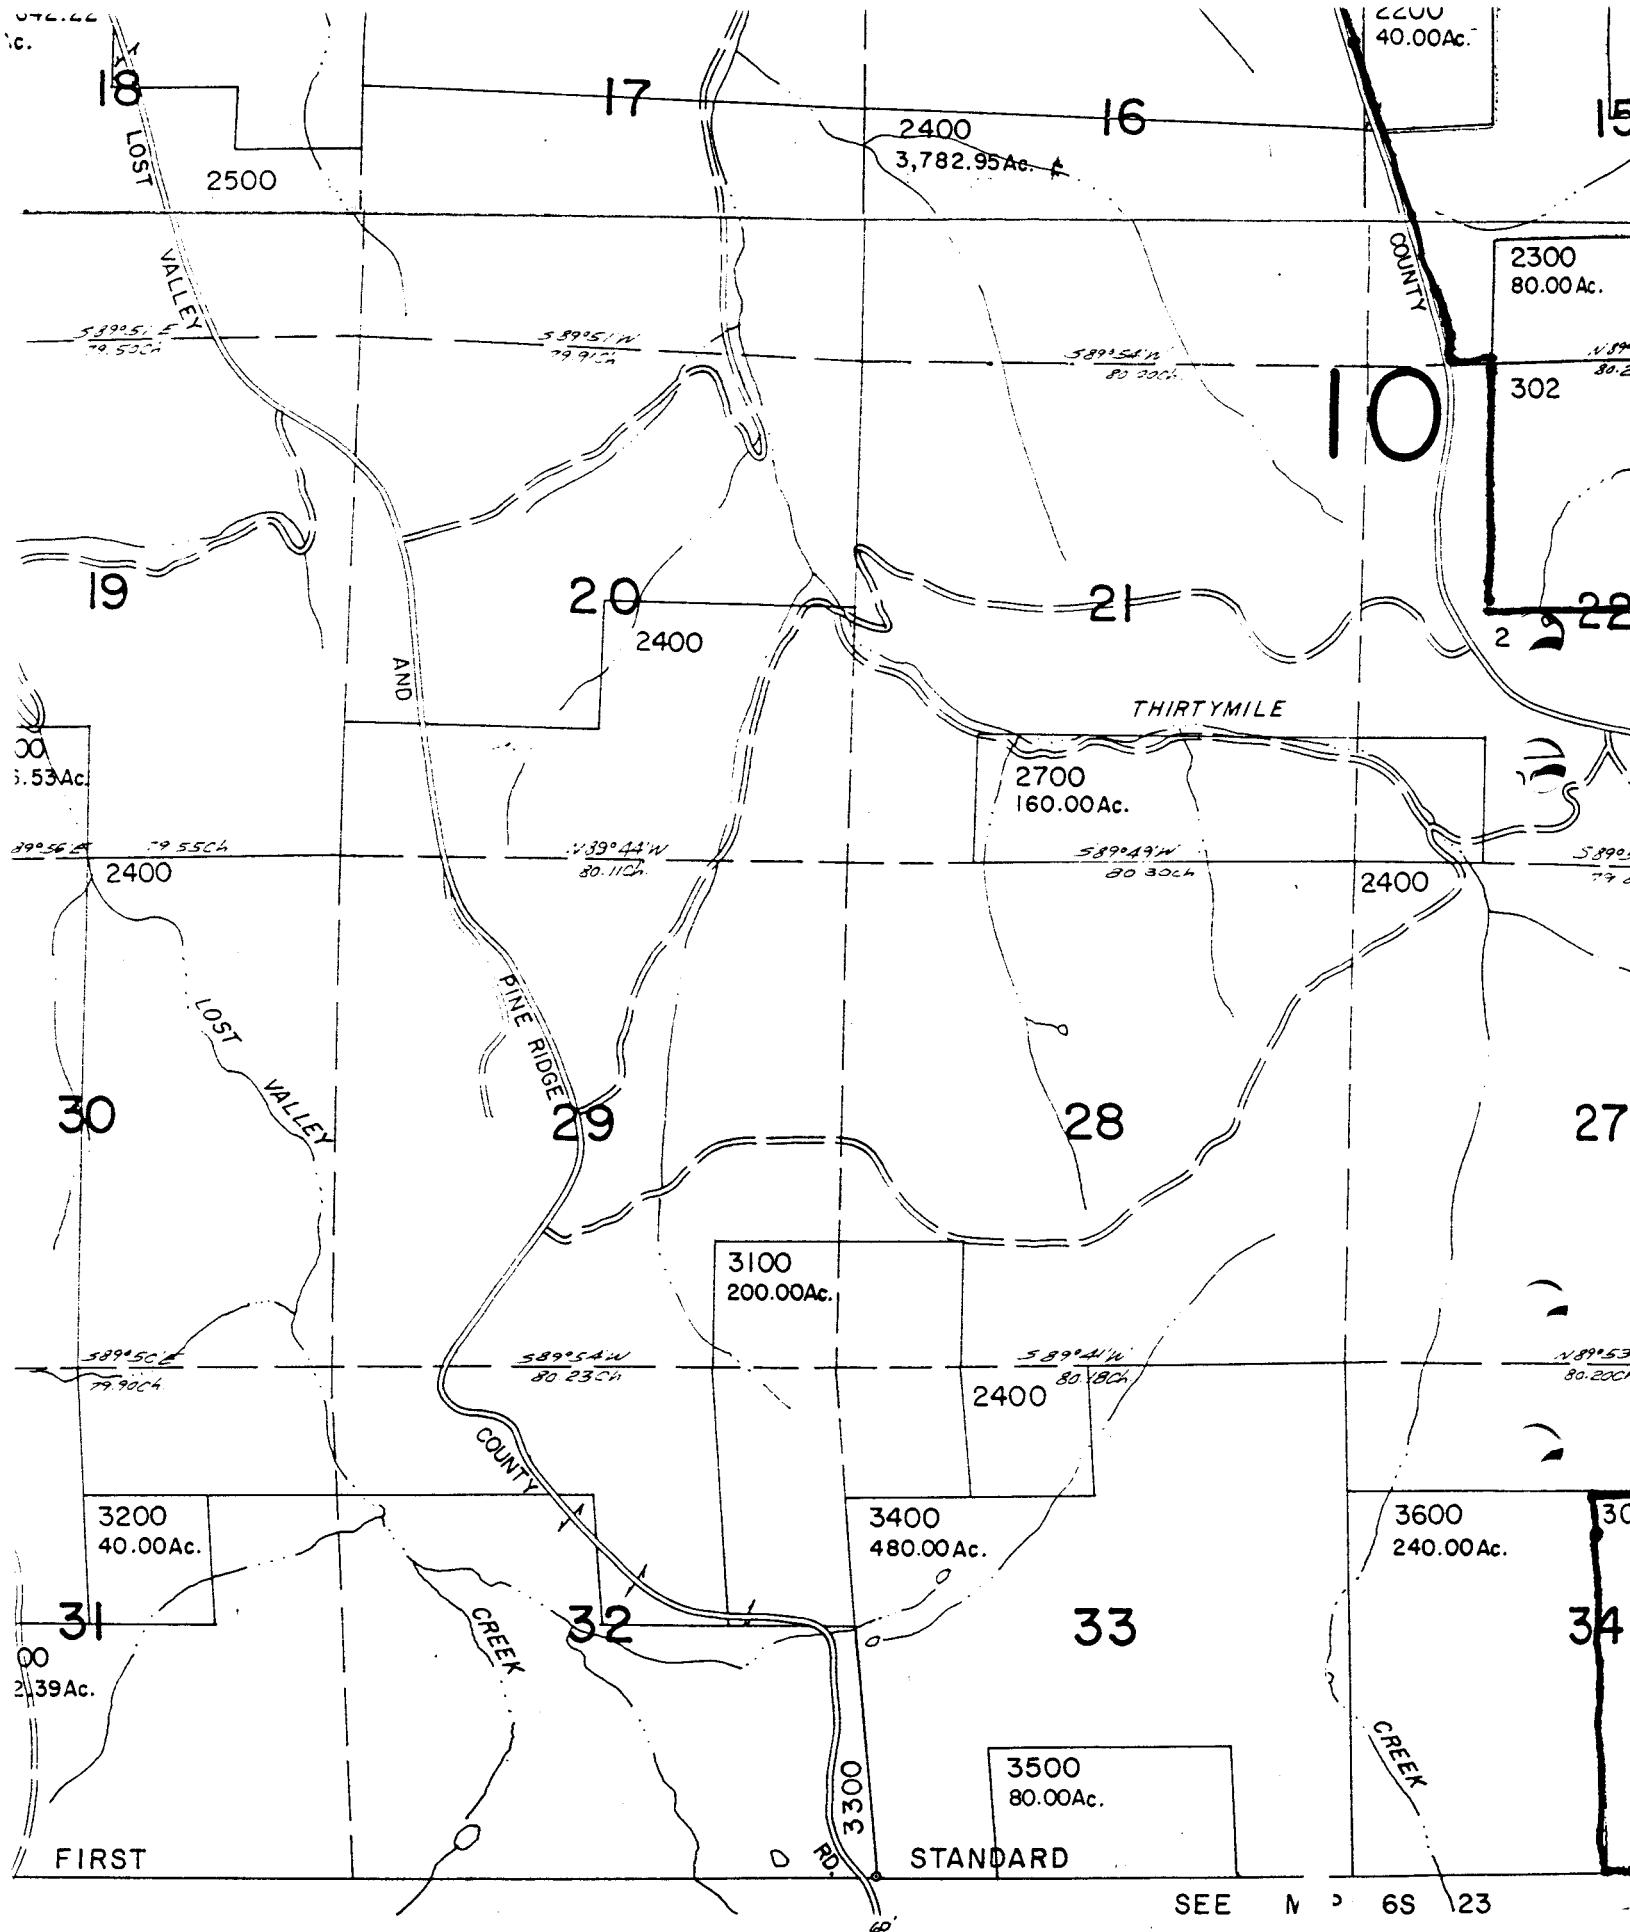

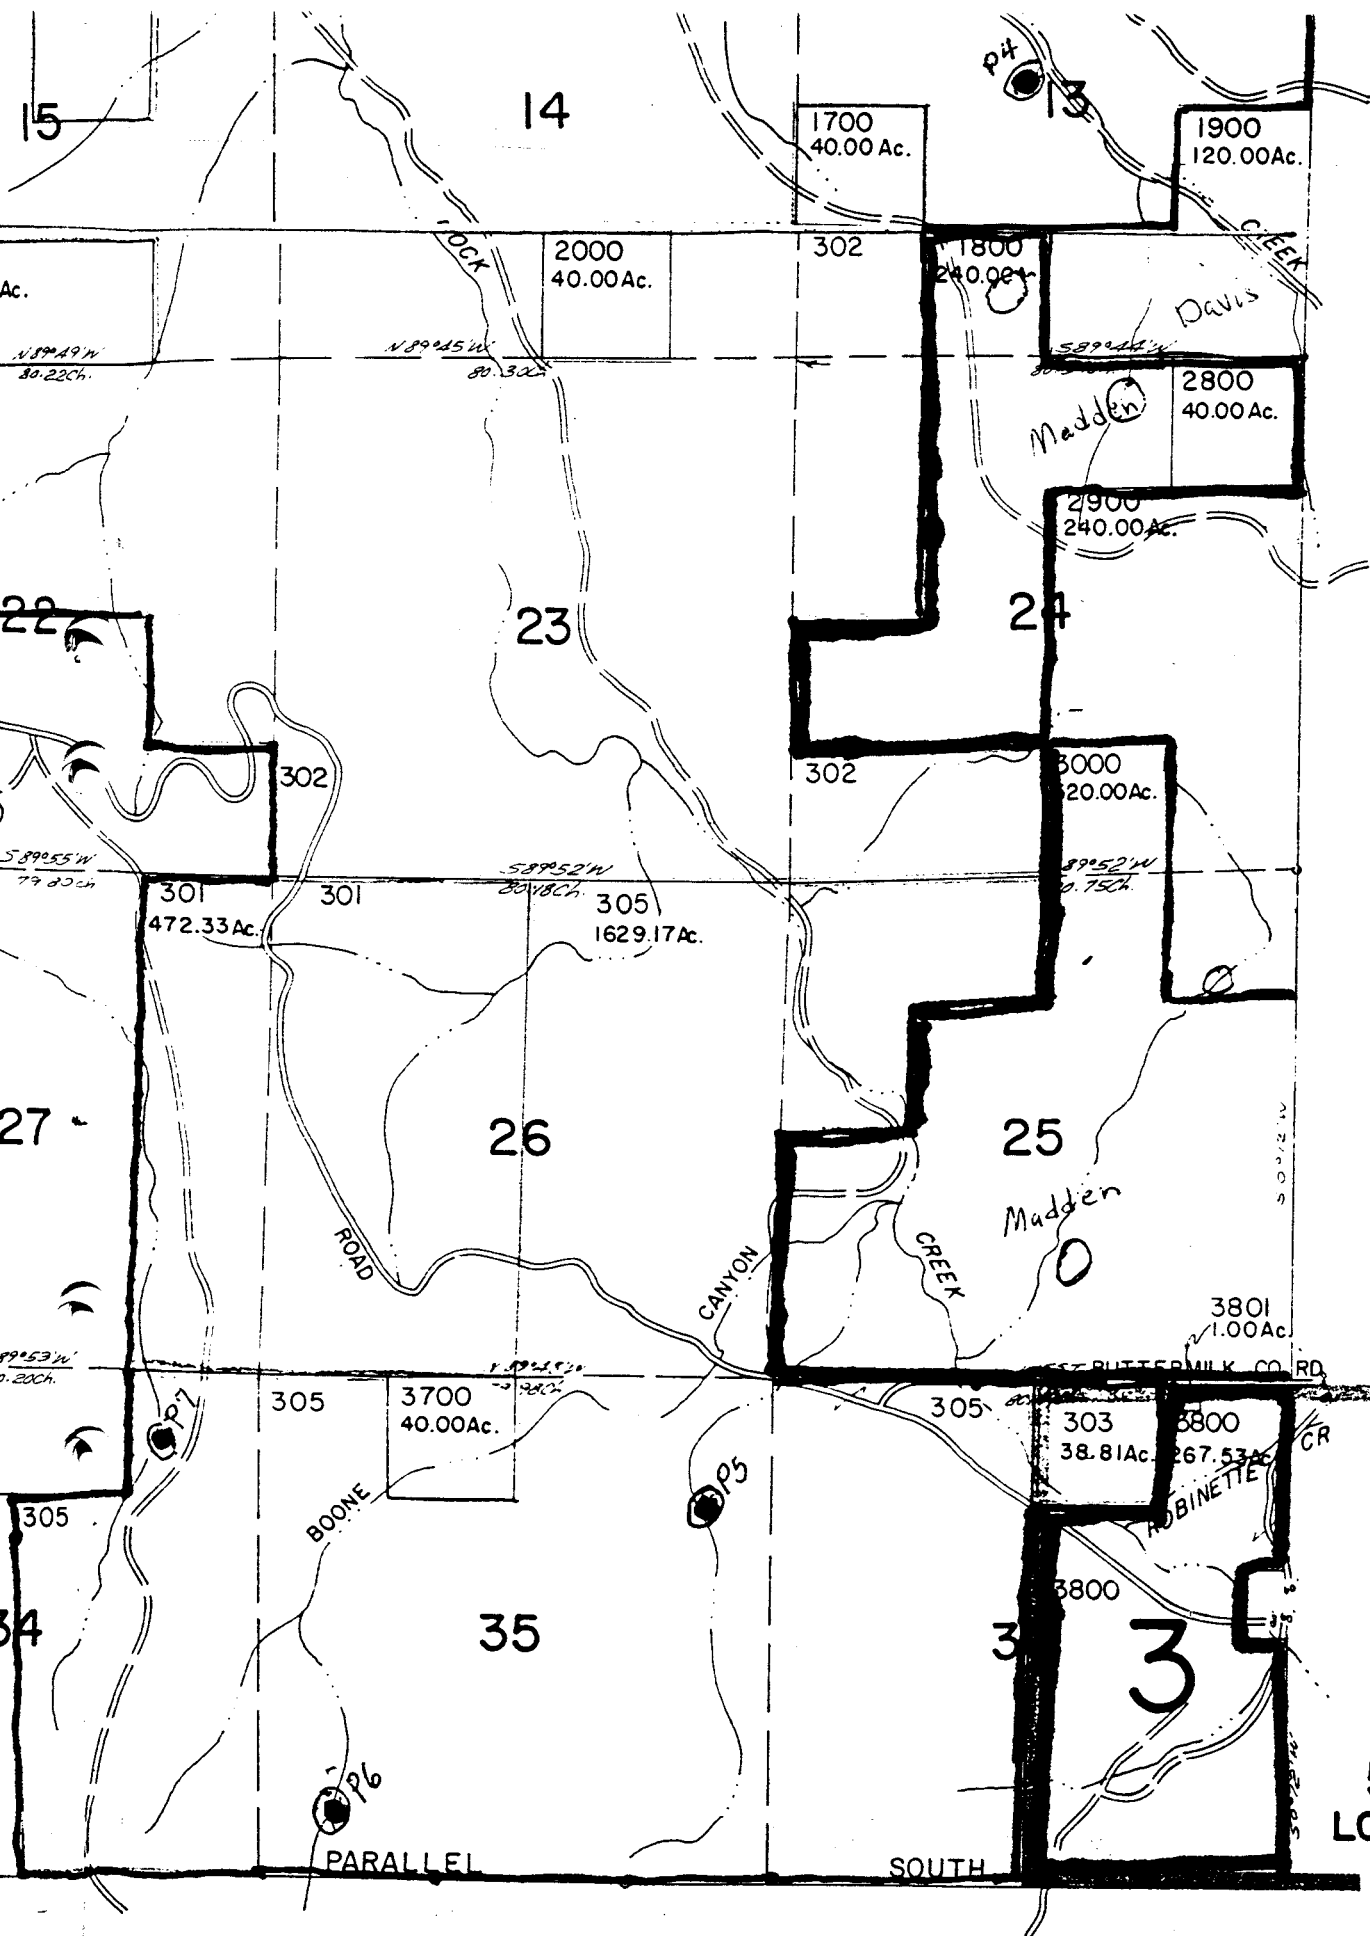

5S 23
LONEROCK