


T5S-R23E

5S 27
LONE F


SEE MAP 55

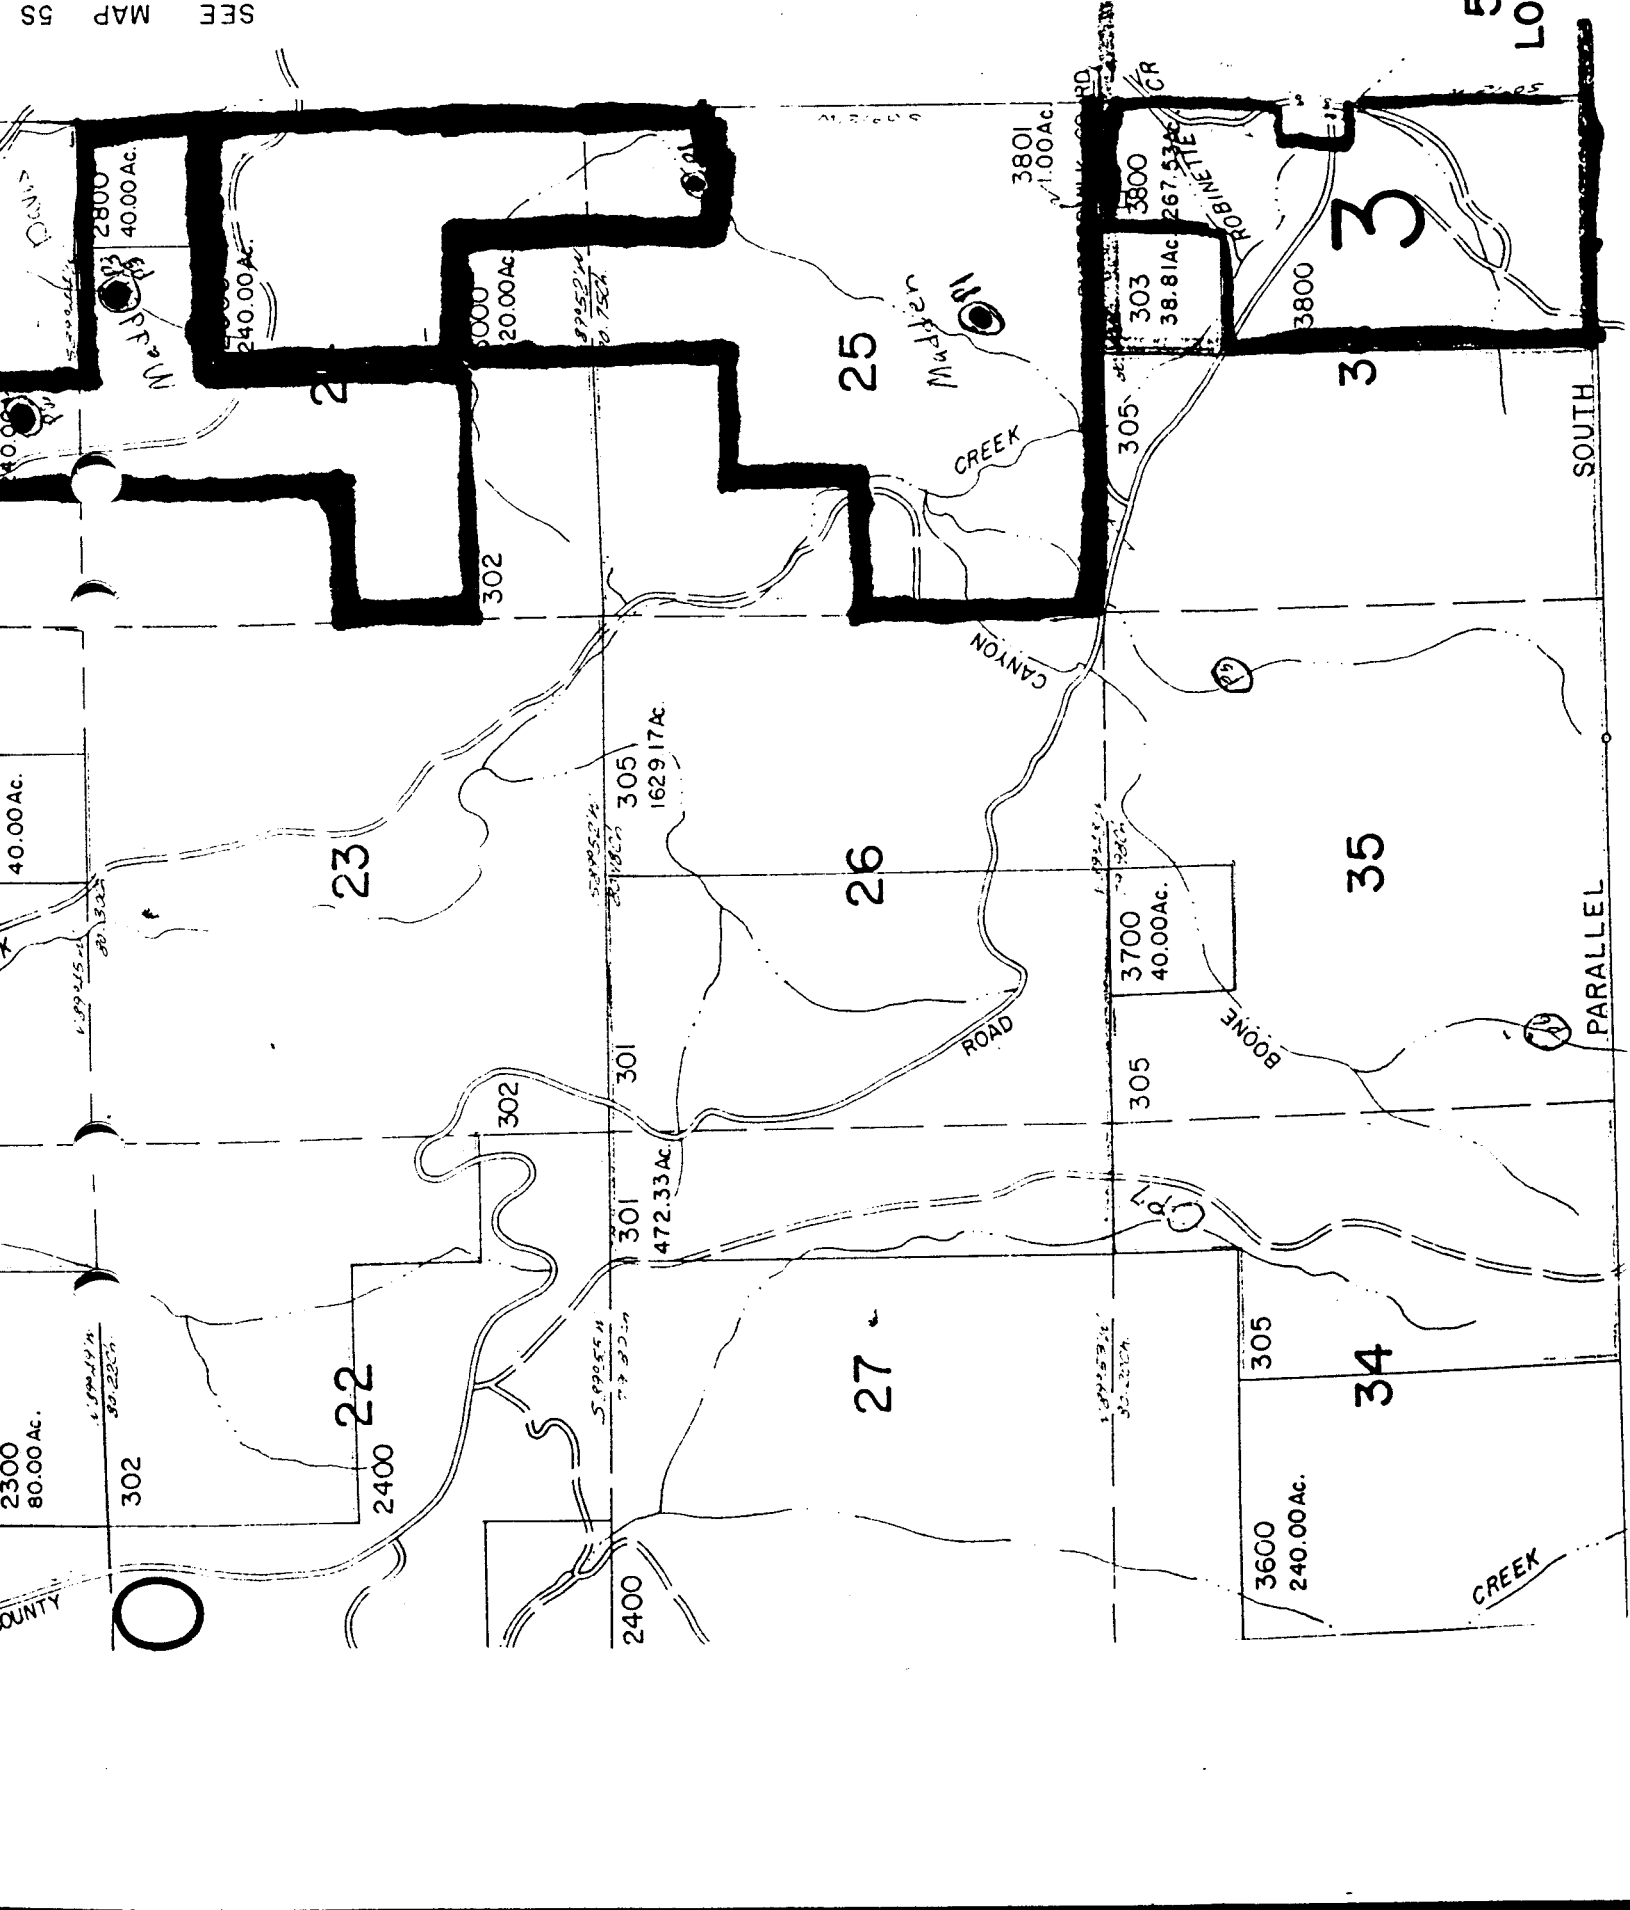

T5S-R23E

SEE MAP SS 24

Application No. R-77845
Permit No.

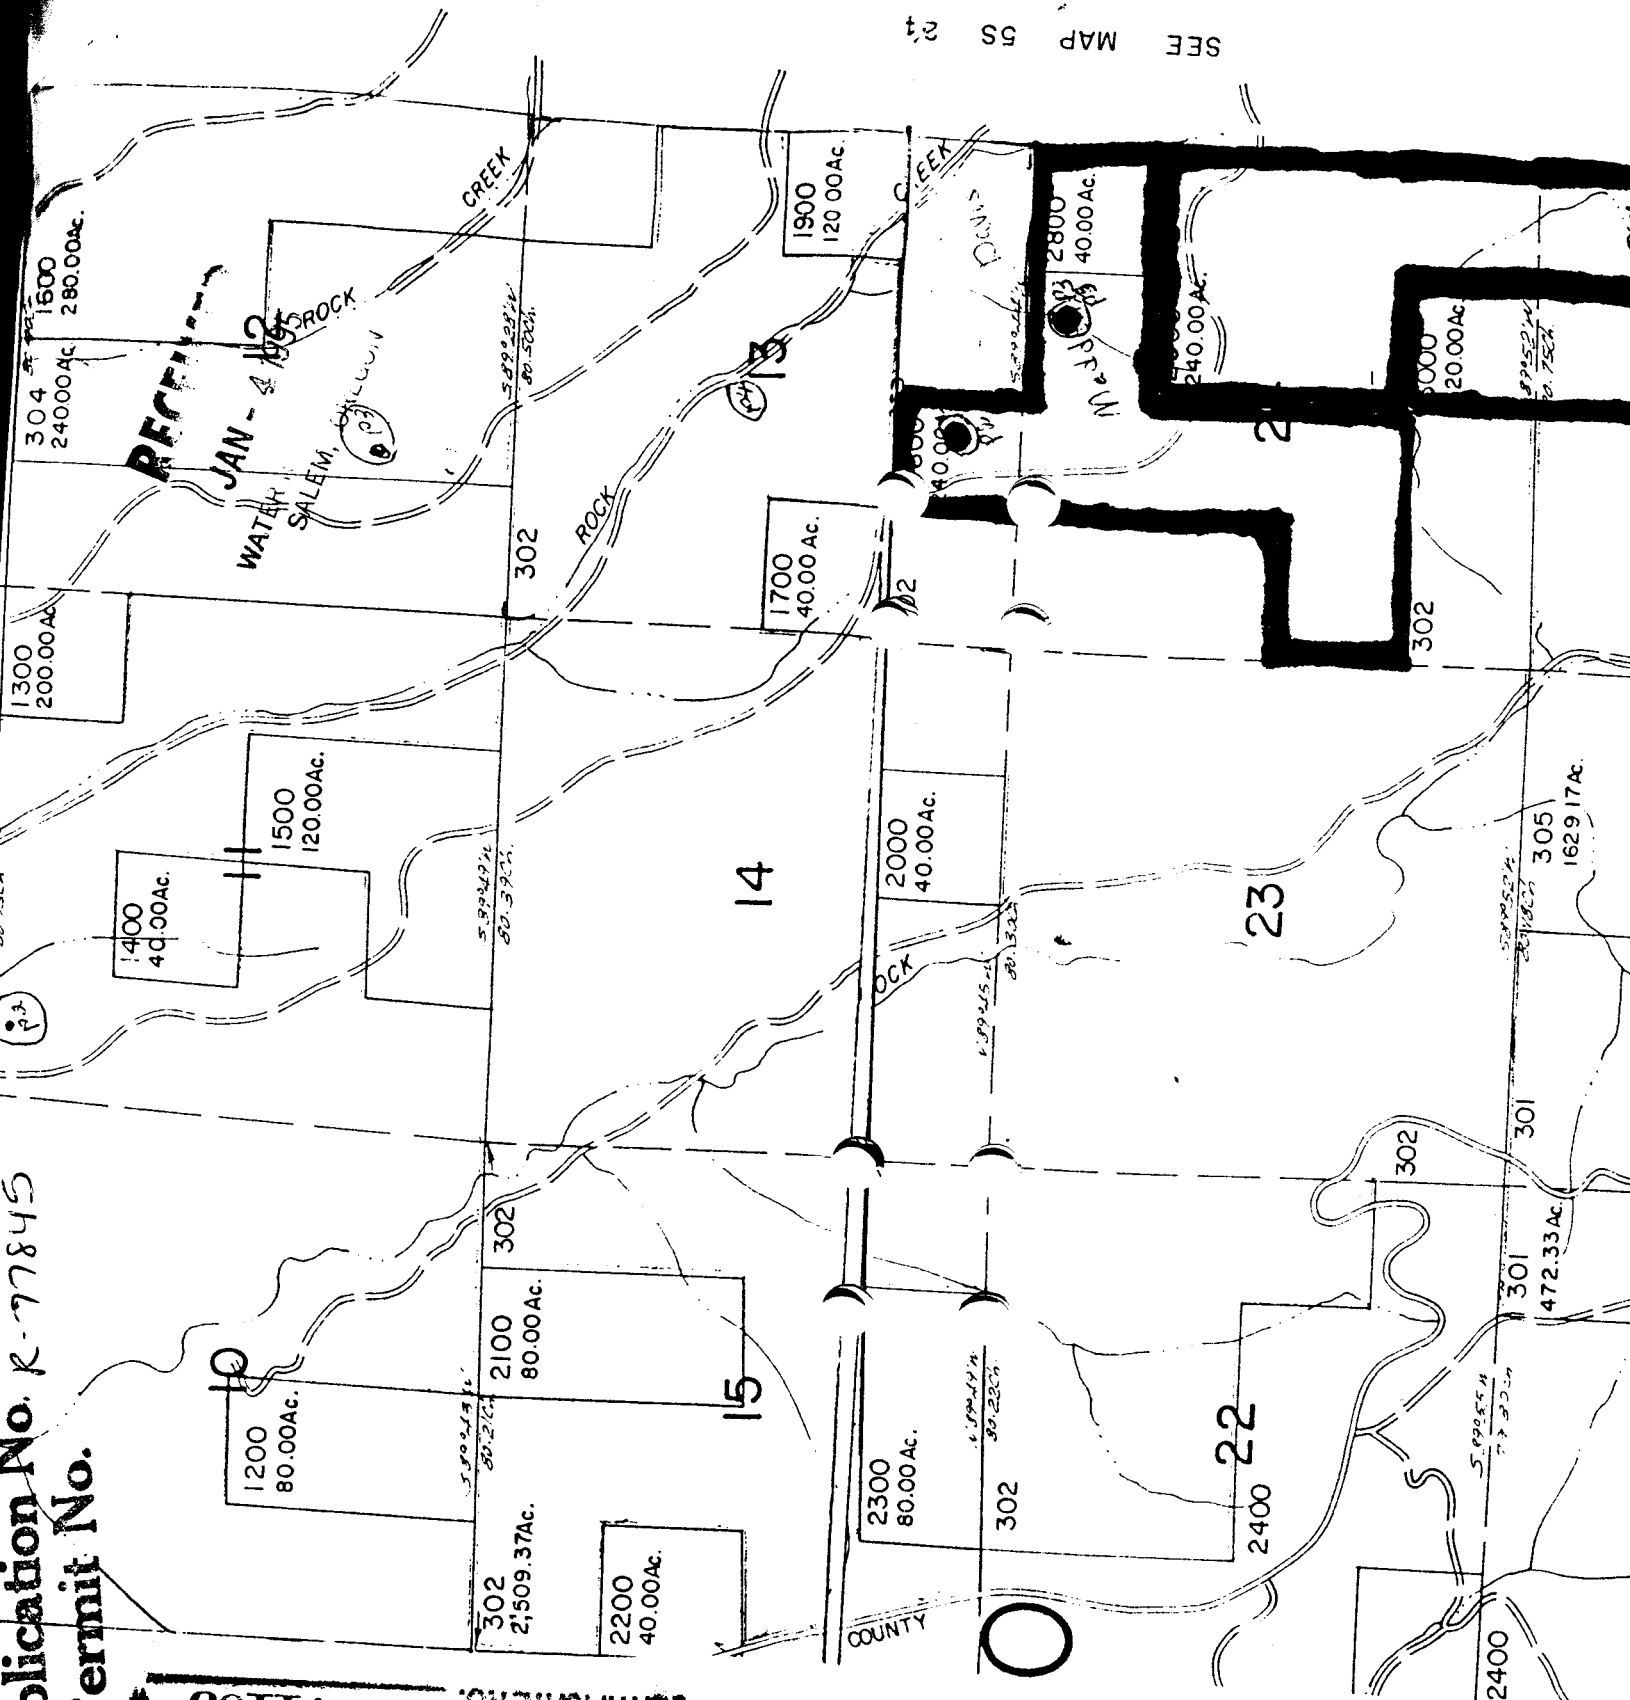


71105 CERTIFICATE NO.

T5S R24E
Gilliam Co

SEE MAP

CERTIFICATE NO. 71105

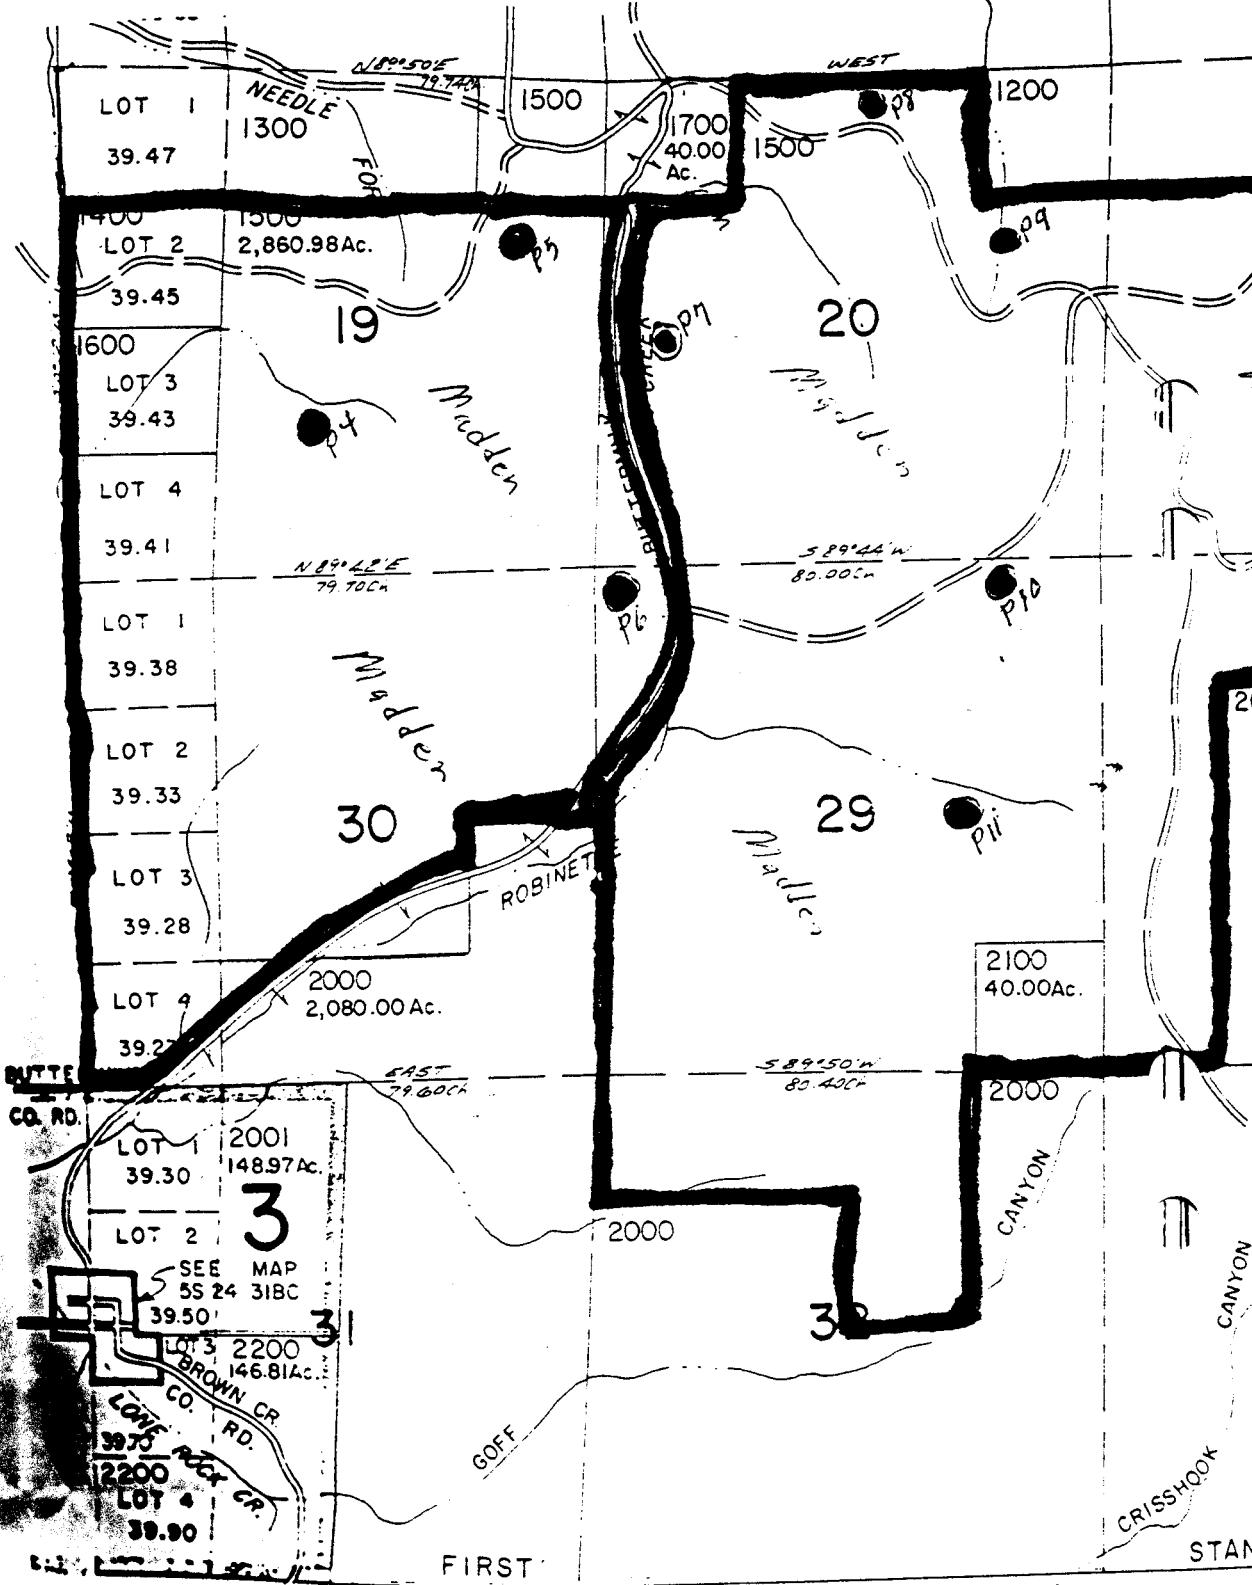

BUTTE CO. RD.

LOT 1 2001 148.97 Ac.
 39.30
3
 SEE MAP 55 24 31BC
 39.50
 LOT 3 2200 146.81 Ac.
 BROWN CR.
 CO. RD.
 39.75
 LOW ROCK CR.
 LOT 4 39.90


FIRST

STAN

SEE MAP 6S

D 12 F

T5S R24E Application No. R-77845
Gilliam County Permit No.

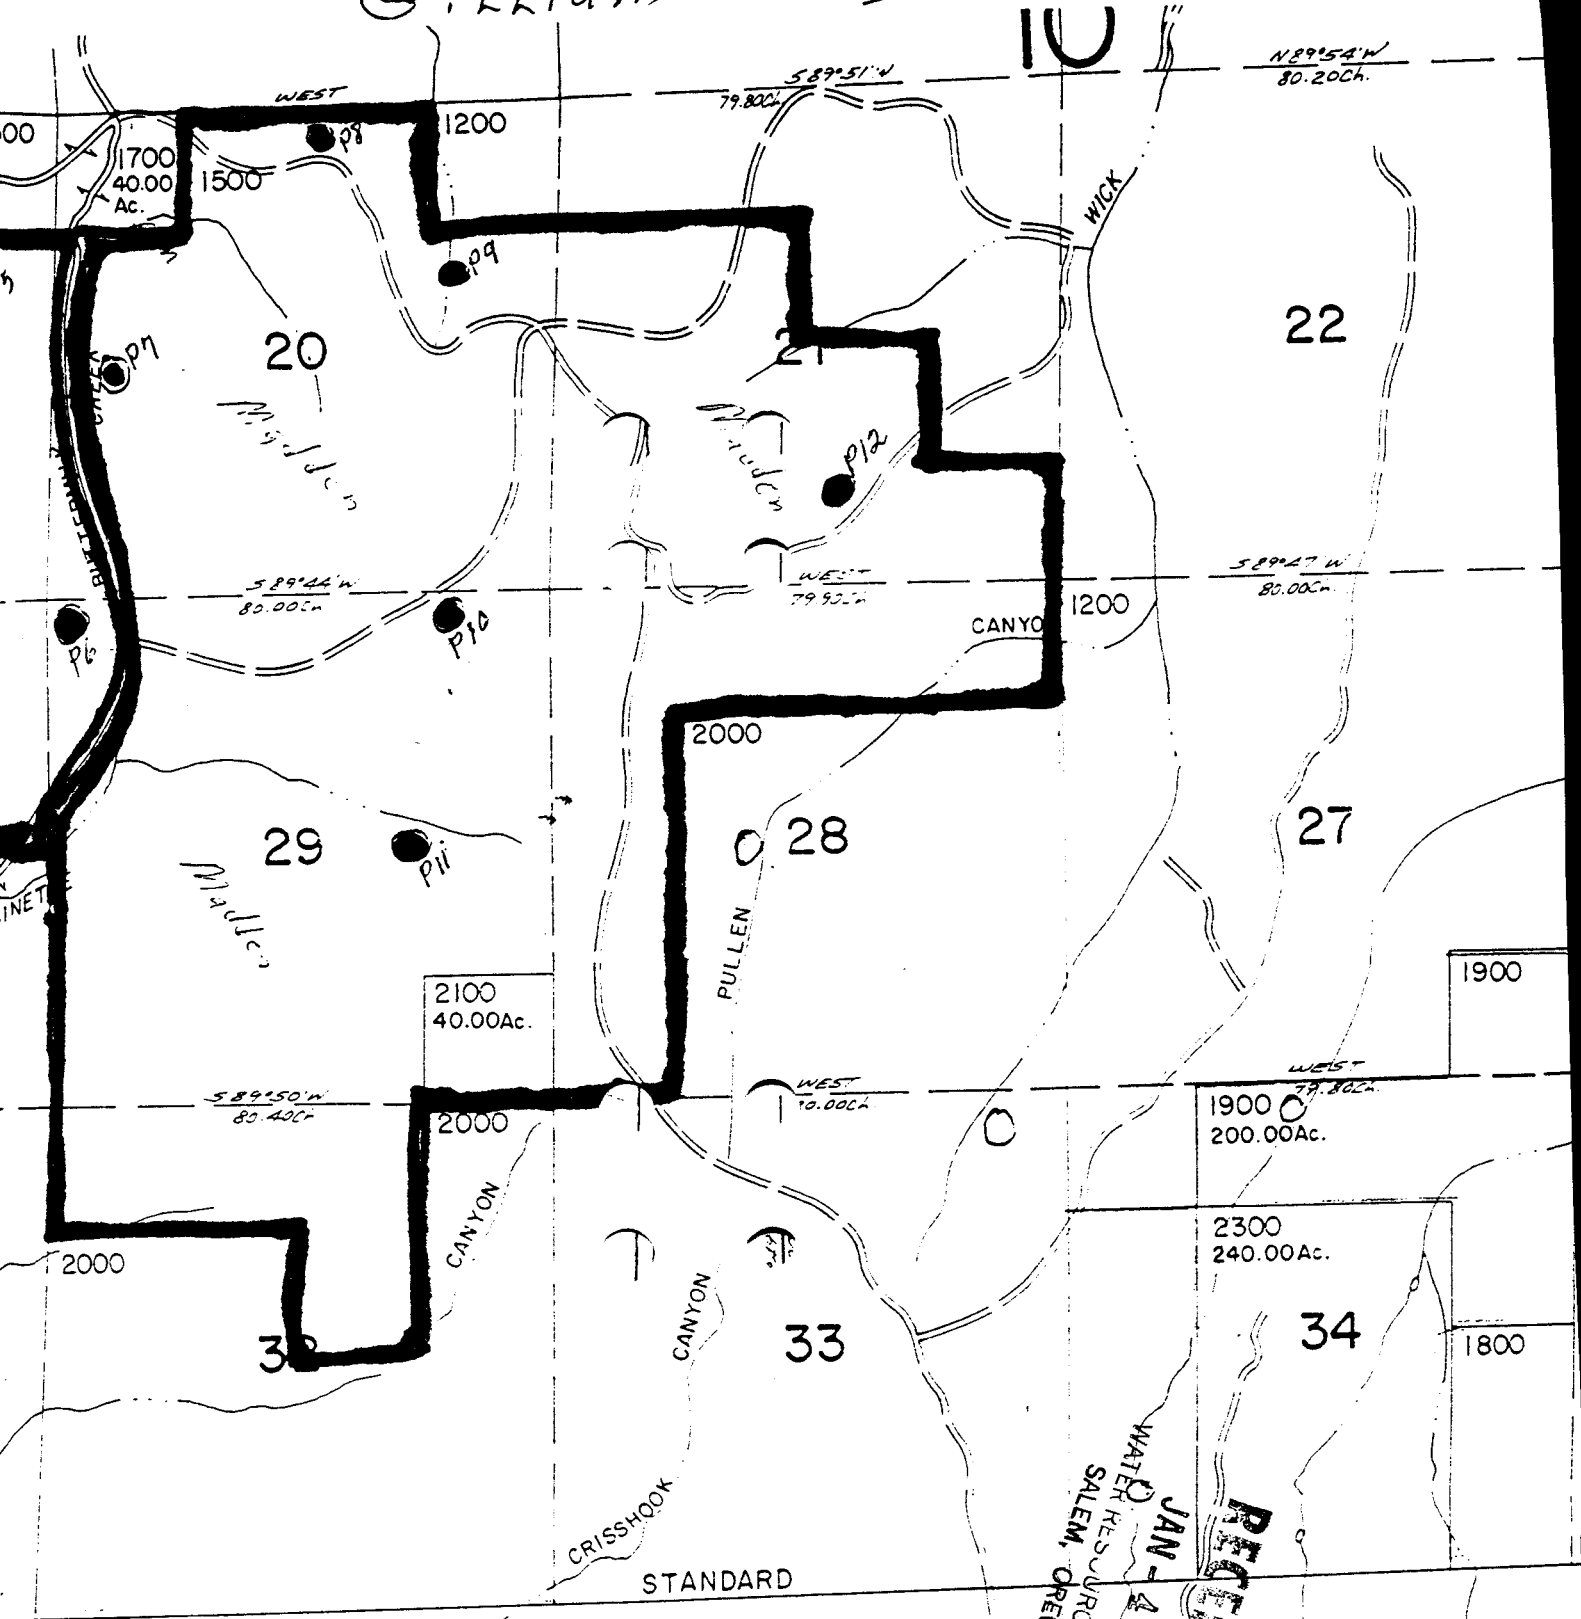

SEE MAP 6S 24

RECEIVED
 JAN - 2 1995
 WATER RESOURCES
 SALEM, OREGON