


Gilliam

FILE

JAN - 4 1995


WATER SEE MAP
SALEM, OREGON

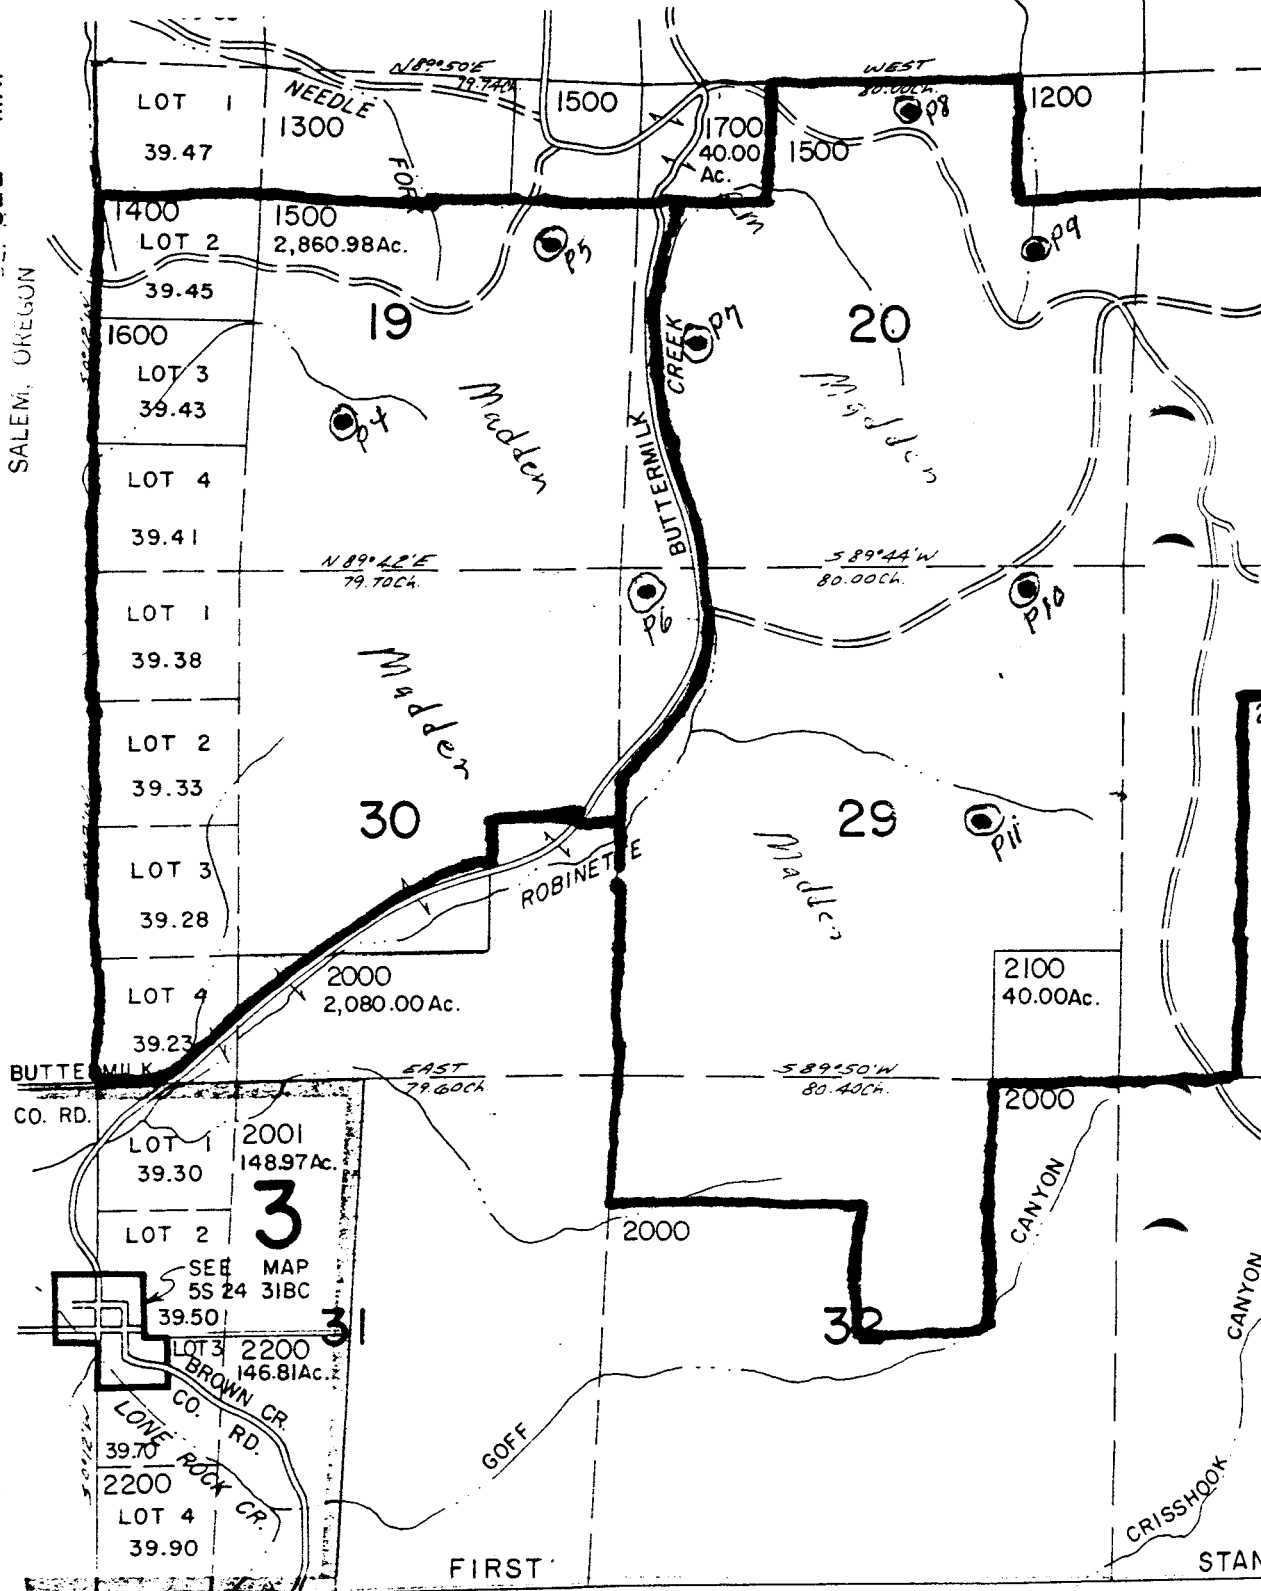

SEE MAP 6S

Application No. R-77846
Permit No.

T5S R24E
Gilliam County

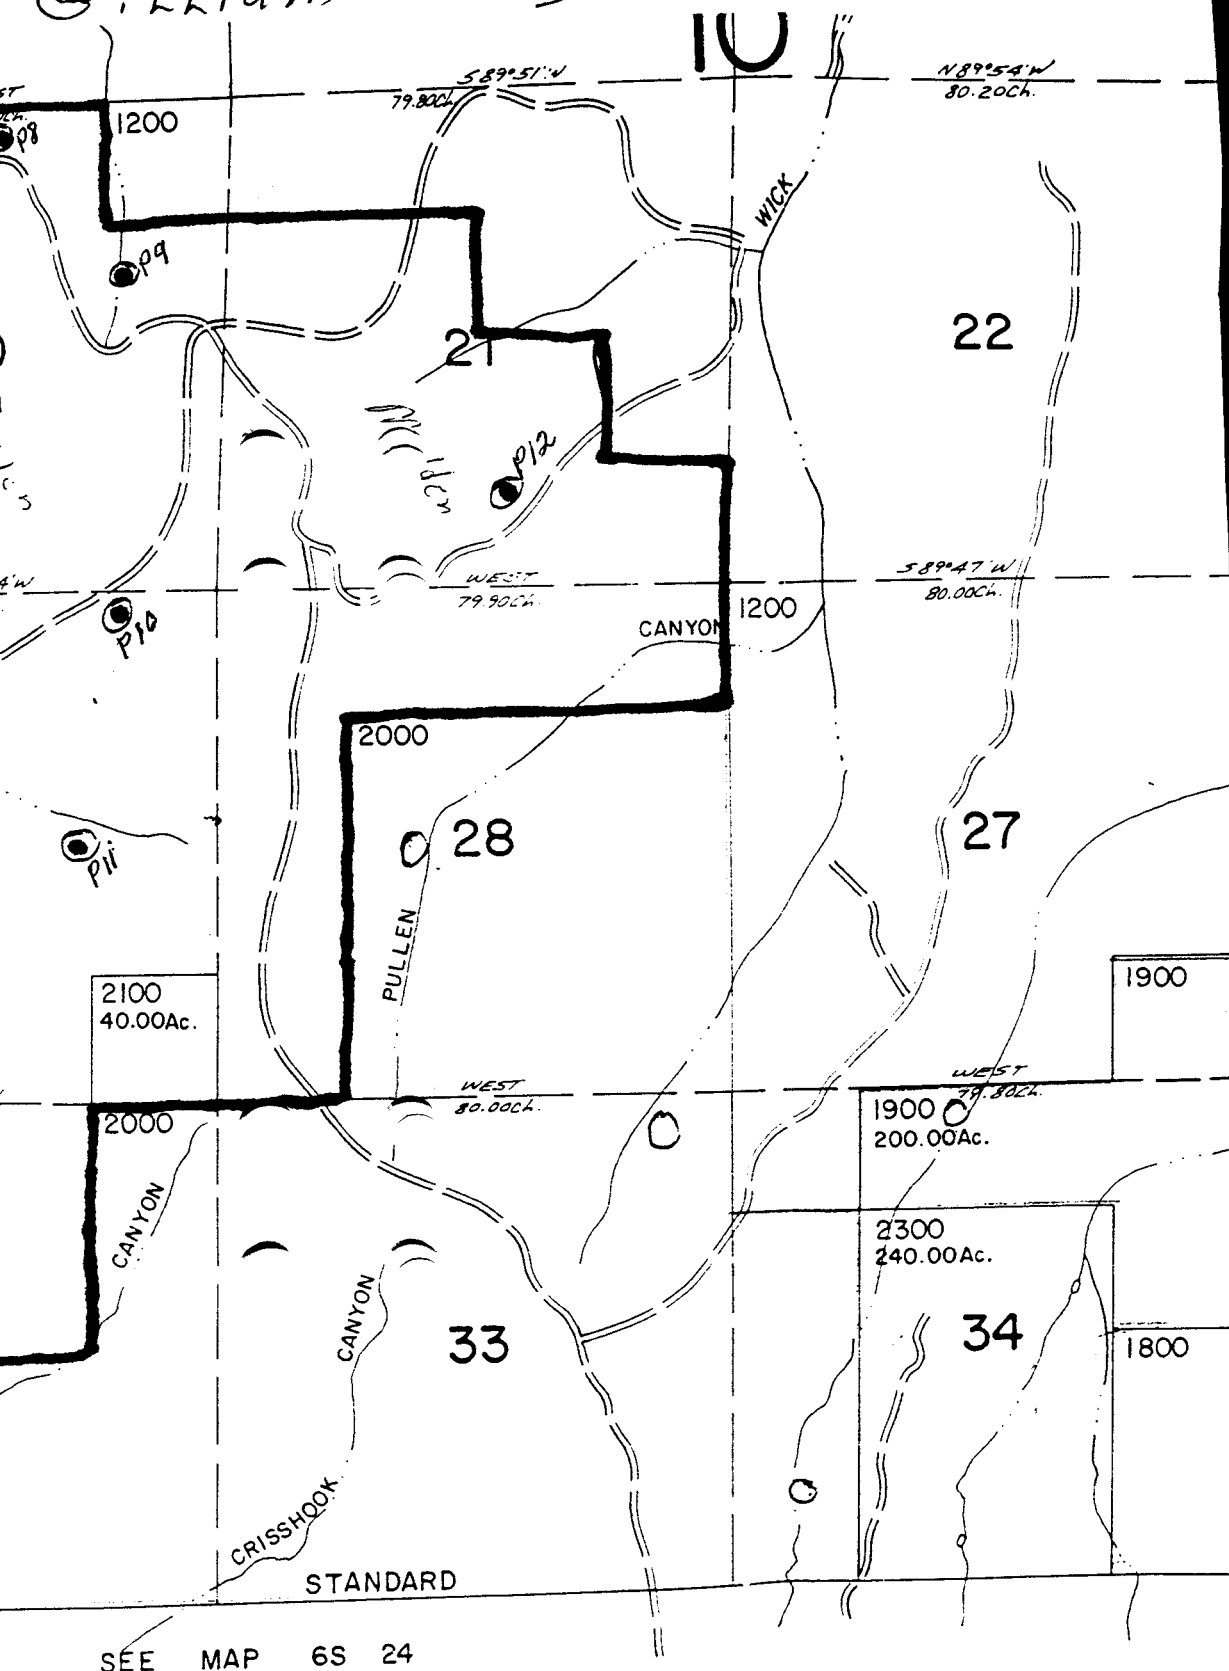

SEE MAP 6S 24