


RECEIVED

JAN 23 1996

WATER RESOURCES DEPT.
SALEM, OREGON

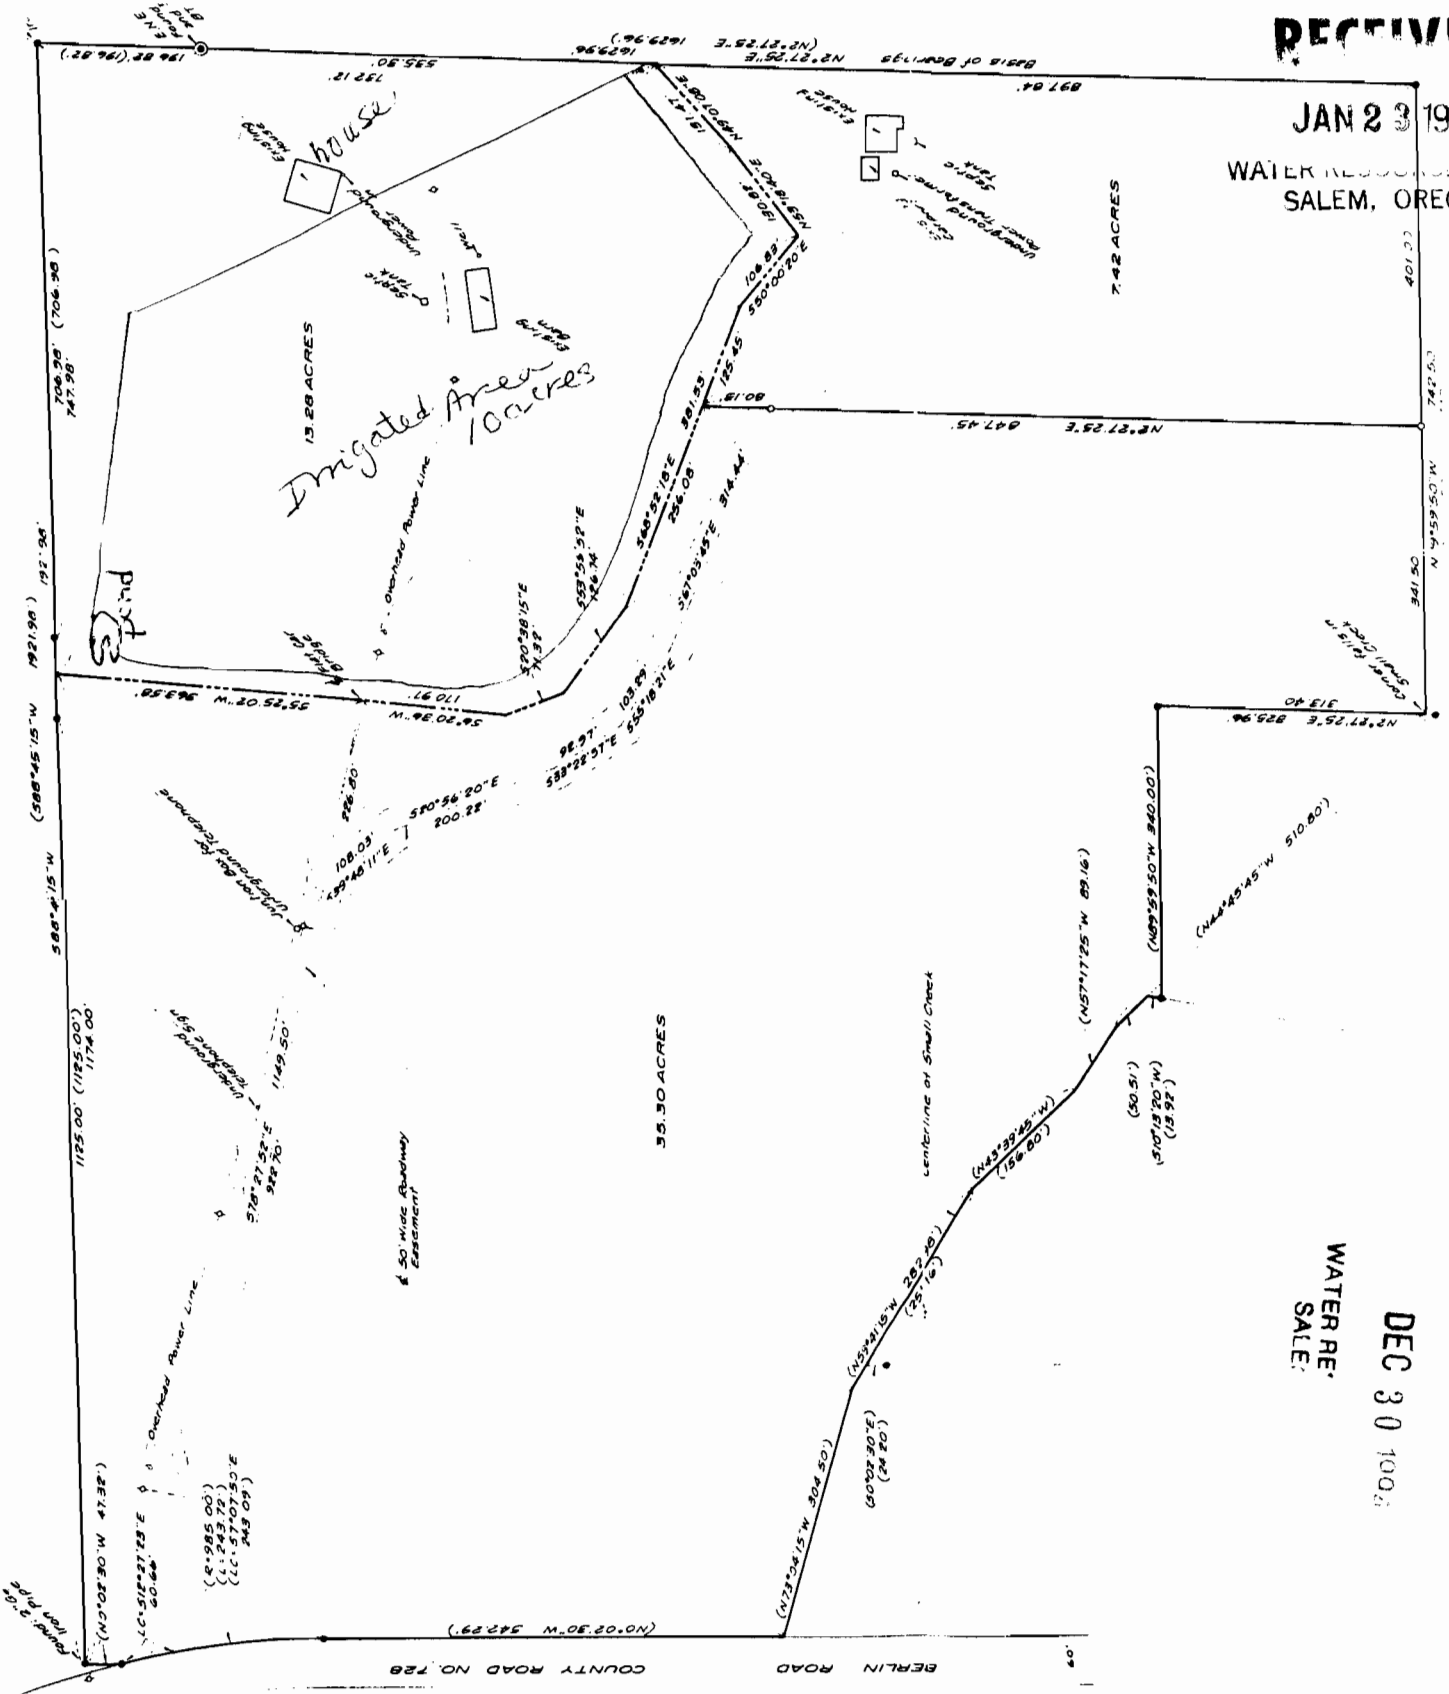

REC

DEC 30 1995

WATER RE.
SALE

NW corner NW quarter Township 13 S Range 1 E Section 6

Application No. R 77848
Permit No.