


RECEIVED

JAN - 3 1995

WATER RESOURCES DEP.
SALEM, OREGON

Application No. R-77900
Permit No.

T. 21 S. R. 40 E. W.M.

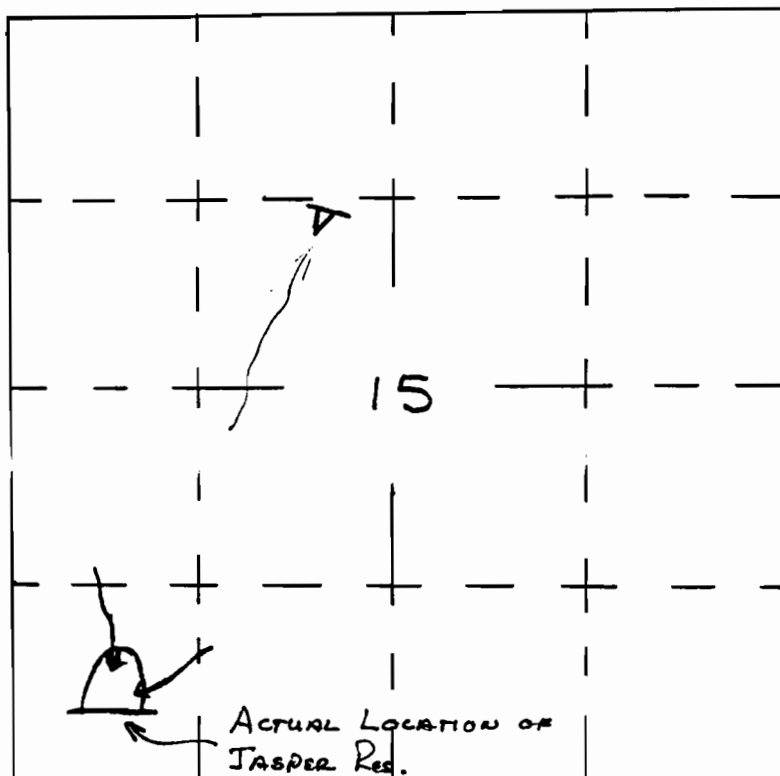

Application No. R59101
Permit No. R 8739

71134

U. S. DEPARTMENT OF THE INTERIOR
BUREAU OF LAND MANAGEMENT

JASPER

DESIGNED_____	RECOMM._____
DRAWN_____	RECOMM._____
CHECKED_____	APPROVED_____
SCALE	
DATE	SHEET_____OF_____
DRAWING NO.	