


DELETED TAX LOT
NUMBERS
501

MAP 8 3W 18C

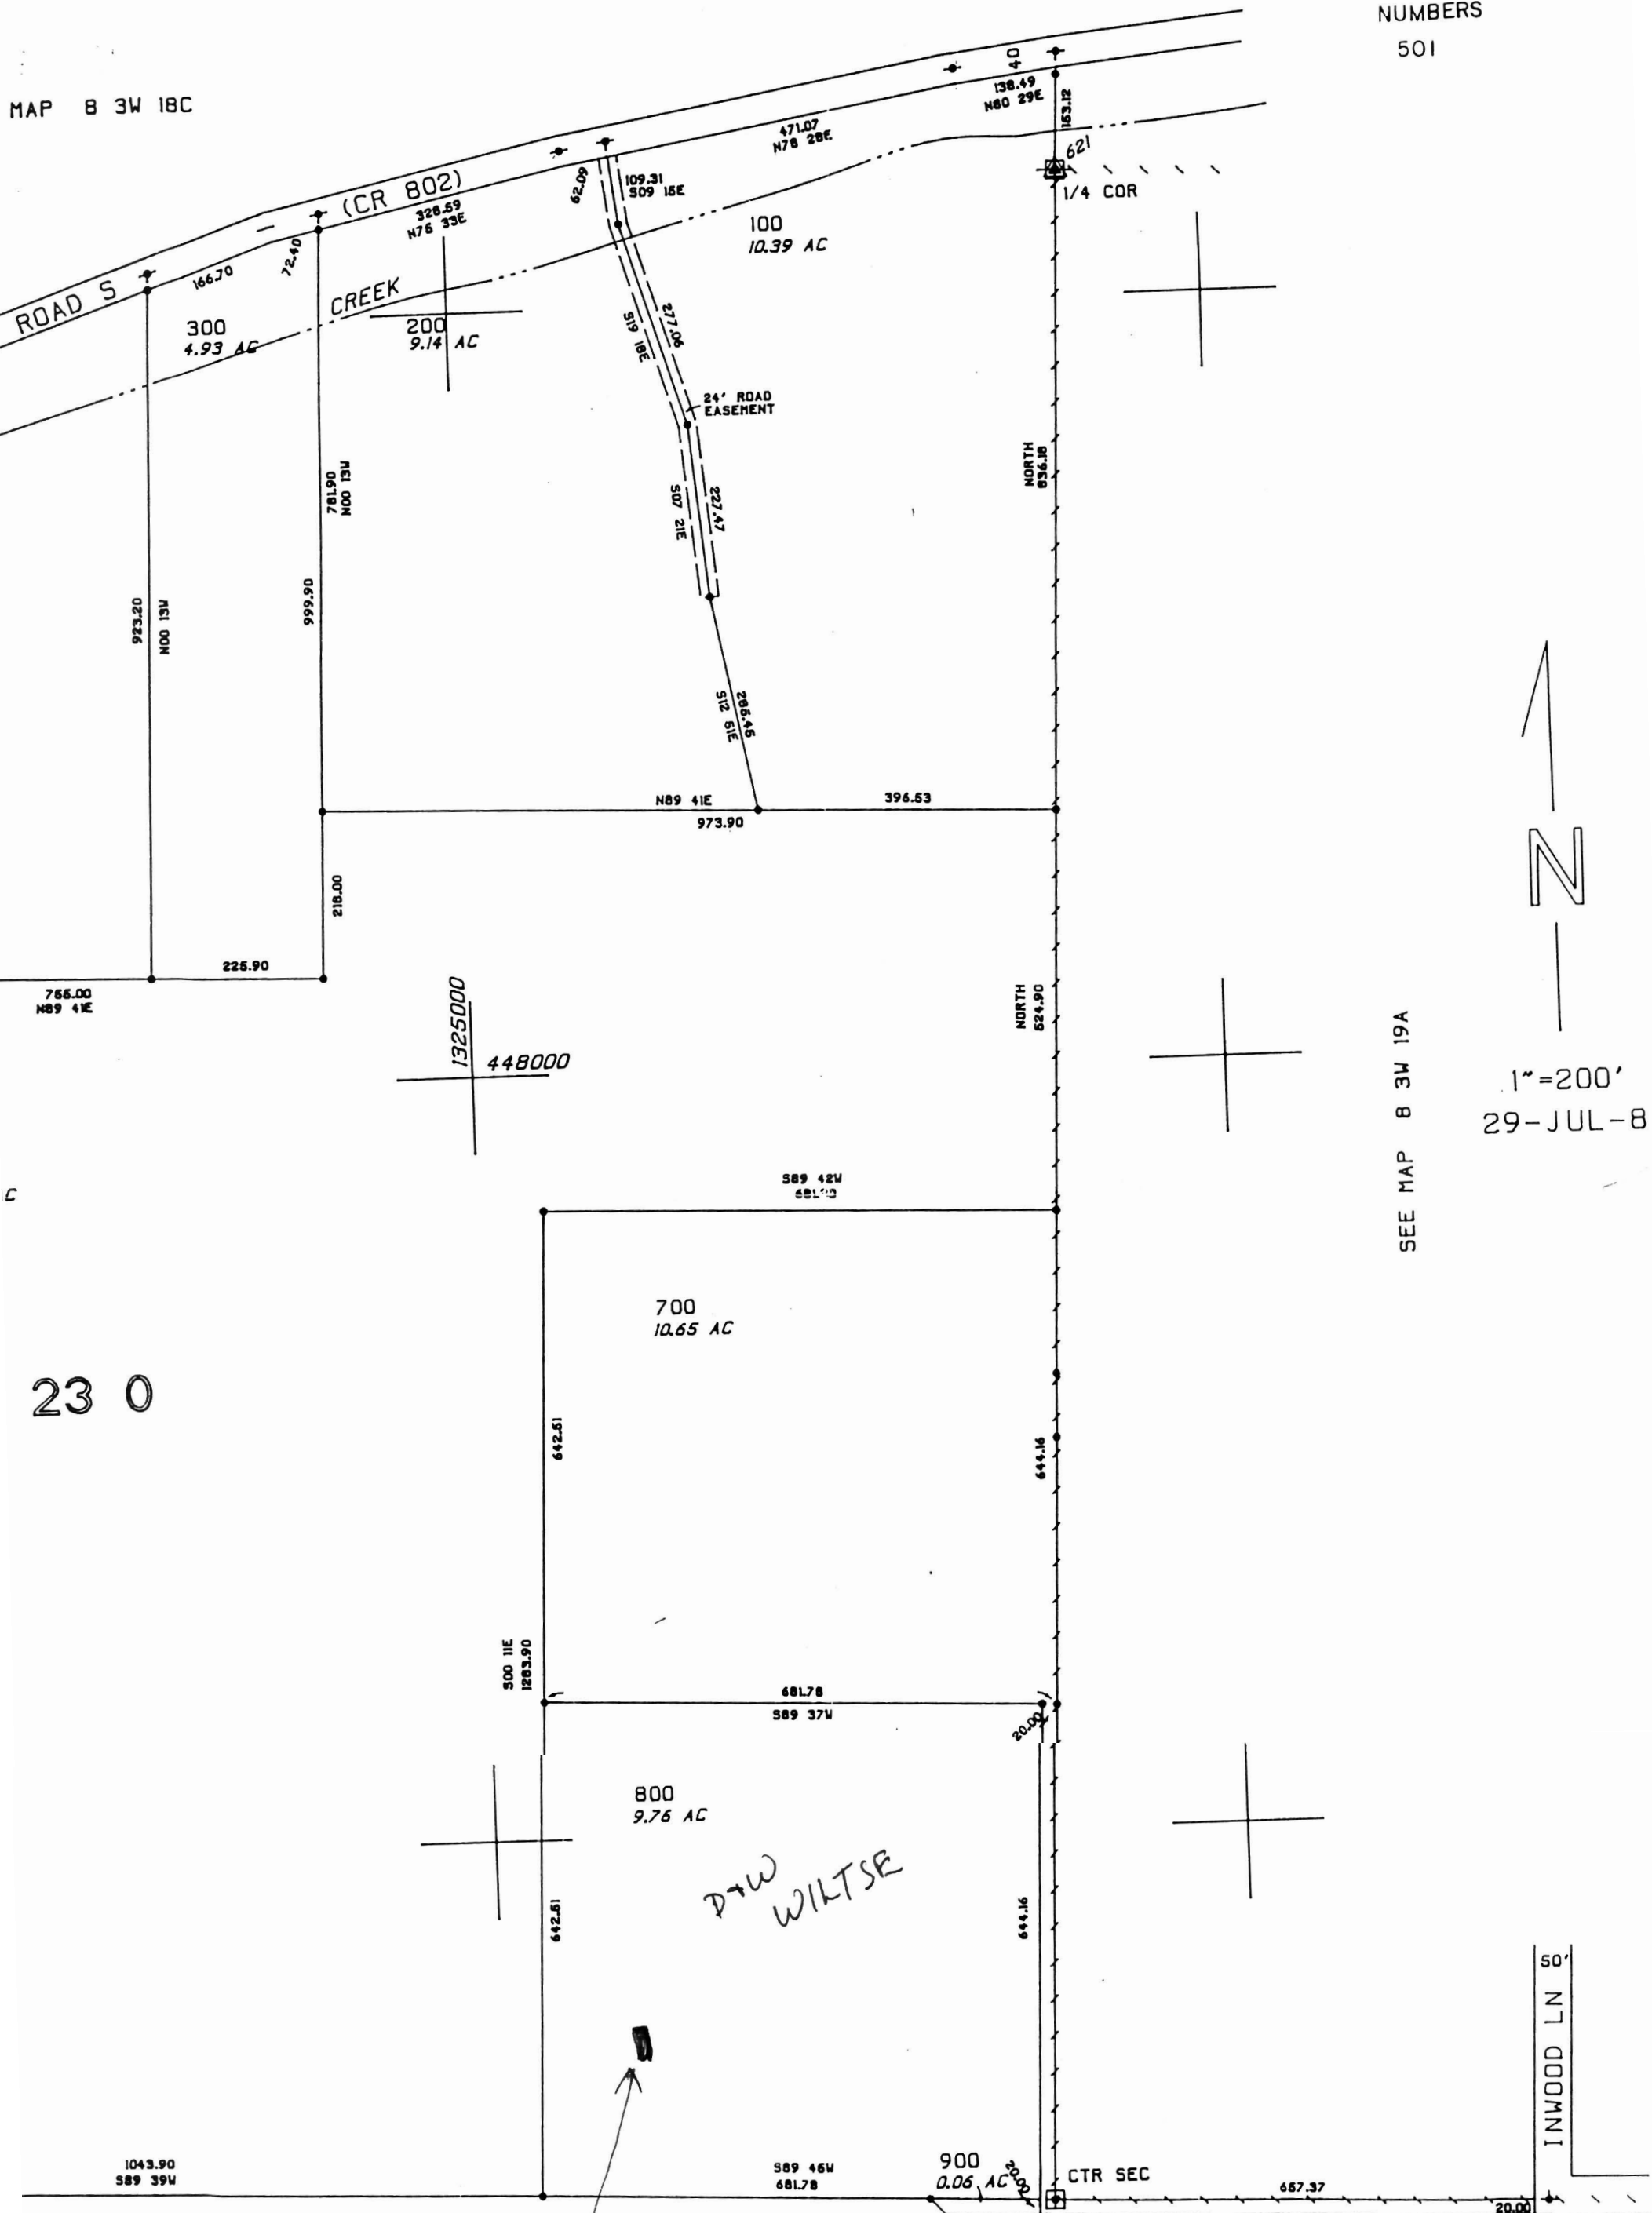

23 0

1325000
448000

D+W
WILTSE

↑
POND

SEE MAP 8 3W 19C

71141

Application No. R-77907
Permit No.

SEE MAP 8 3W 19A

1"=200'
29-JUL-8

8 3W