

RECEIVED

ON

JAN 16 1996
WATER RESOURCES DEPT.
SALEM, OREGON

TOWNSHIP 38 S, RANGE 45 E, W. M.

Larvation Waterhole North

Drainage Map

19

RECEIVED
AUG 8 1961
STATE ENGINEER
SALEM, OREGON


South

APPLICATION No. R-36698

APPLICATION MAP
FOR PERMIT TO
CONSTRUCT RESERVOIRS IN SEC. 13 & 14, T.33S., R.46E., W.M.

RECEIVED
JAN 16 1996
WATER RESOURCES DEPT.
SALEM, OREGON

CERTIFICATE NO. 71180

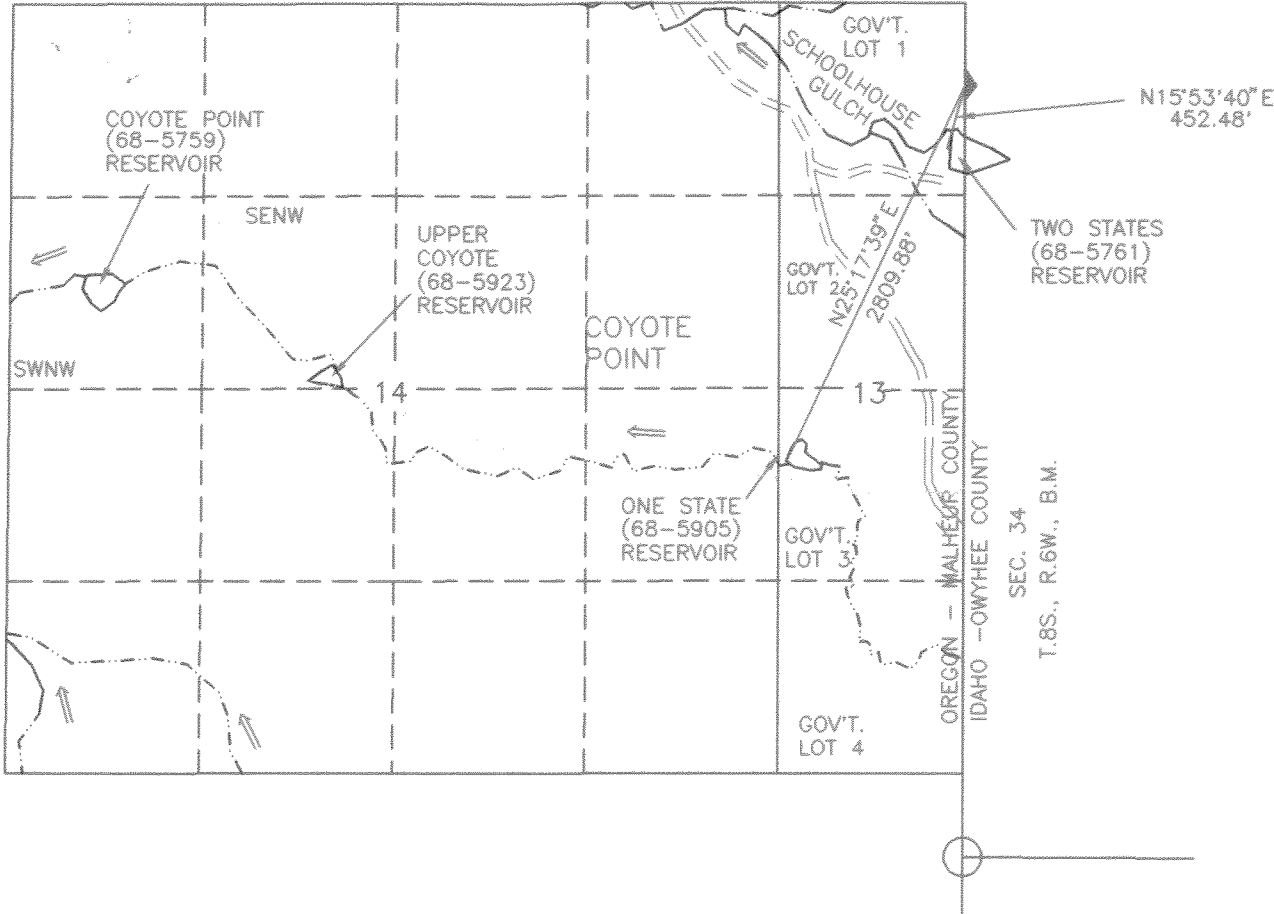


- LEGEND
- RESERVOIR
 - ROAD
 - CHANNEL
 - FD SEC COR
 - FENCE
 - COR SEARCHED FOR BUT NOT FOUND

COYOTE POINT (68-5759) RESERVOIR
SW1/4NW1/4 SECTION 14, T.33S., R.46E., W.M.
U.S.G.S. QUAD - JUNIPER POINT, OREG.-IDAHO - 7 1/2'

UPPER COYOTE POINT (68-5923) RESERVOIR
SE1/4NW1/4 SECTION 14, T.33S., R.46E., W.M.
U.S.G.S. QUAD - JUNIPER POINT, OREG.-IDAHO - 7 1/2'

ONE STATE (68-5905) RESERVOIR
GOV'T. LOT 3, SECTION 13, T.33S., R.46E., W.M.
U.S.G.S. QUAD - JUNIPER POINT, OREG.-IDAHO - 7 1/2'

TWO STATES (68-5761) RESERVOIR
GOV'T. LOT 1, SECTION 13, T.33S., R.46E., W.M.
U.S.G.S. QUAD - JUNIPER POINT, OREG.-IDAHO - 7 1/2'

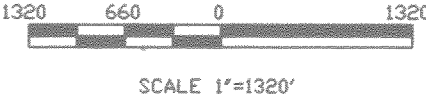

THIS MAP IS FOR THE PURPOSE OF LOCATING
A WATER RIGHT AND IS NOT INTENDED TO
PROVIDE LEGAL DIMENSIONS FOR LOCATION
OF PROPERTY BOUNDARIES.

Certified Water Right Examiner
Vernon R. Pritchard
May 17, 1988
STATE OF OREGON

ALWAYS
THINK
SAFETY


UNITED STATES DEPARTMENT OF THE INTERIOR BUREAU OF LAND MANAGEMENT DIVISION OF OPERATIONS VALE DISTRICT	
RESERVOIRS SITUATED IN SEC. 13 & 14, T. 33S., R.46E., W.M.	
DESIGNED	
REVIEWED	
APPROVED	
DRAWN: CG	
DATE: 05/02/94	SCALE: 1"=1320'
SHEET 1 OF 1	
DRAWING NO. OR-03-9172.45-501	

ACAD RELEASE 11
DWG FILE: COYOTPT.DWG


APPLICATION MAP FOR PERMIT TO CONSTRUCT A RESEVOIR

NW1/4 SW1/4 SEC 25 T 36S R 46E W.M.

U.S.G.S. QUAD - NO CROSSING CROSSING, OREG. - 7 1/2'

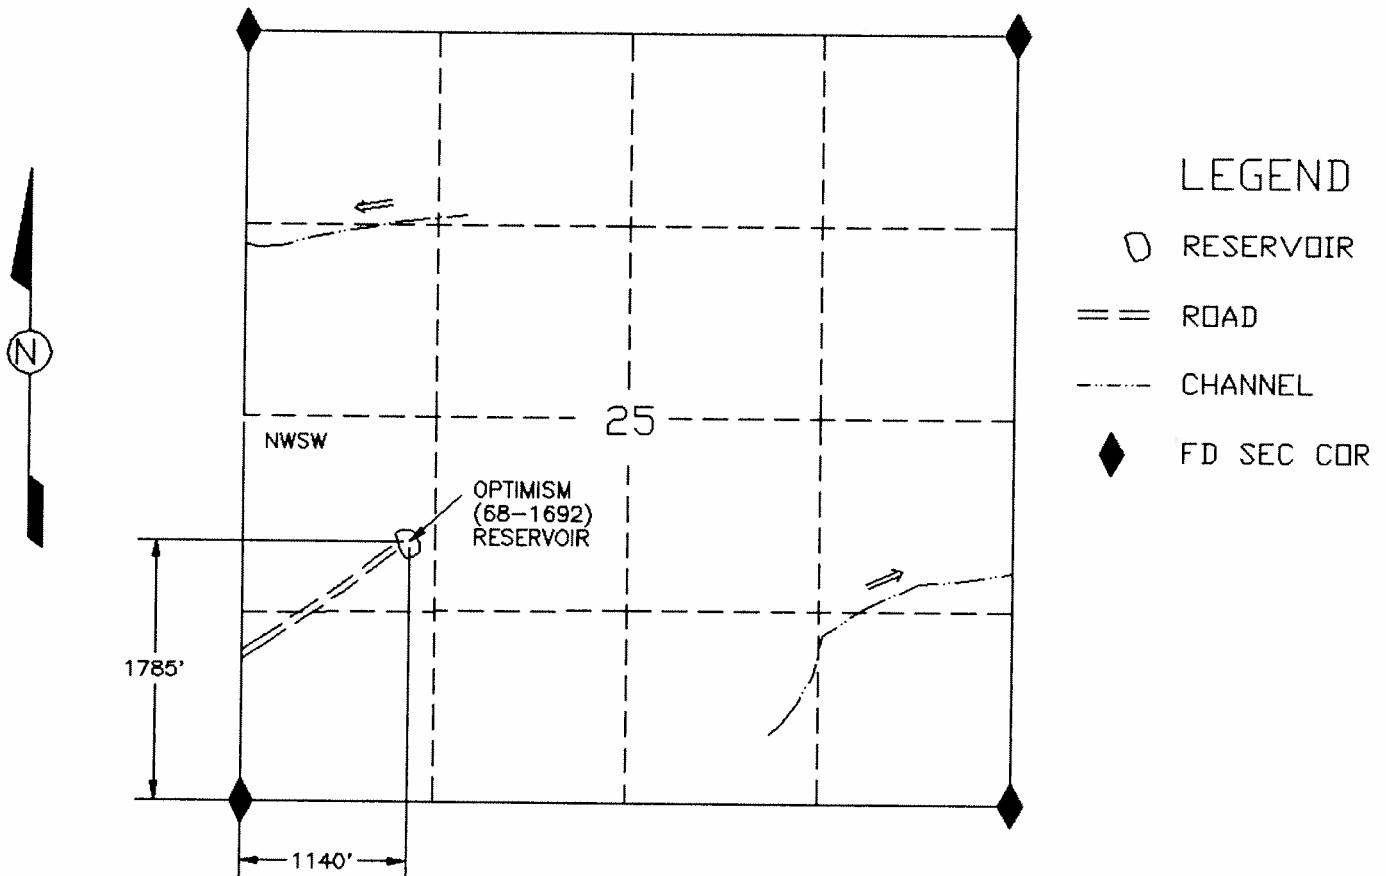

OPTIMISM (68-1692) RESERVOIR

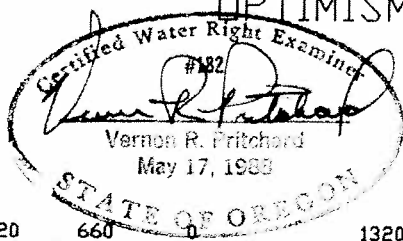

SCALE 1"=1320'

THIS MAP IS FOR THE PURPOSE OF LOCATING
A WATER RIGHT AND IS NOT INTENDED TO
PROVIDE LEGAL DIMENSIONS FOR LOCATION
OF PROPERTY BOUNDARIES.



UNITED STATES DEPARTMENT OF THE INTERIOR BUREAU OF LAND MANAGEMENT DIVISION OF OPERATIONS VALE DISTRICT	
OPTIMISM (68-1692) RESERVOIR	
DESIGNED	<i>Vernon R. Pritchard</i> CHIEF, BRANCH OF ENGINEERING
REVIEWED	
APPROVED	
DRAWN: CG	SCALE: 1"=1320'
DATE: 10/03/94	SHEET 1 OF 1
DRAWING NO. OR-03-9172.45-689	

ACAD RELEASE 11/DCA
DVG FILE: OPTIMISM.DVG

RECEIVED

CERTIFICATE NO. 71160

JAN 16 1996
WATER RESOURCES DEPT
SALEM, OREGON