


11S., R.42E., W.M.


1/2'

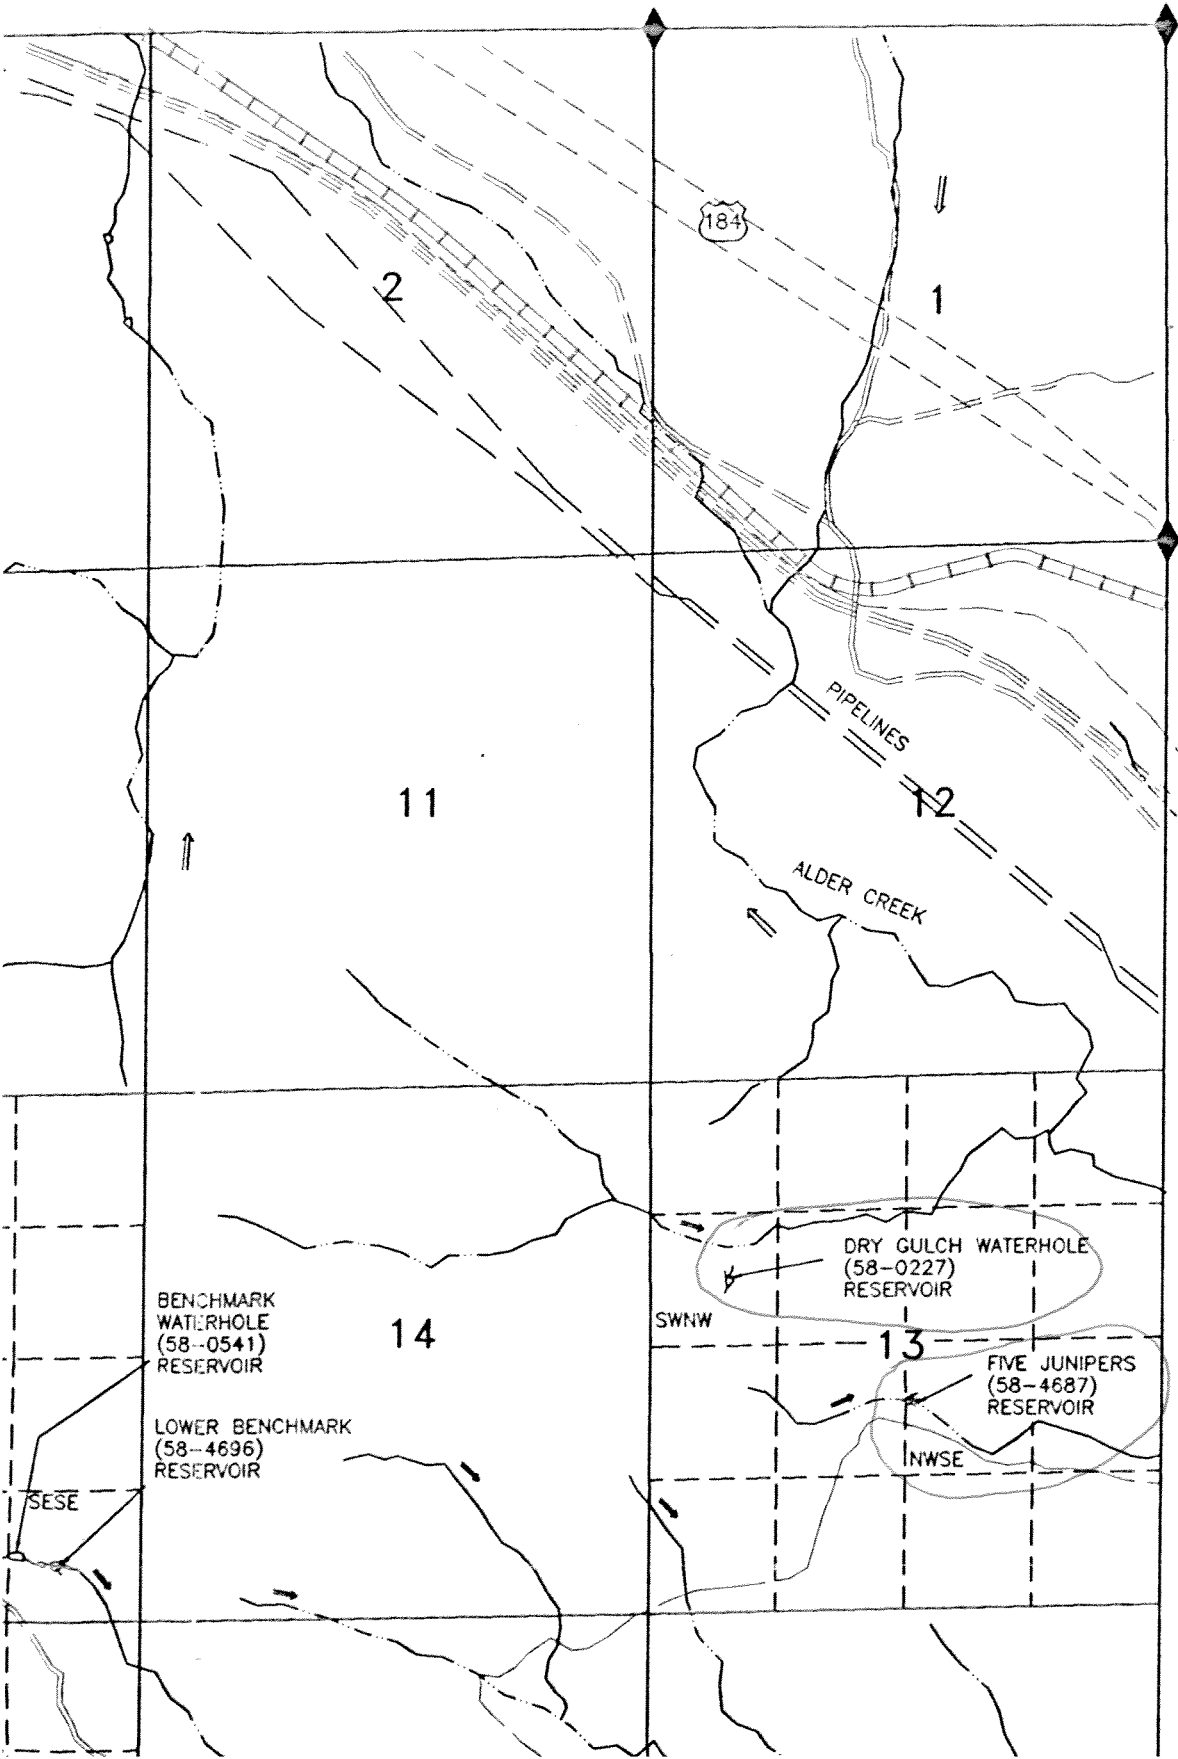

APPLICATION MAP FOR PERMIT TO CONSTRUCT A RESERVOIR

NE1/4 SE1/4 SEC 16 T 10S R 42E W.M.

U.S.G.S. QUAD - OXMAN, OREG. - 7 1/2'

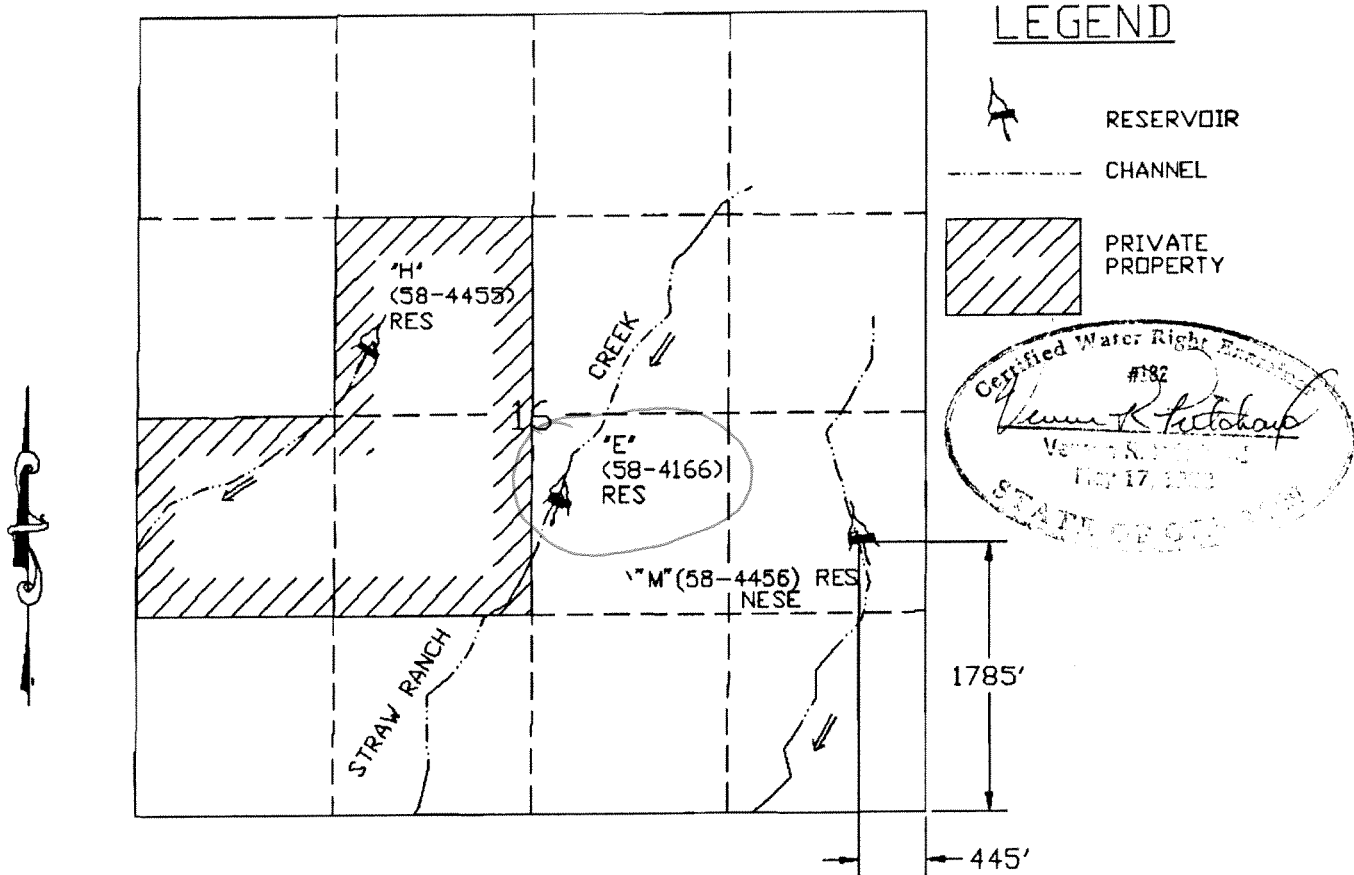

"M" (58-4456) RESERVOIR

OVERALL DIMENSIONS OF THIS SECTION
ARE FROM THE ORIGINAL CADASTRAL
SURVEY FIELD NOTES.

1320 660 0 1320



SCALE 1"=1320'

THIS MAP IS FOR THE PURPOSE OF LOCATING
A WATER RIGHT AND IS NOT INTENDED TO
PROVIDE LEGAL DIMENSIONS FOR LOCATION
OF PROPERTY BOUNDARIES.



ACAD RELEASE 11/DCA
DWG FILE: MRES.DWG

UNITED STATES DEPARTMENT OF THE INTERIOR
BUREAU OF LAND MANAGEMENT
DIVISION OF OPERATIONS VALE DISTRICT


"M" (58-4456) RESERVOIR

DESIGNED
REVIEWED *Devin R. Fitch*
APPROVED *George H. House*
CHIEF, BRANCH OF ENGINEERING

DRAWN: CG SCALE: 1"=1320'
DATE: 08/23/93 SHEET 1 OF 1
DRAWING NO. OR-03-9172.45-361

Application No. R-73774
Permit No.

00035

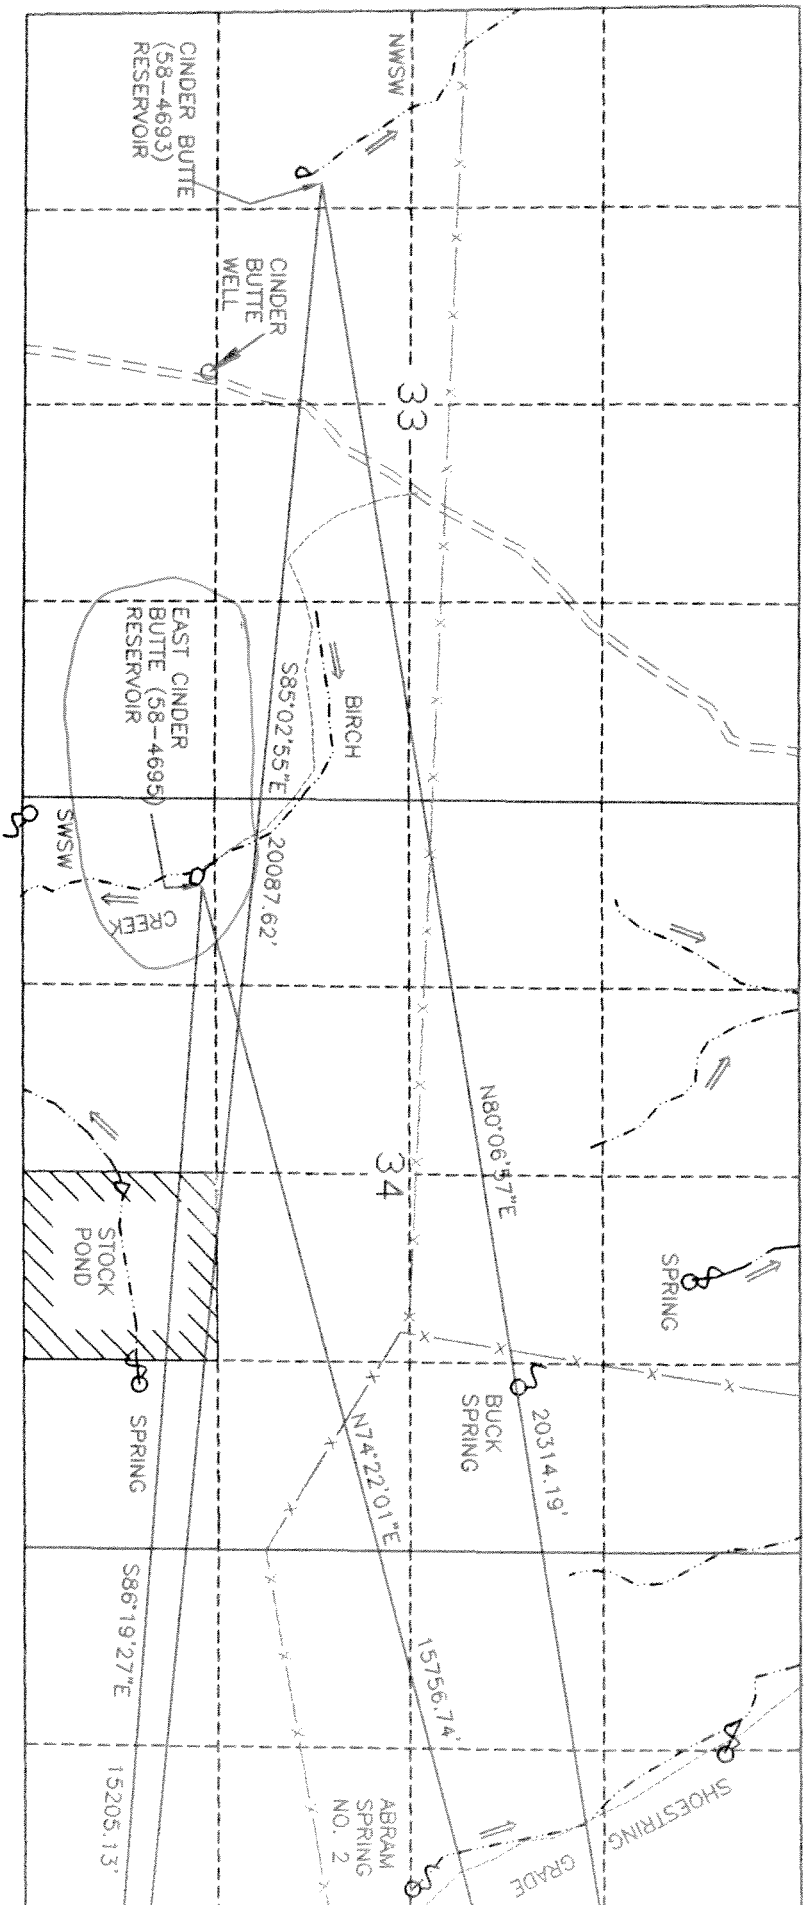

T135 R43E