

Application No. *R60395*

UNITED STATES

2001

Permit No. *101128*

DEPARTMENT OF THE INTERIOR

BUREAU OF LAND MANAGEMENT

SECTION

11


Oregon State Water Filings

SW 1/4 NE 1/4

TOWNSHIP *18^s*, RANGE *39^E*, W. M.

North

Big Indian

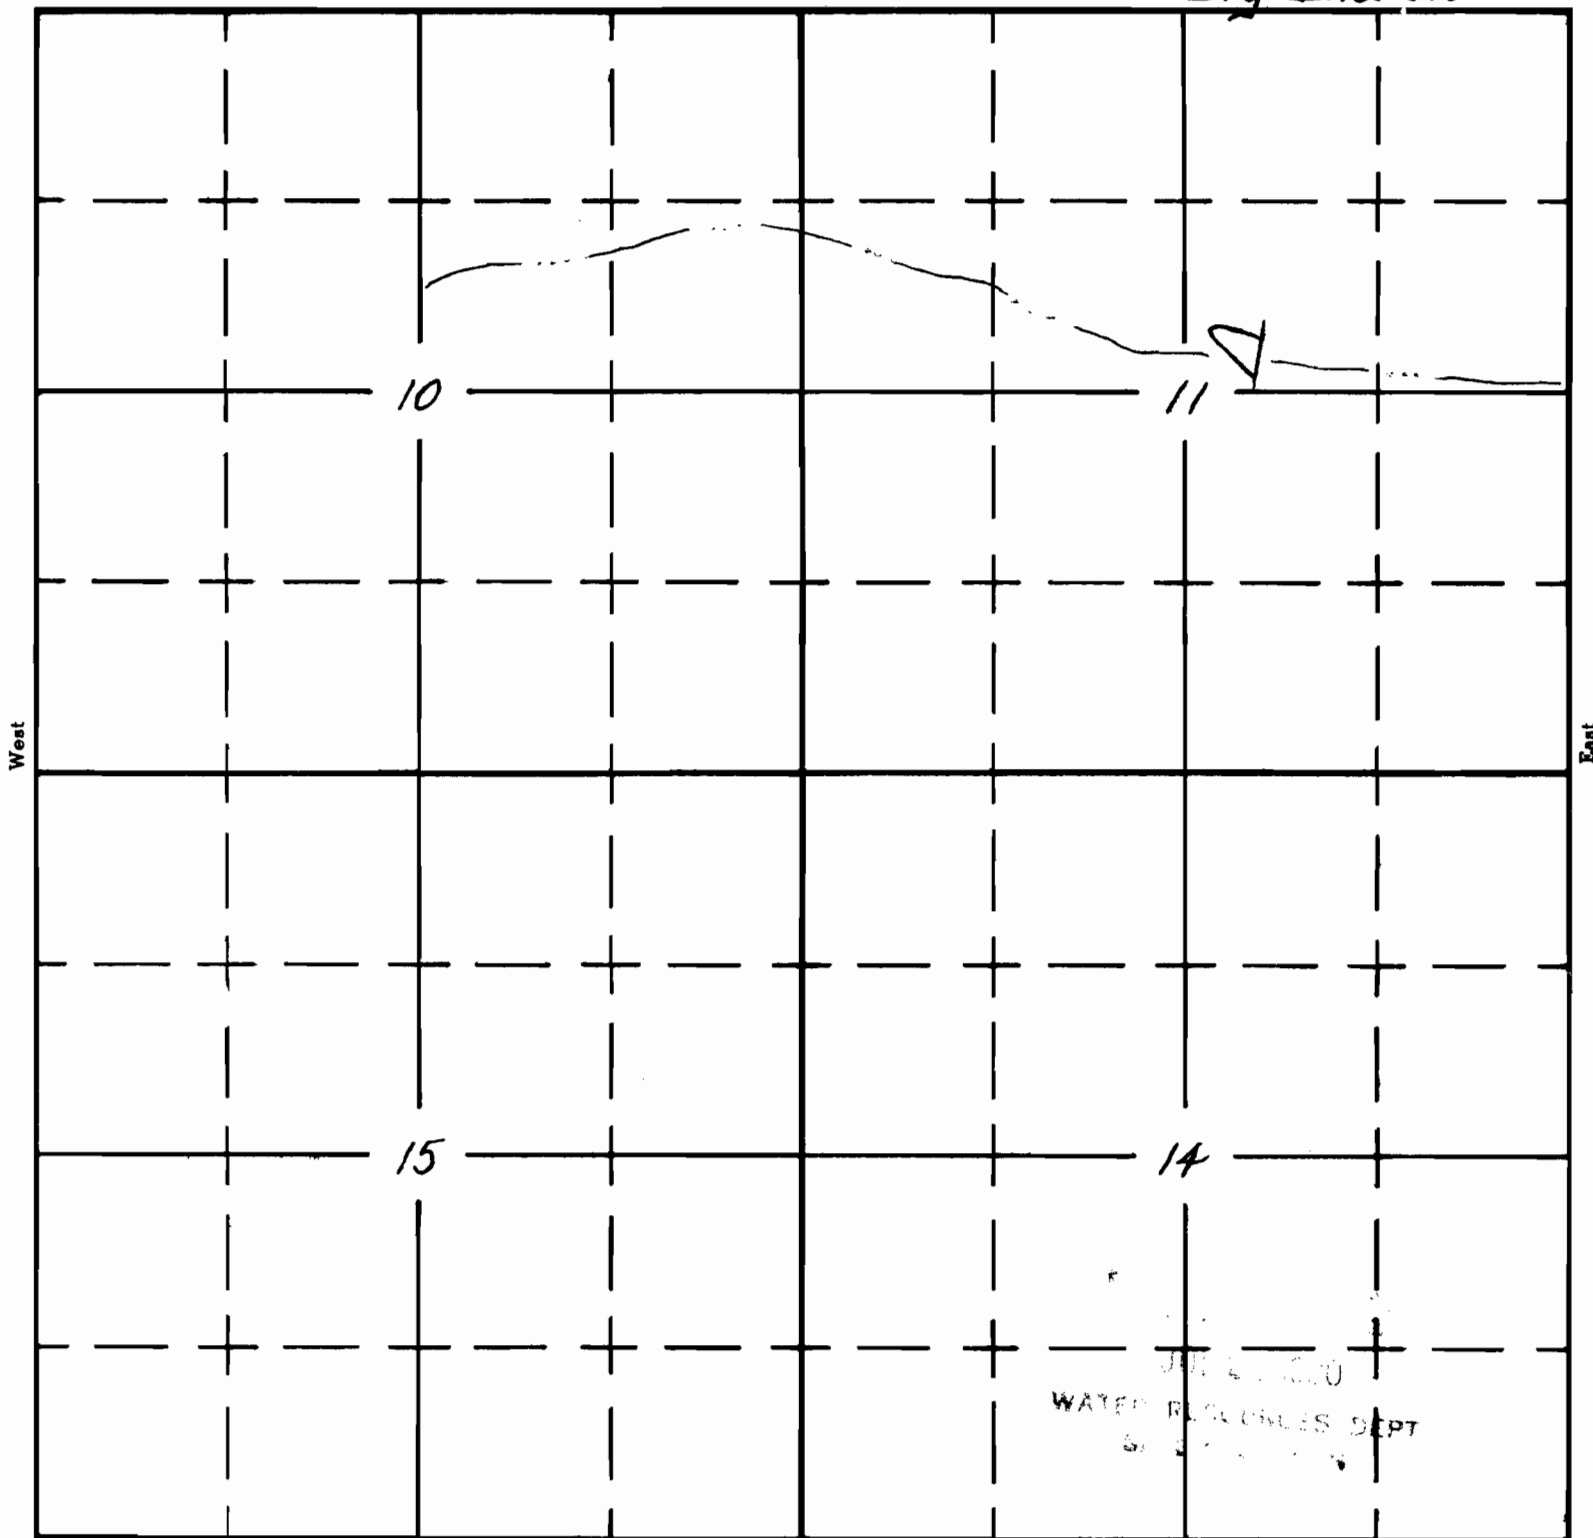

South

APPLICATION No.

PERMIT No.

JUL 21 2001
WATER RESOURCES DEPT
S.W. 1/4 NE 1/4