

SCALE 1:24 000



Application No. R 786 9  
 Permit No. ROAD LEGEND  
 71355

- Improved Road.....
- Unimproved Road.....
- Trail.....
- Interstate Route
- U.S. Route
- State Route


CONTOUR INTERVAL 40 FEET

1	3	3	1
			1
			2
			3
			4


QUADRANGLE LOCATION

1 Gaudin  
 2 Gaudin  
 3 Gaudin  
 4 Gaudin

71355

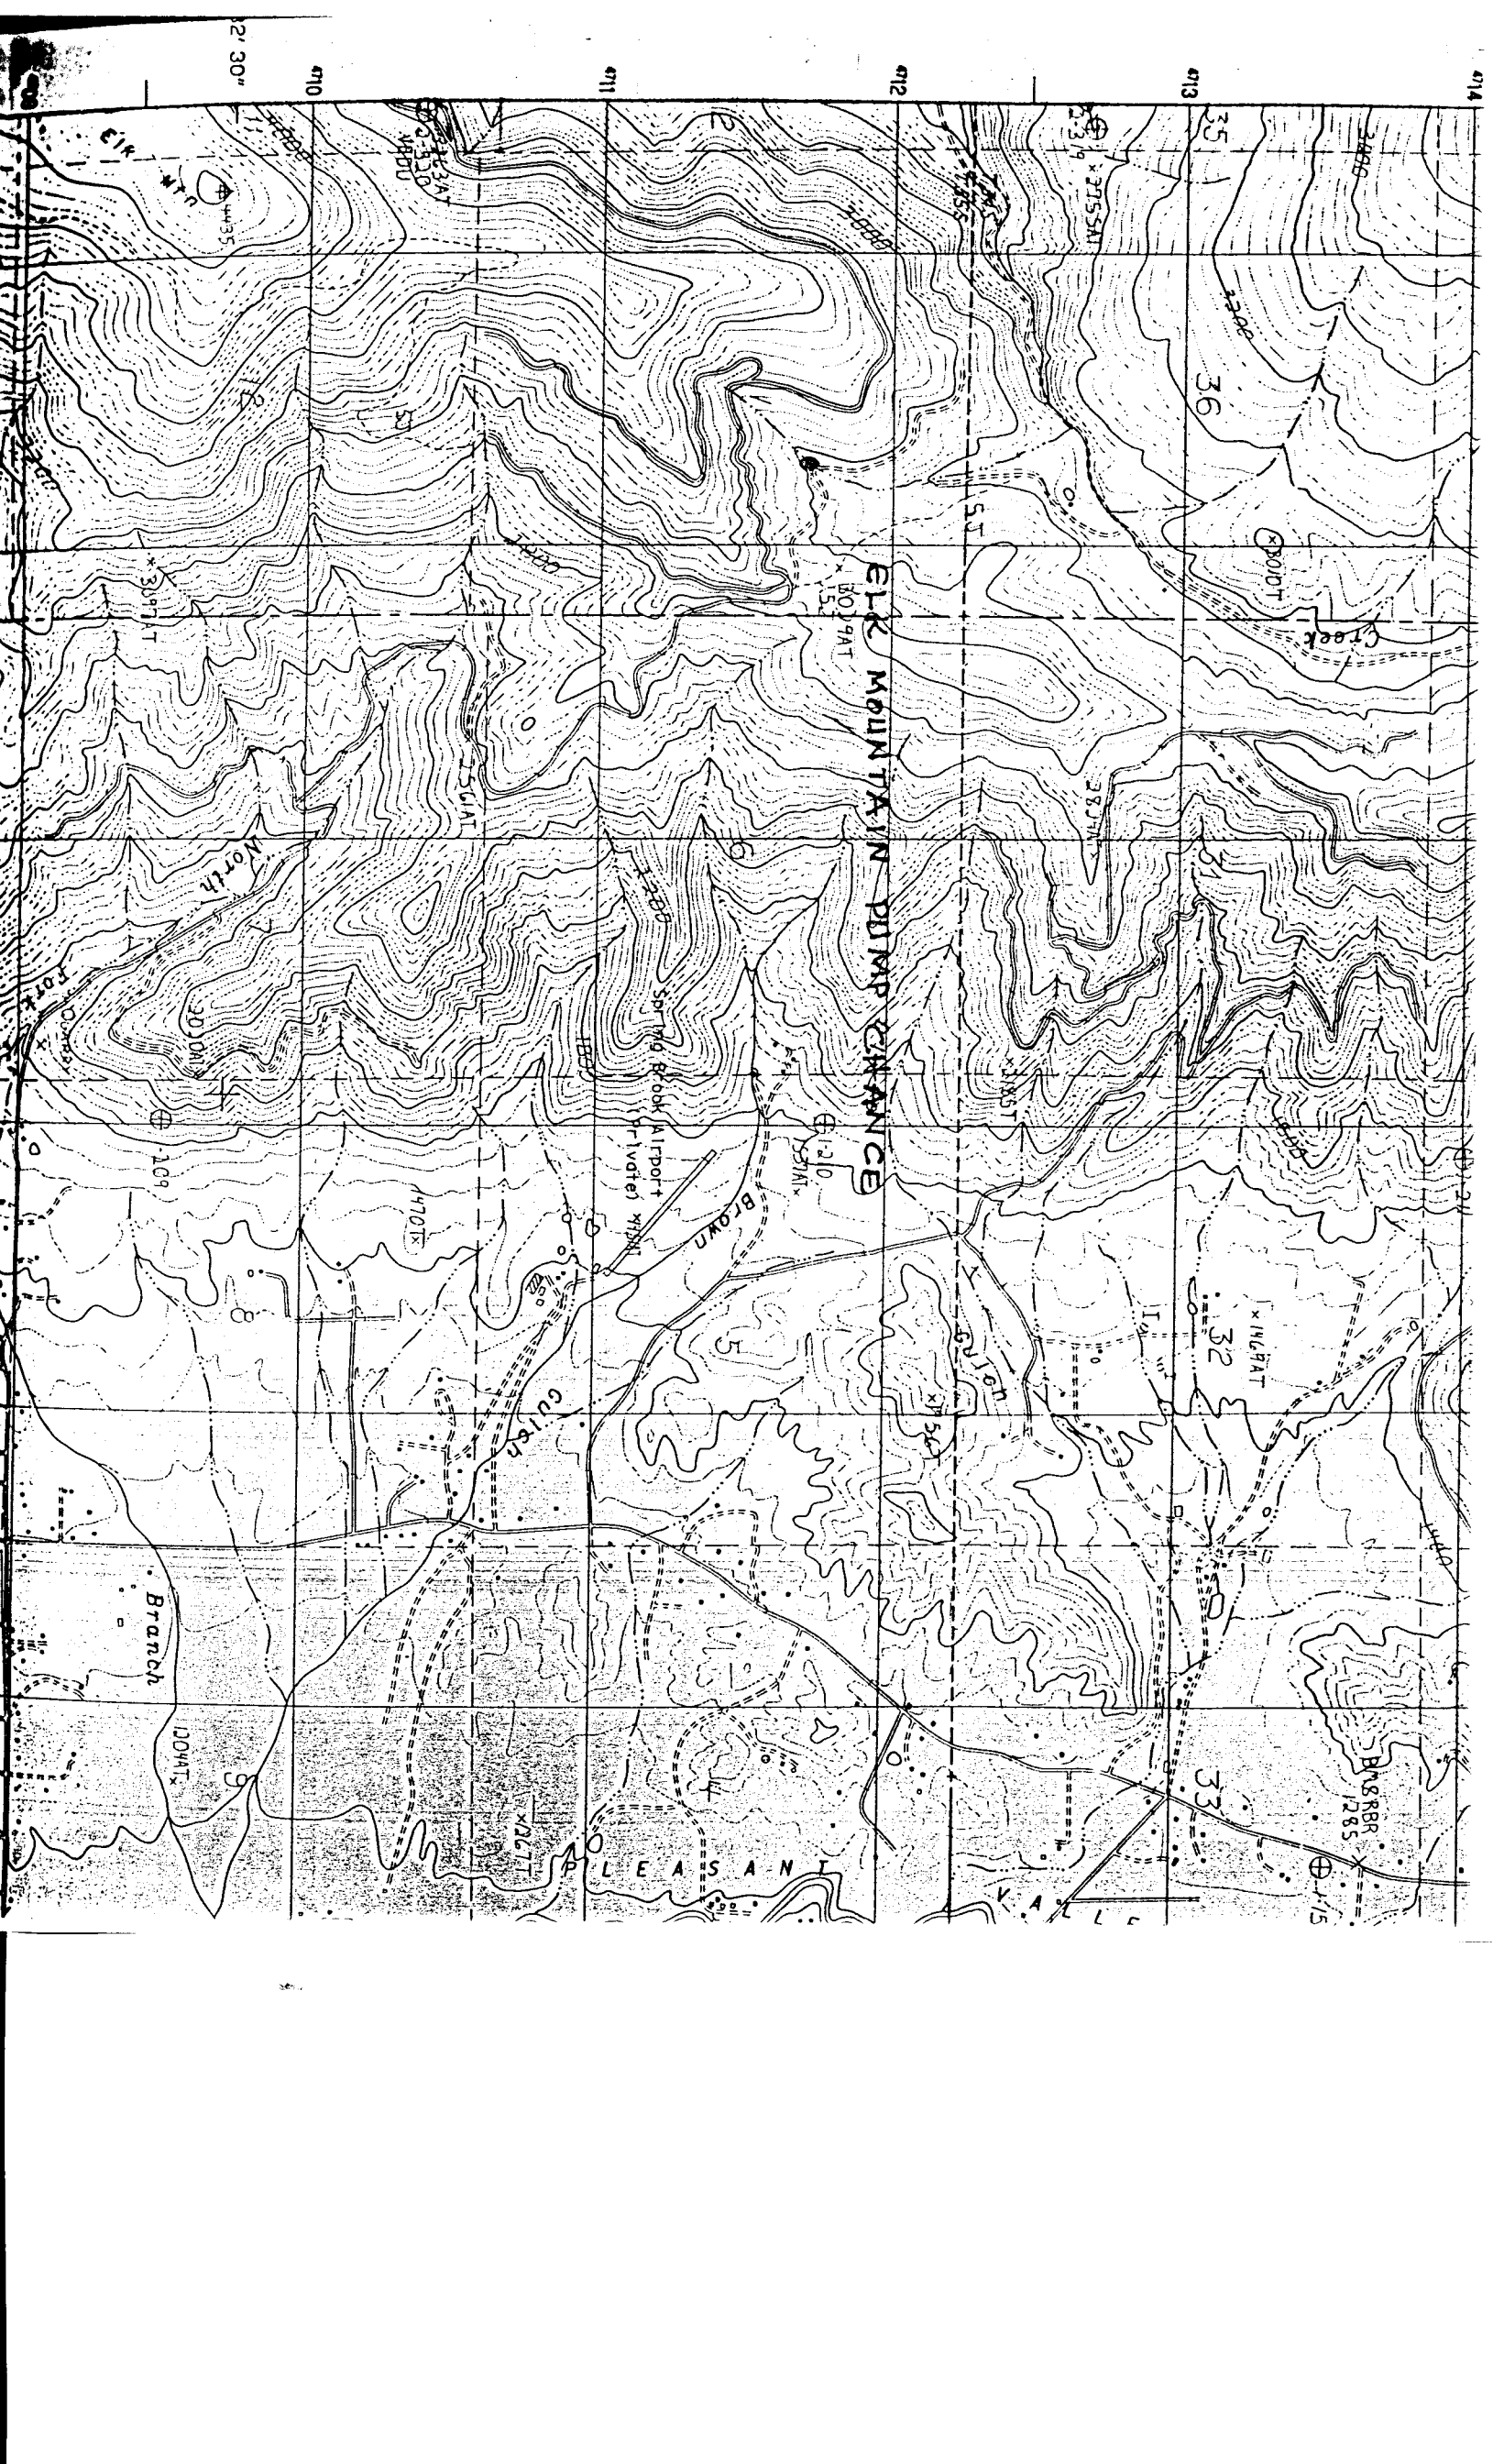




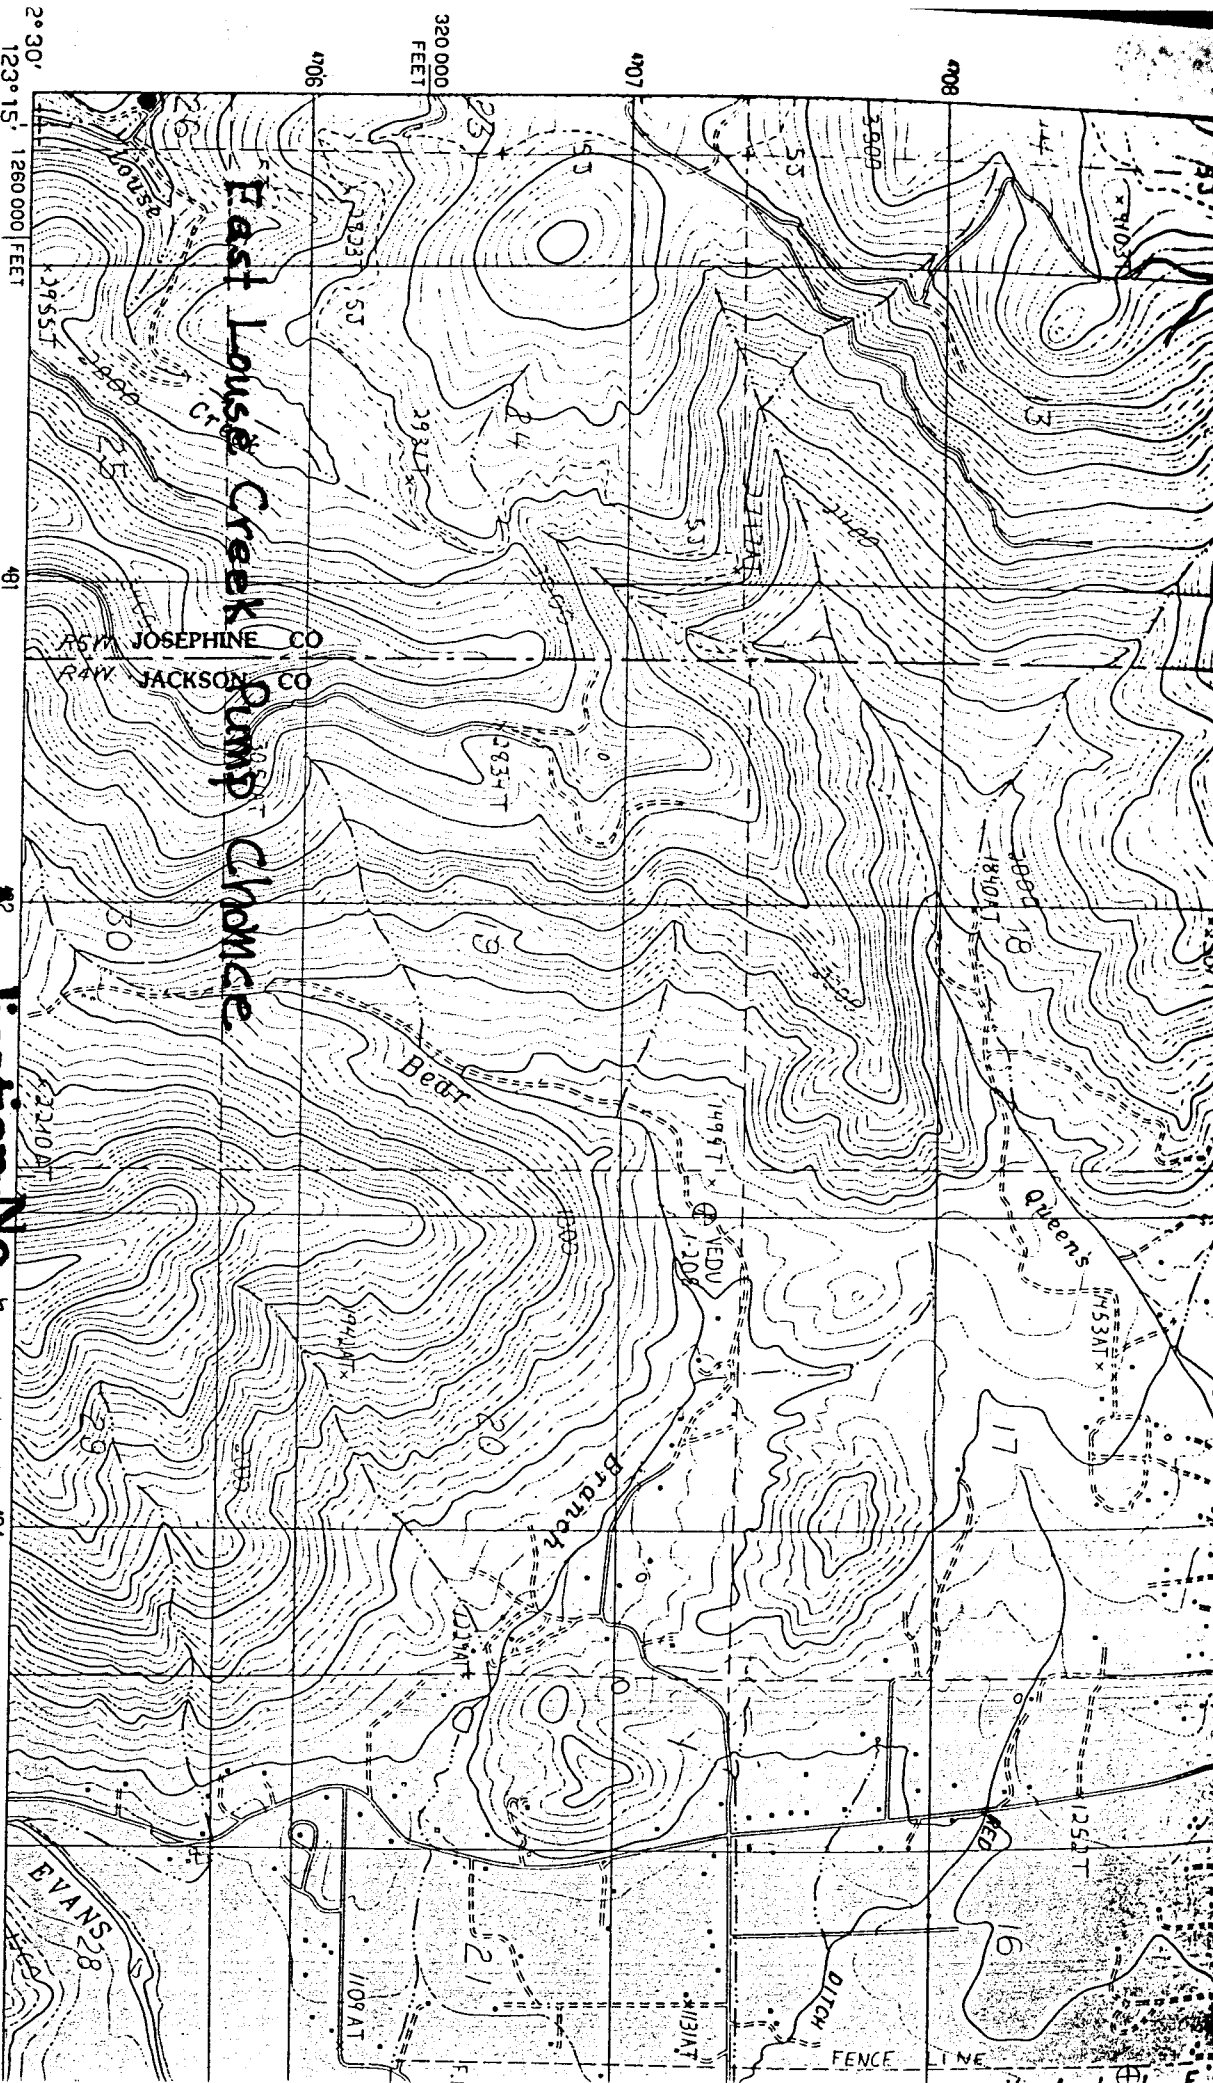

PRODUCED BY THE UNITED STATES GEOLOGICAL SURVEY  
 CONTROL BY .....  
 COMPILED FROM AERIAL PHOTOGRAPHS TAKEN .....  
 FIELD CHECKED: .....  
 PROJECTION: .....  
 GRID: 1000-METER UNIVERSAL TRANSVERSAL MERCATOR  
 UTM GRID DECLINATION: .....  
 1980 MAGNETIC NORTH DECLINATION: .....  
 VERTICAL DATUM: NATIONAL GEODETIC DATUM OF 1929  
 HORIZONTAL DATUM: .....  
 To place on the predicted North American Datum of 1983,  
 move the projection lines as shown by dashed corner ticks  
 (21 meters north / 96 meters east)  
 There may be private inholdings within the boundaries of any  
 Federal and State Reservations shown on this map


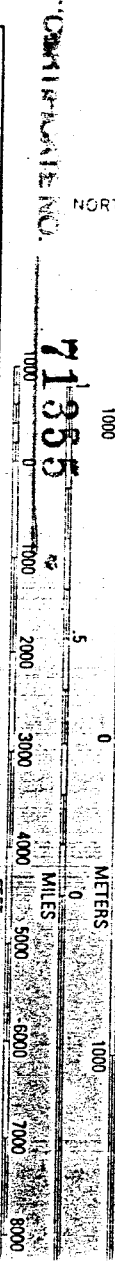

**PROVISIONAL MAP**  
 Produced from original  
 manuscript drawings. Infor-  
 mation shown as of date of  
 field work

**CONTOUR INTERVAL 40 FEET**  
 To convert meters to feet multiply by 3.2808  
 To convert feet to meters multiply by 0.3048