


T. 35S., R. 7W.

Hellgate Bridge

Application No. R-78780

Permit No.

71356

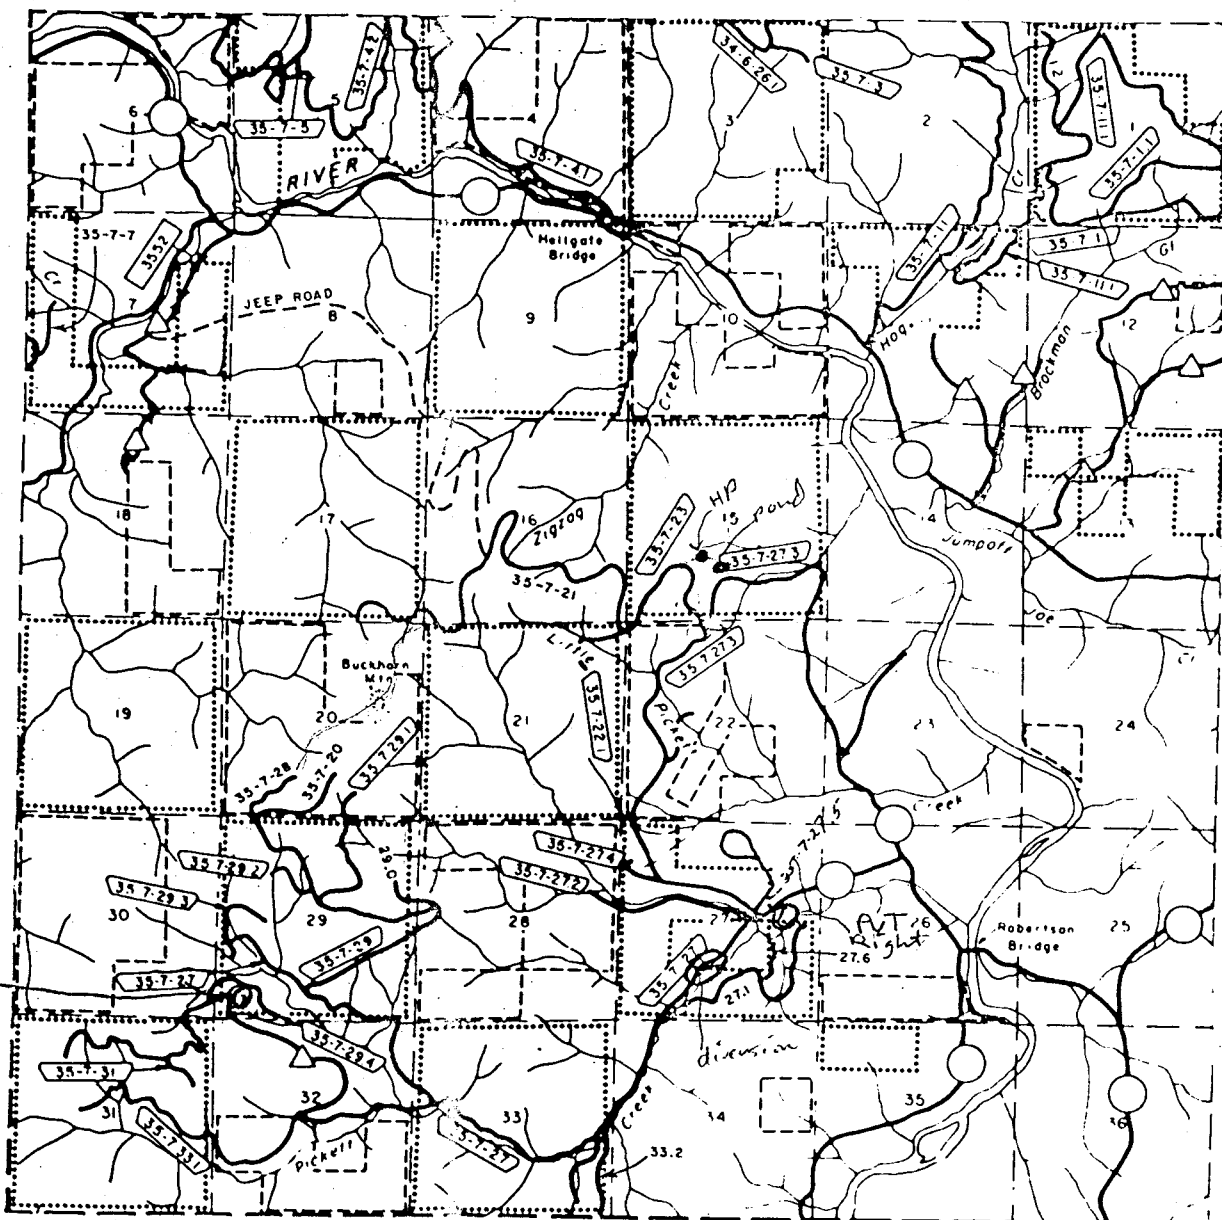


- ➔ sec 15 Troubridge Helipond + Troubridge pond
(an old mining operation - beautiful site - lets look up rights on it!)
Calice RMA current to 7/31/80
- sec 27 a ^{PWT} concrete dam - irrigation diversion
also a put water right on side creek I looked at 2 yrs ago
- sec 29 we should file for runoff of sec 29 in case we build the helipond.

AMPHICATENO 51446

SCALE 1:24000
Application No R-78900

OREGON-JOSEPHINE CO.
7.5 MINUTE SERIES (TOPOGRAPHIC)

123° 30' 45" W
457 458 1190 000 FEET

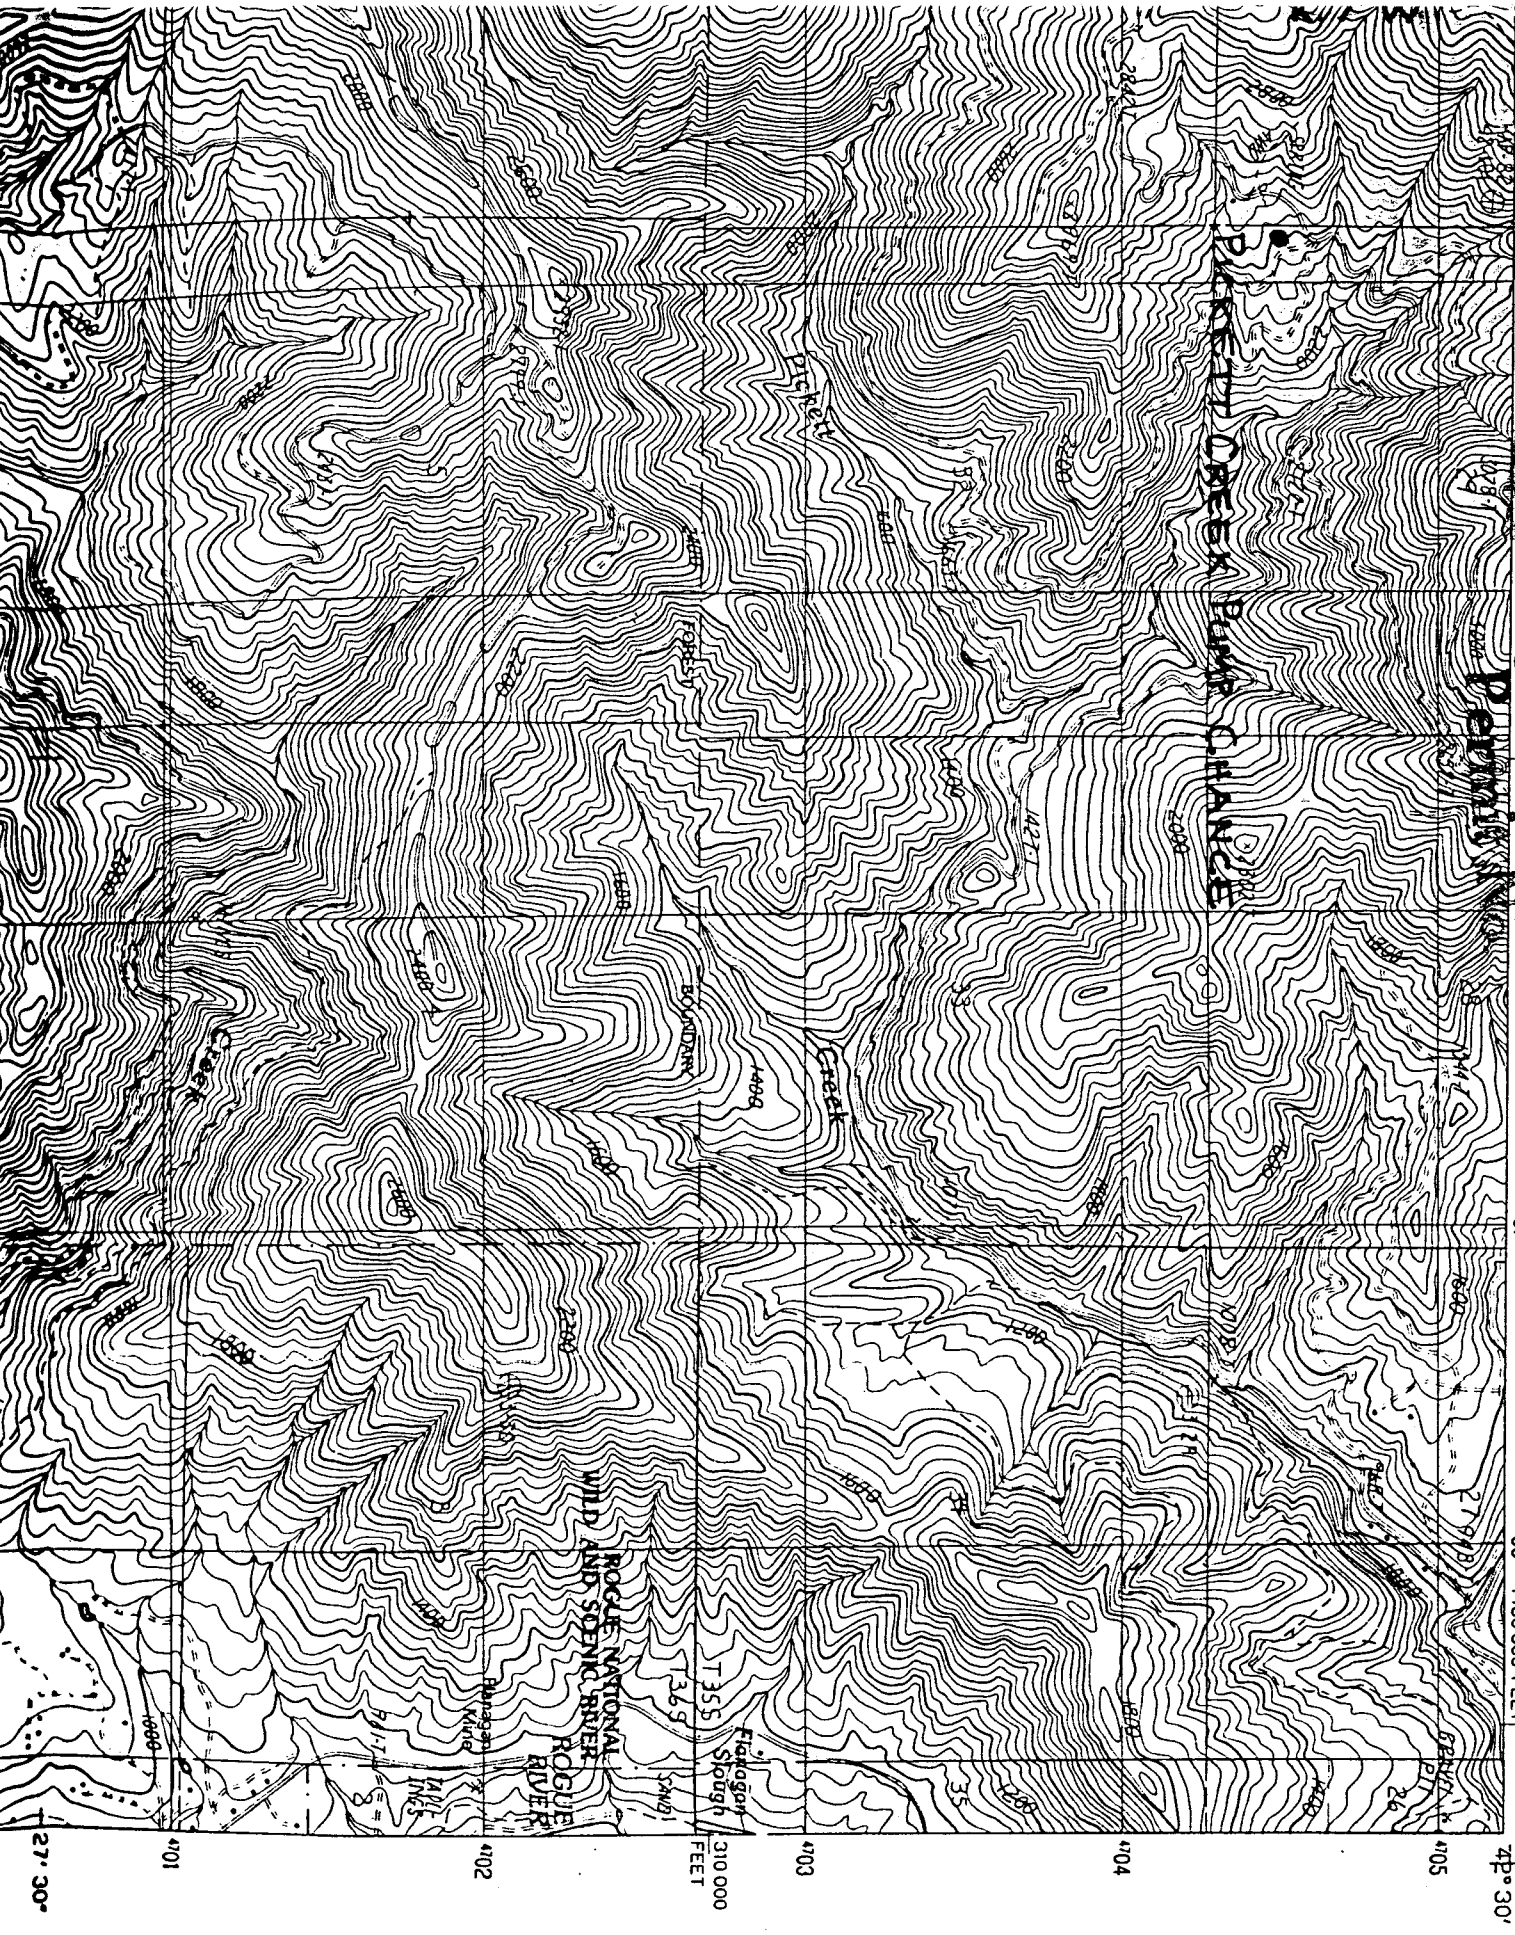

27° 30'

401

402

403

404

405

457 458


310 000 FEET

ROGUE NATIONAL
WILD AND SCenic RIVER
ROGUE RIVER


Fork
Slough

Creek

ROGUE RIVER

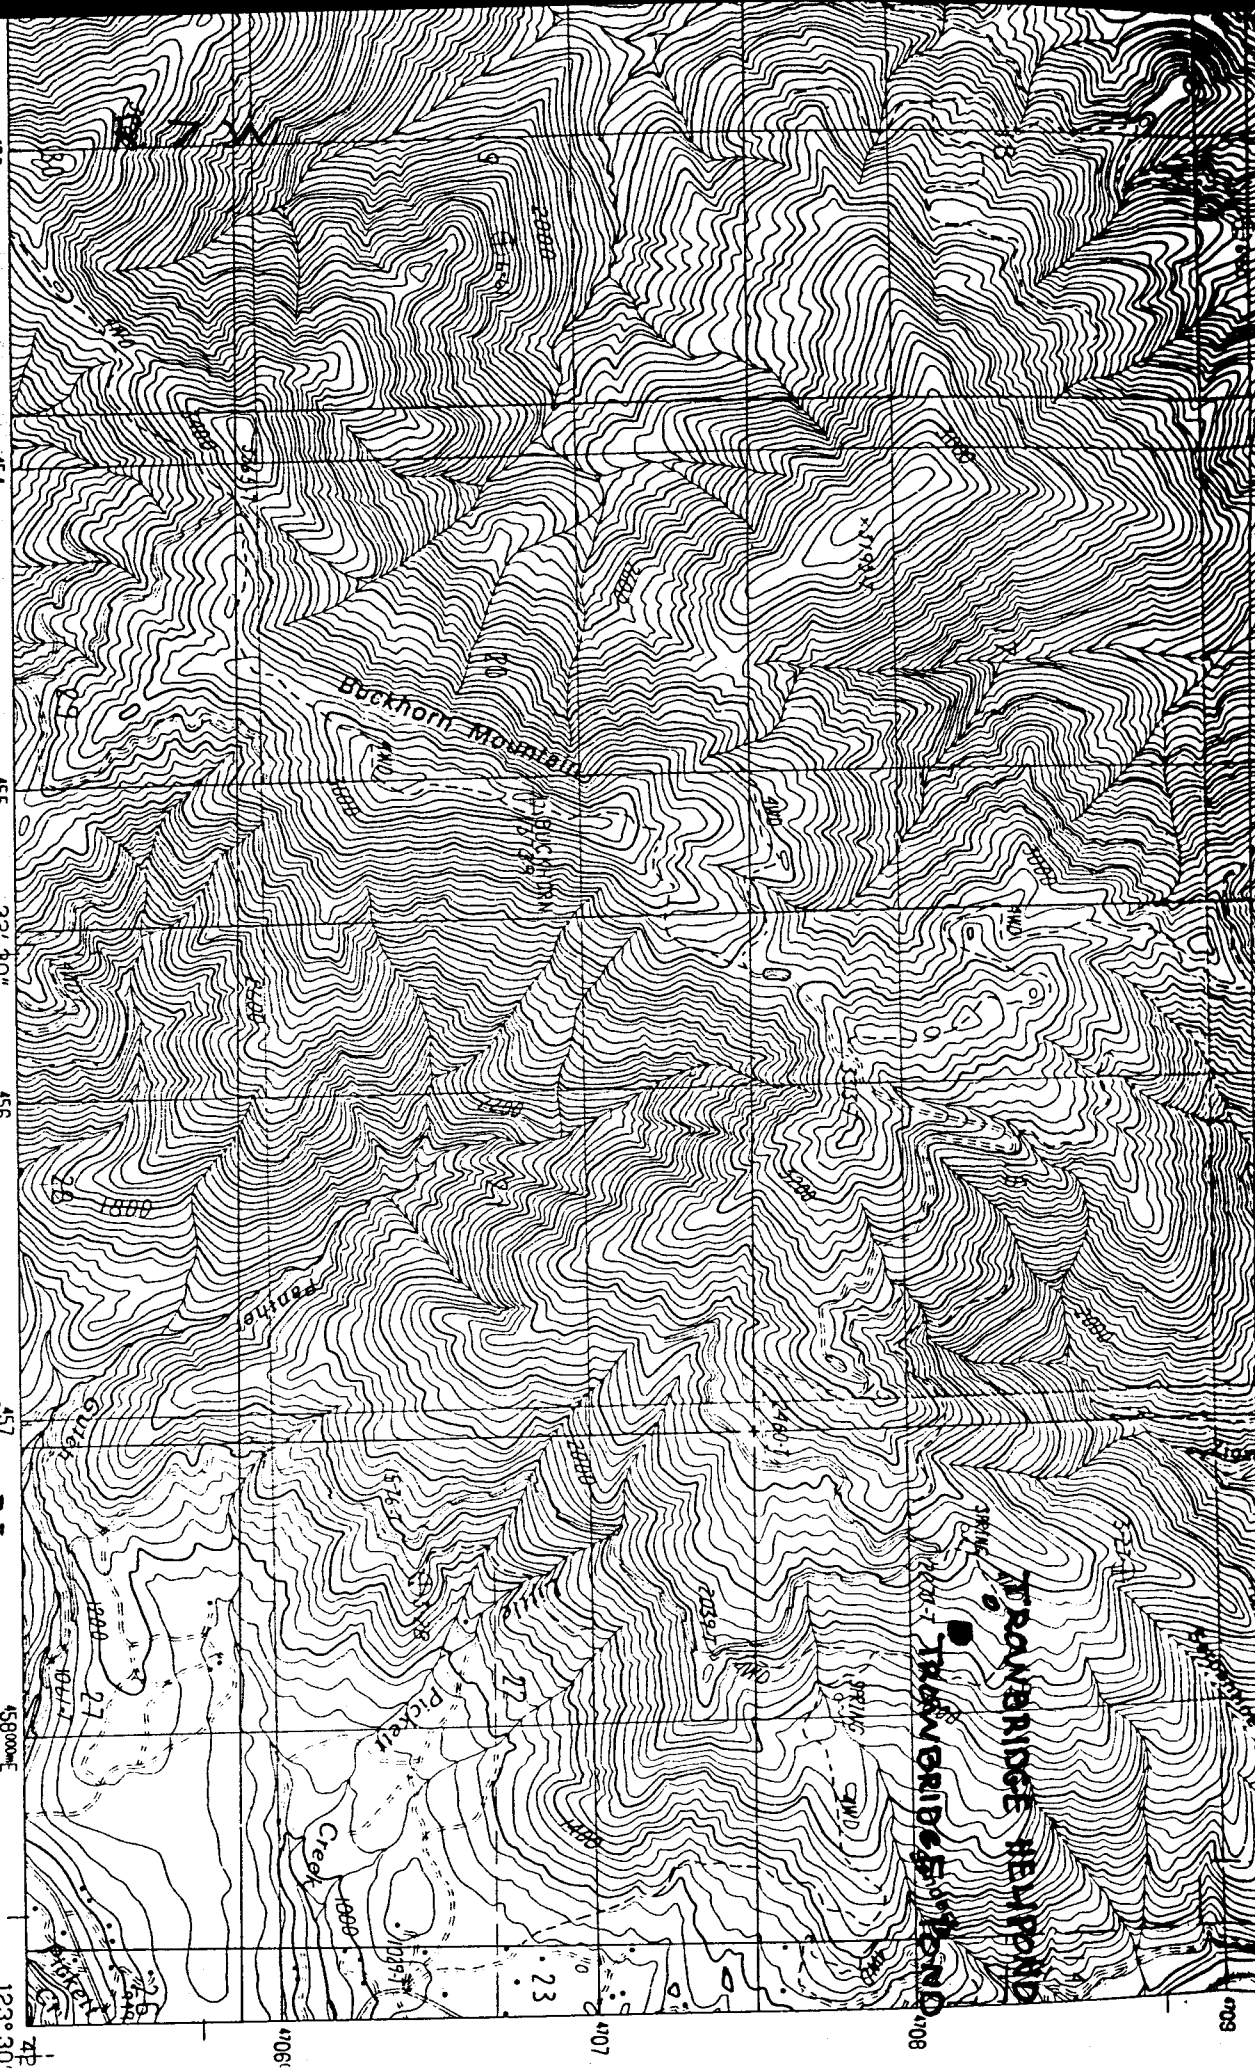

SCALE 1:24 000

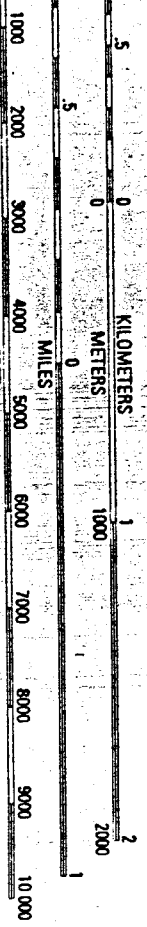


CONTOUR INTERVAL 40 FEET

To convert feet to meters multiply by .3048
To convert meters to feet multiply by 3.2808

INTERIOR—GEOLOGICAL SURVEY, RESTON, VIRGINIA—1988

QUADRANGLE LOCATION

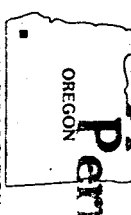

Application No. R-78780
Permit No. 71356

1	2	3	1 Bunker Creek
			2 Mount Reuben
			3 Glendale
			4 Mount Peavine
4			5 Merlin

ROAD LEGEND
 Improved Road
 Unimproved Road
 Trail

Interstate Route U.S. Route State Route

GALICE, OREGON