


SCALE 1:24 000

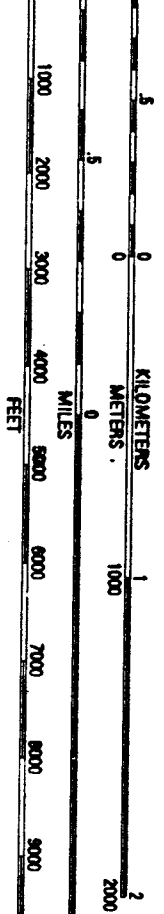

CONTOUR INTERVAL 40 FEET

To convert meters to feet multiply by 3.2808
To convert feet to meters multiply by 0.3048

1	2	3	1
4	5	6	2
7	8	9	3
			4
			5
			6
			7
			8
			9


- 1 Sarna
- 2 Murphy Mtn.
- 3 Murphy
- 4 Holland
- 5 Williams
- 6 Takilma
- 7 Oregon Caves
- 8 Grayback Mtn.

- ROAD LEGEND
- Improved Road.....
 - Unimproved Road.....
 - Trail.....
 - Interstate Route
 - U.S. Route
 - State Route


KERBY PEAK, OREG.

DP/VIC/10/11/12/99/100

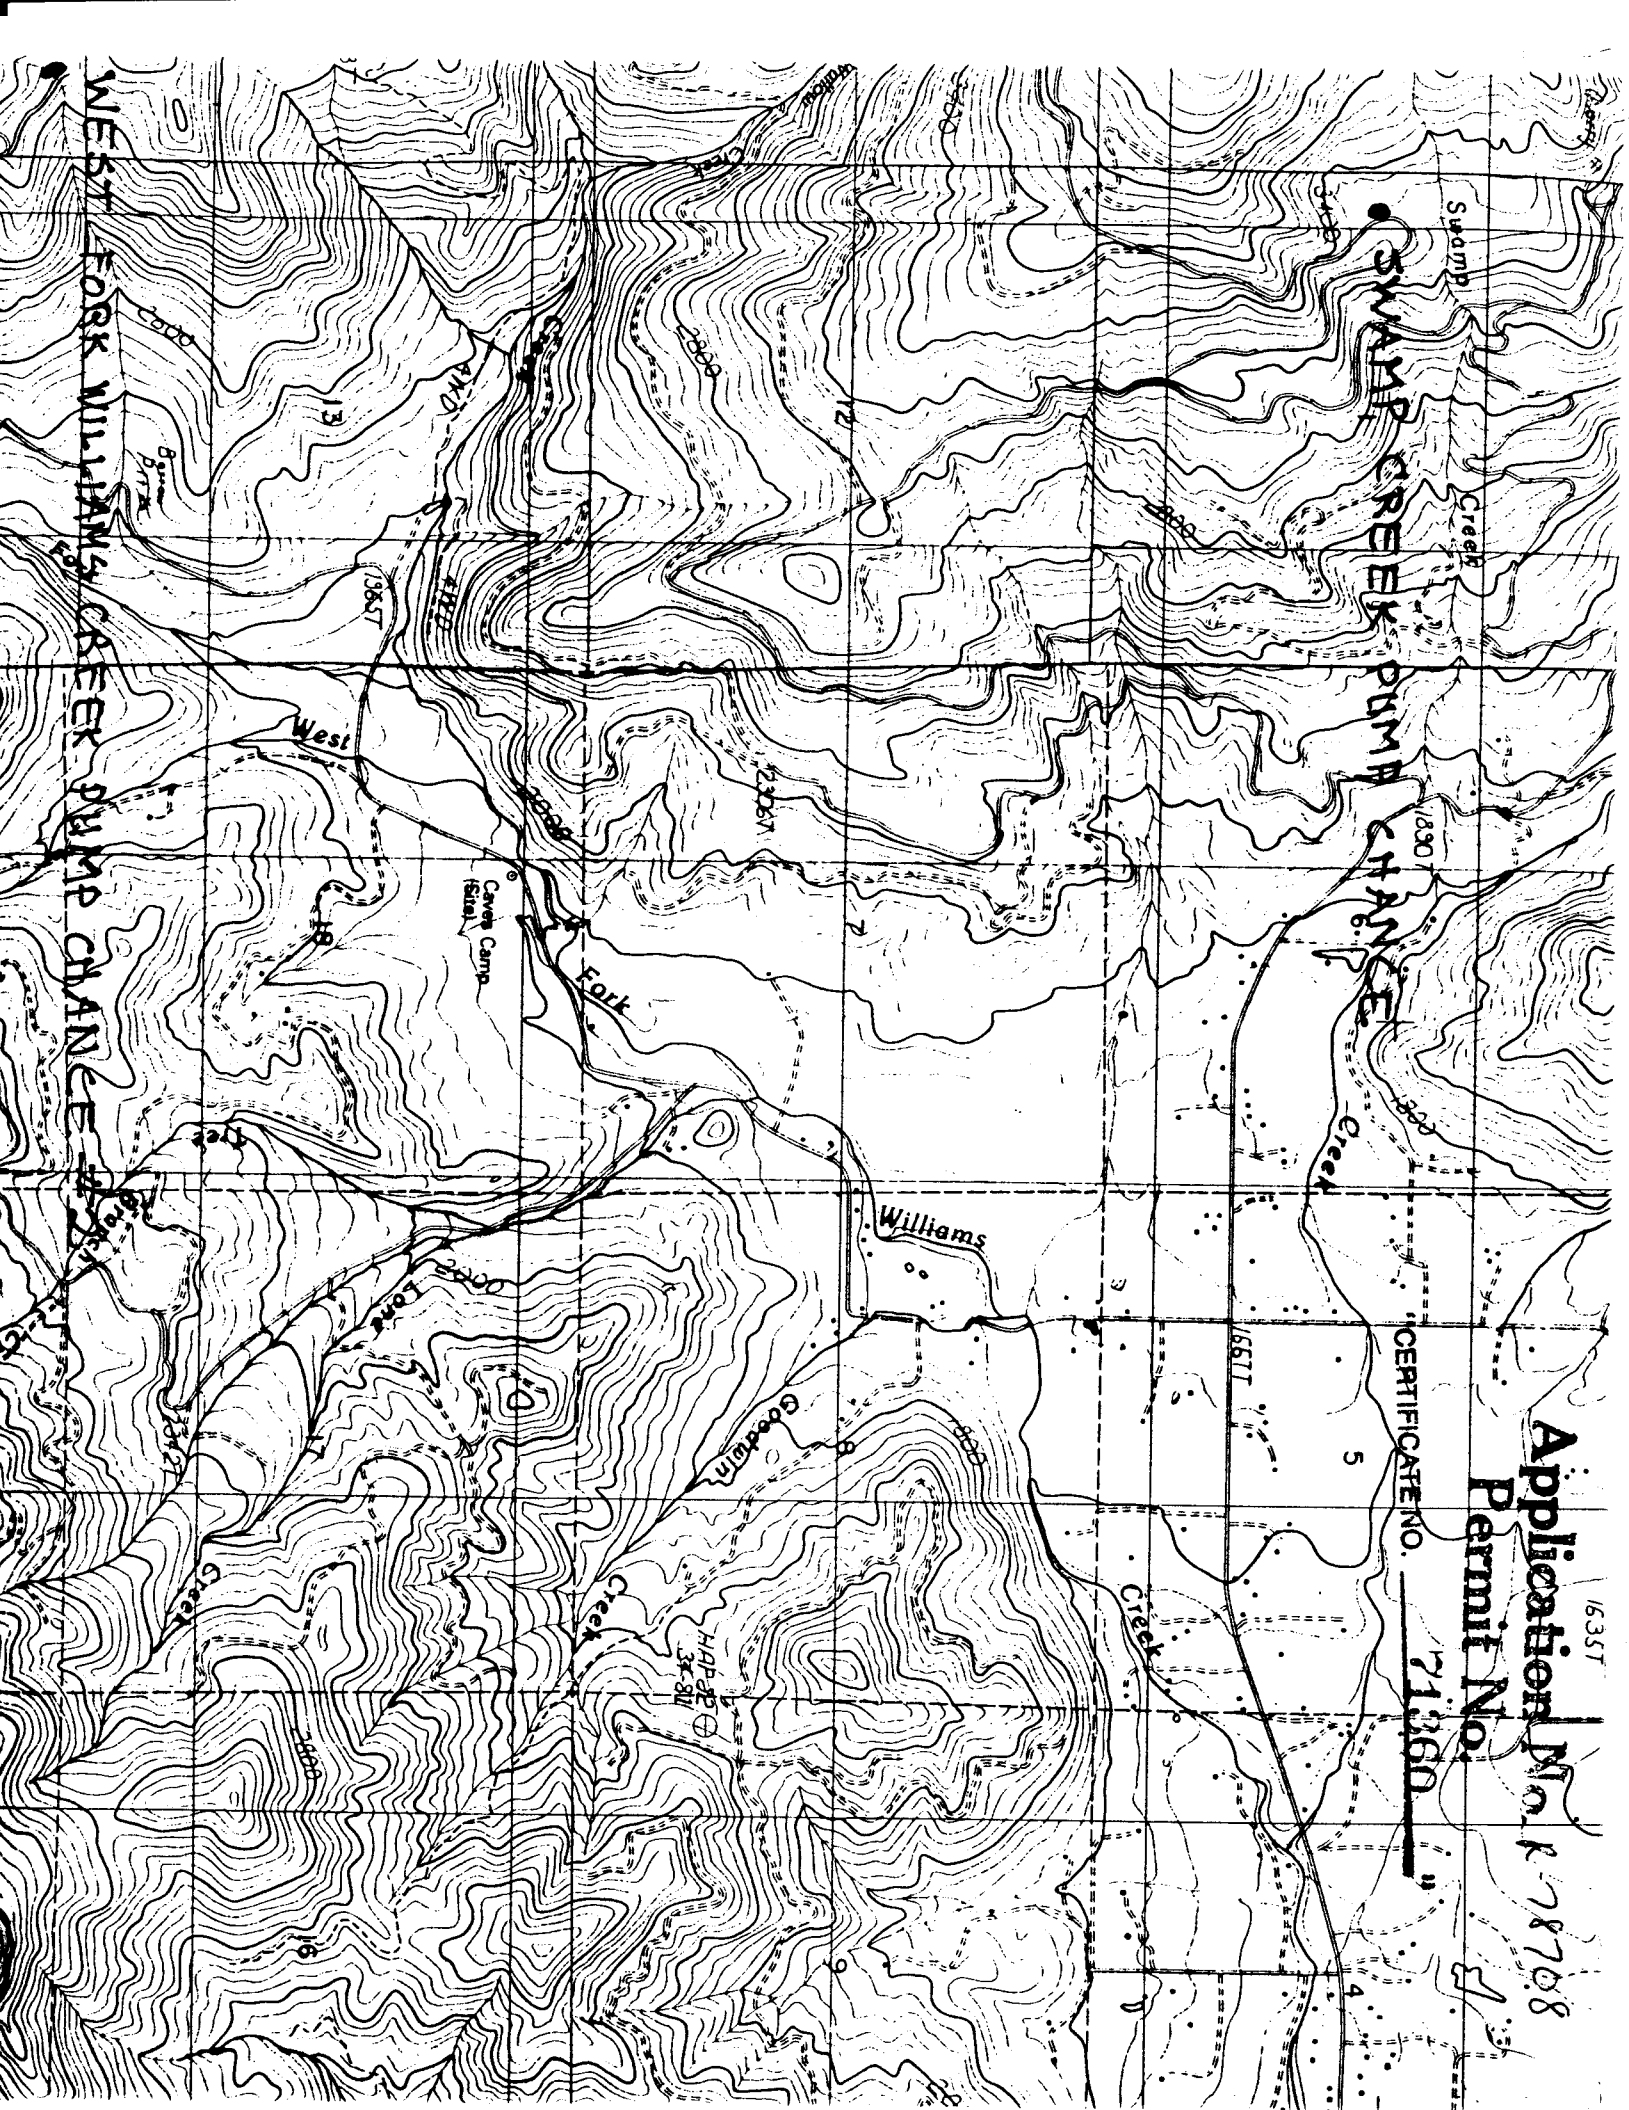


CERTIFICATE NO. 71360




PRODUCED BY THE UNITED STATES GEOLOGICAL SURVEY


SCALE 1:24 000

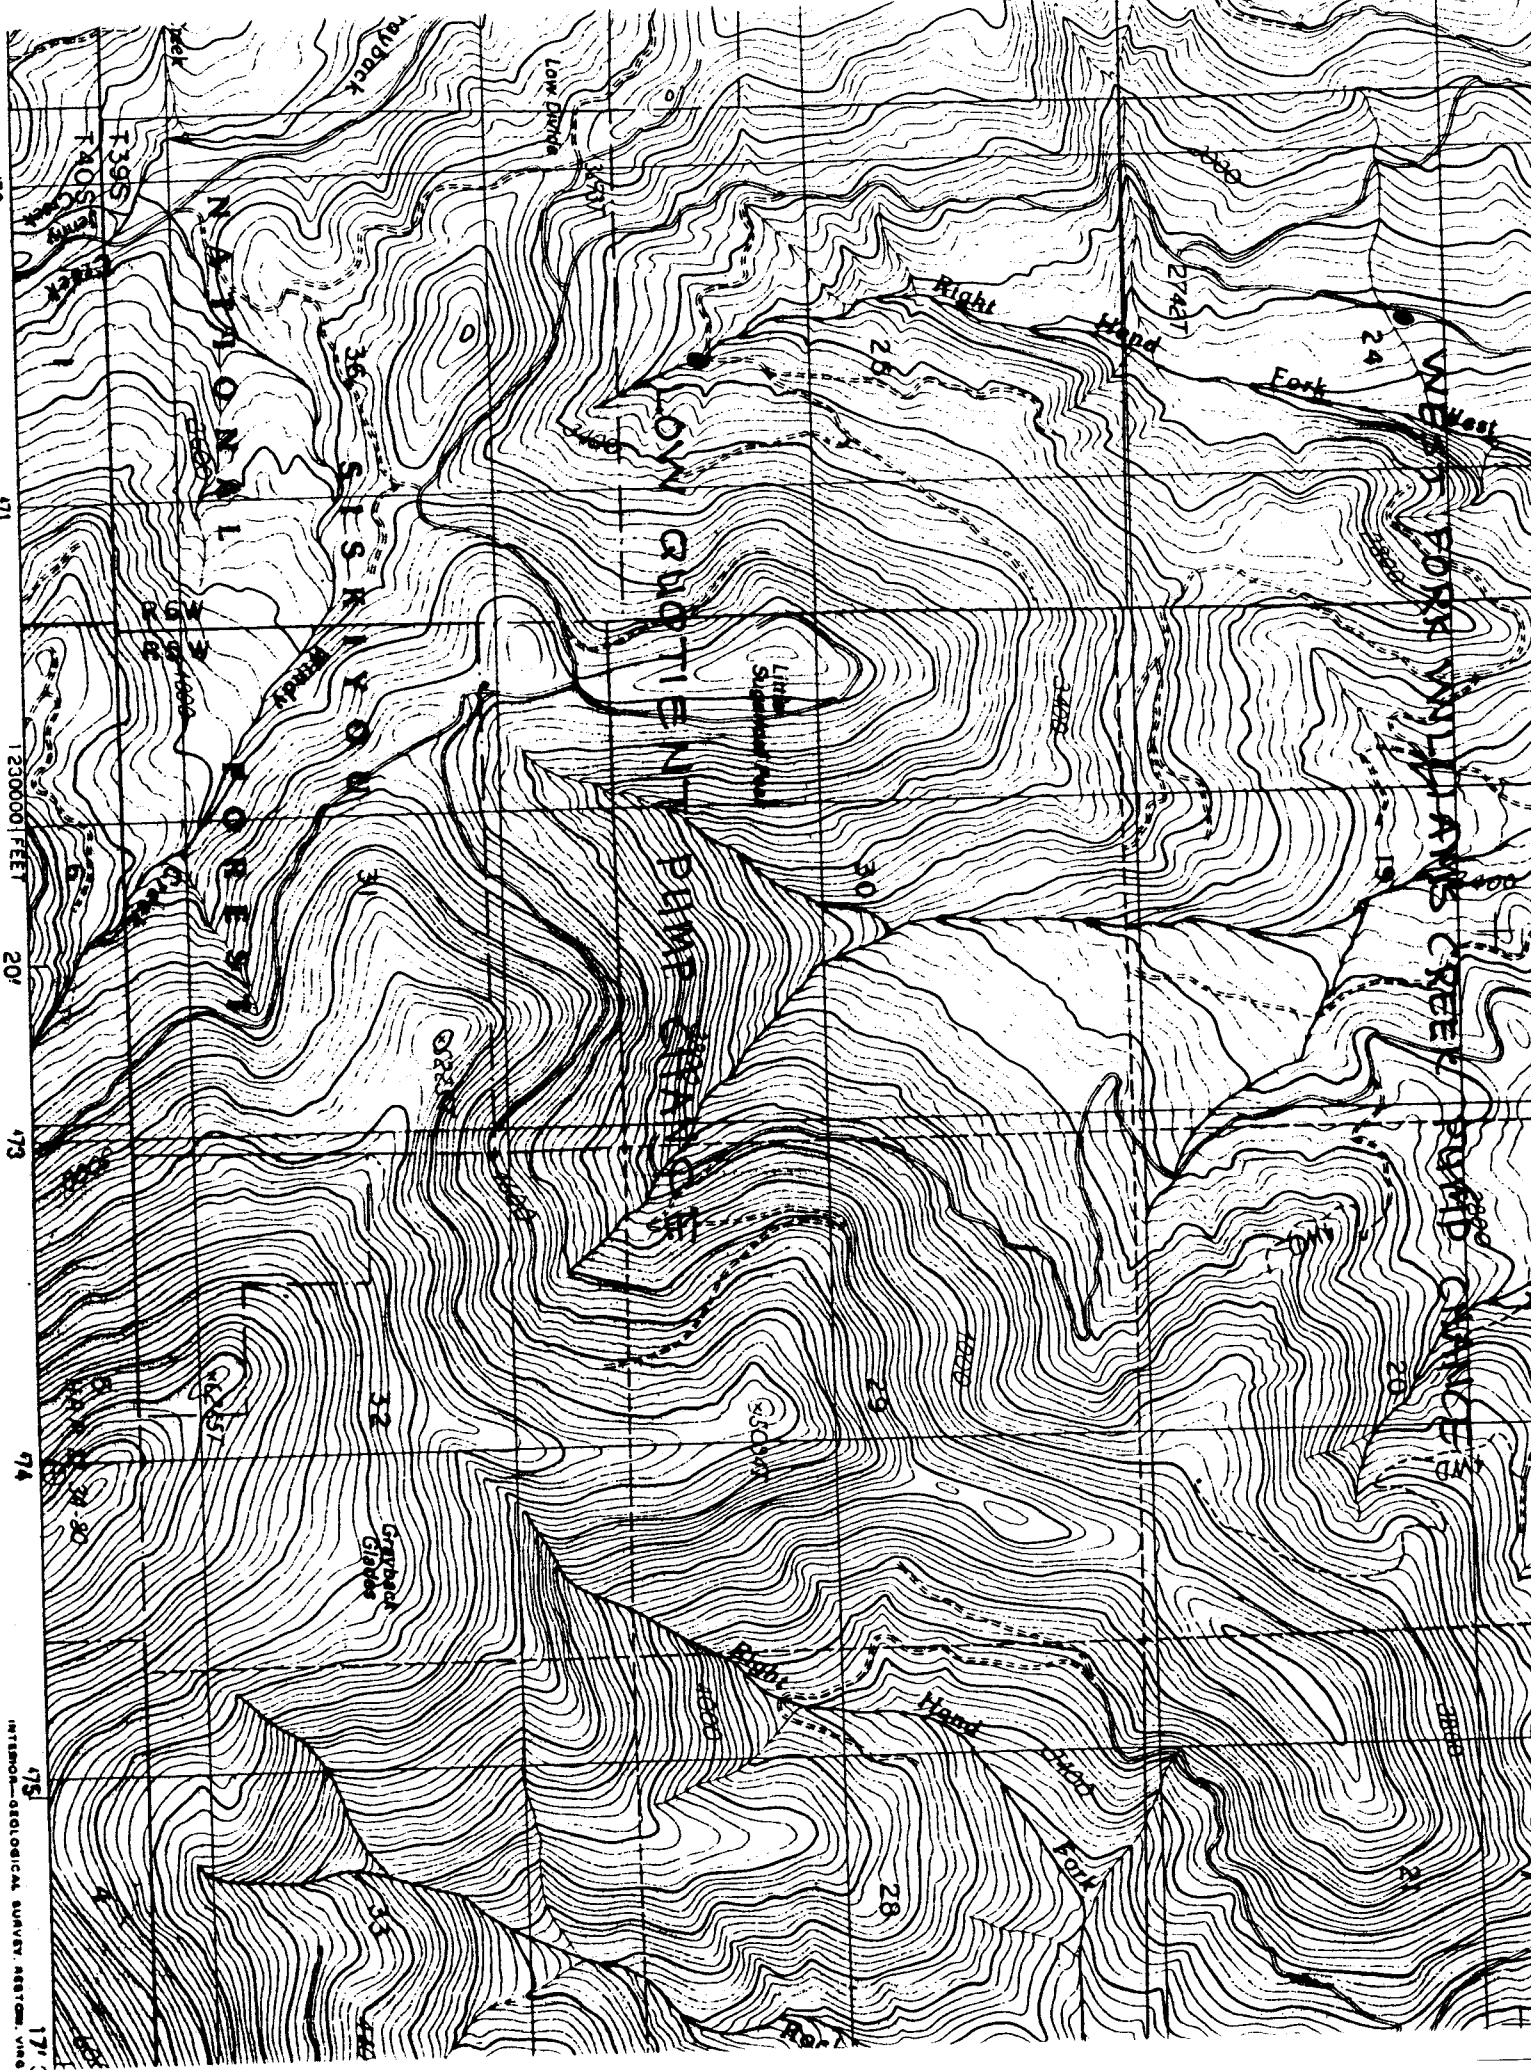

