



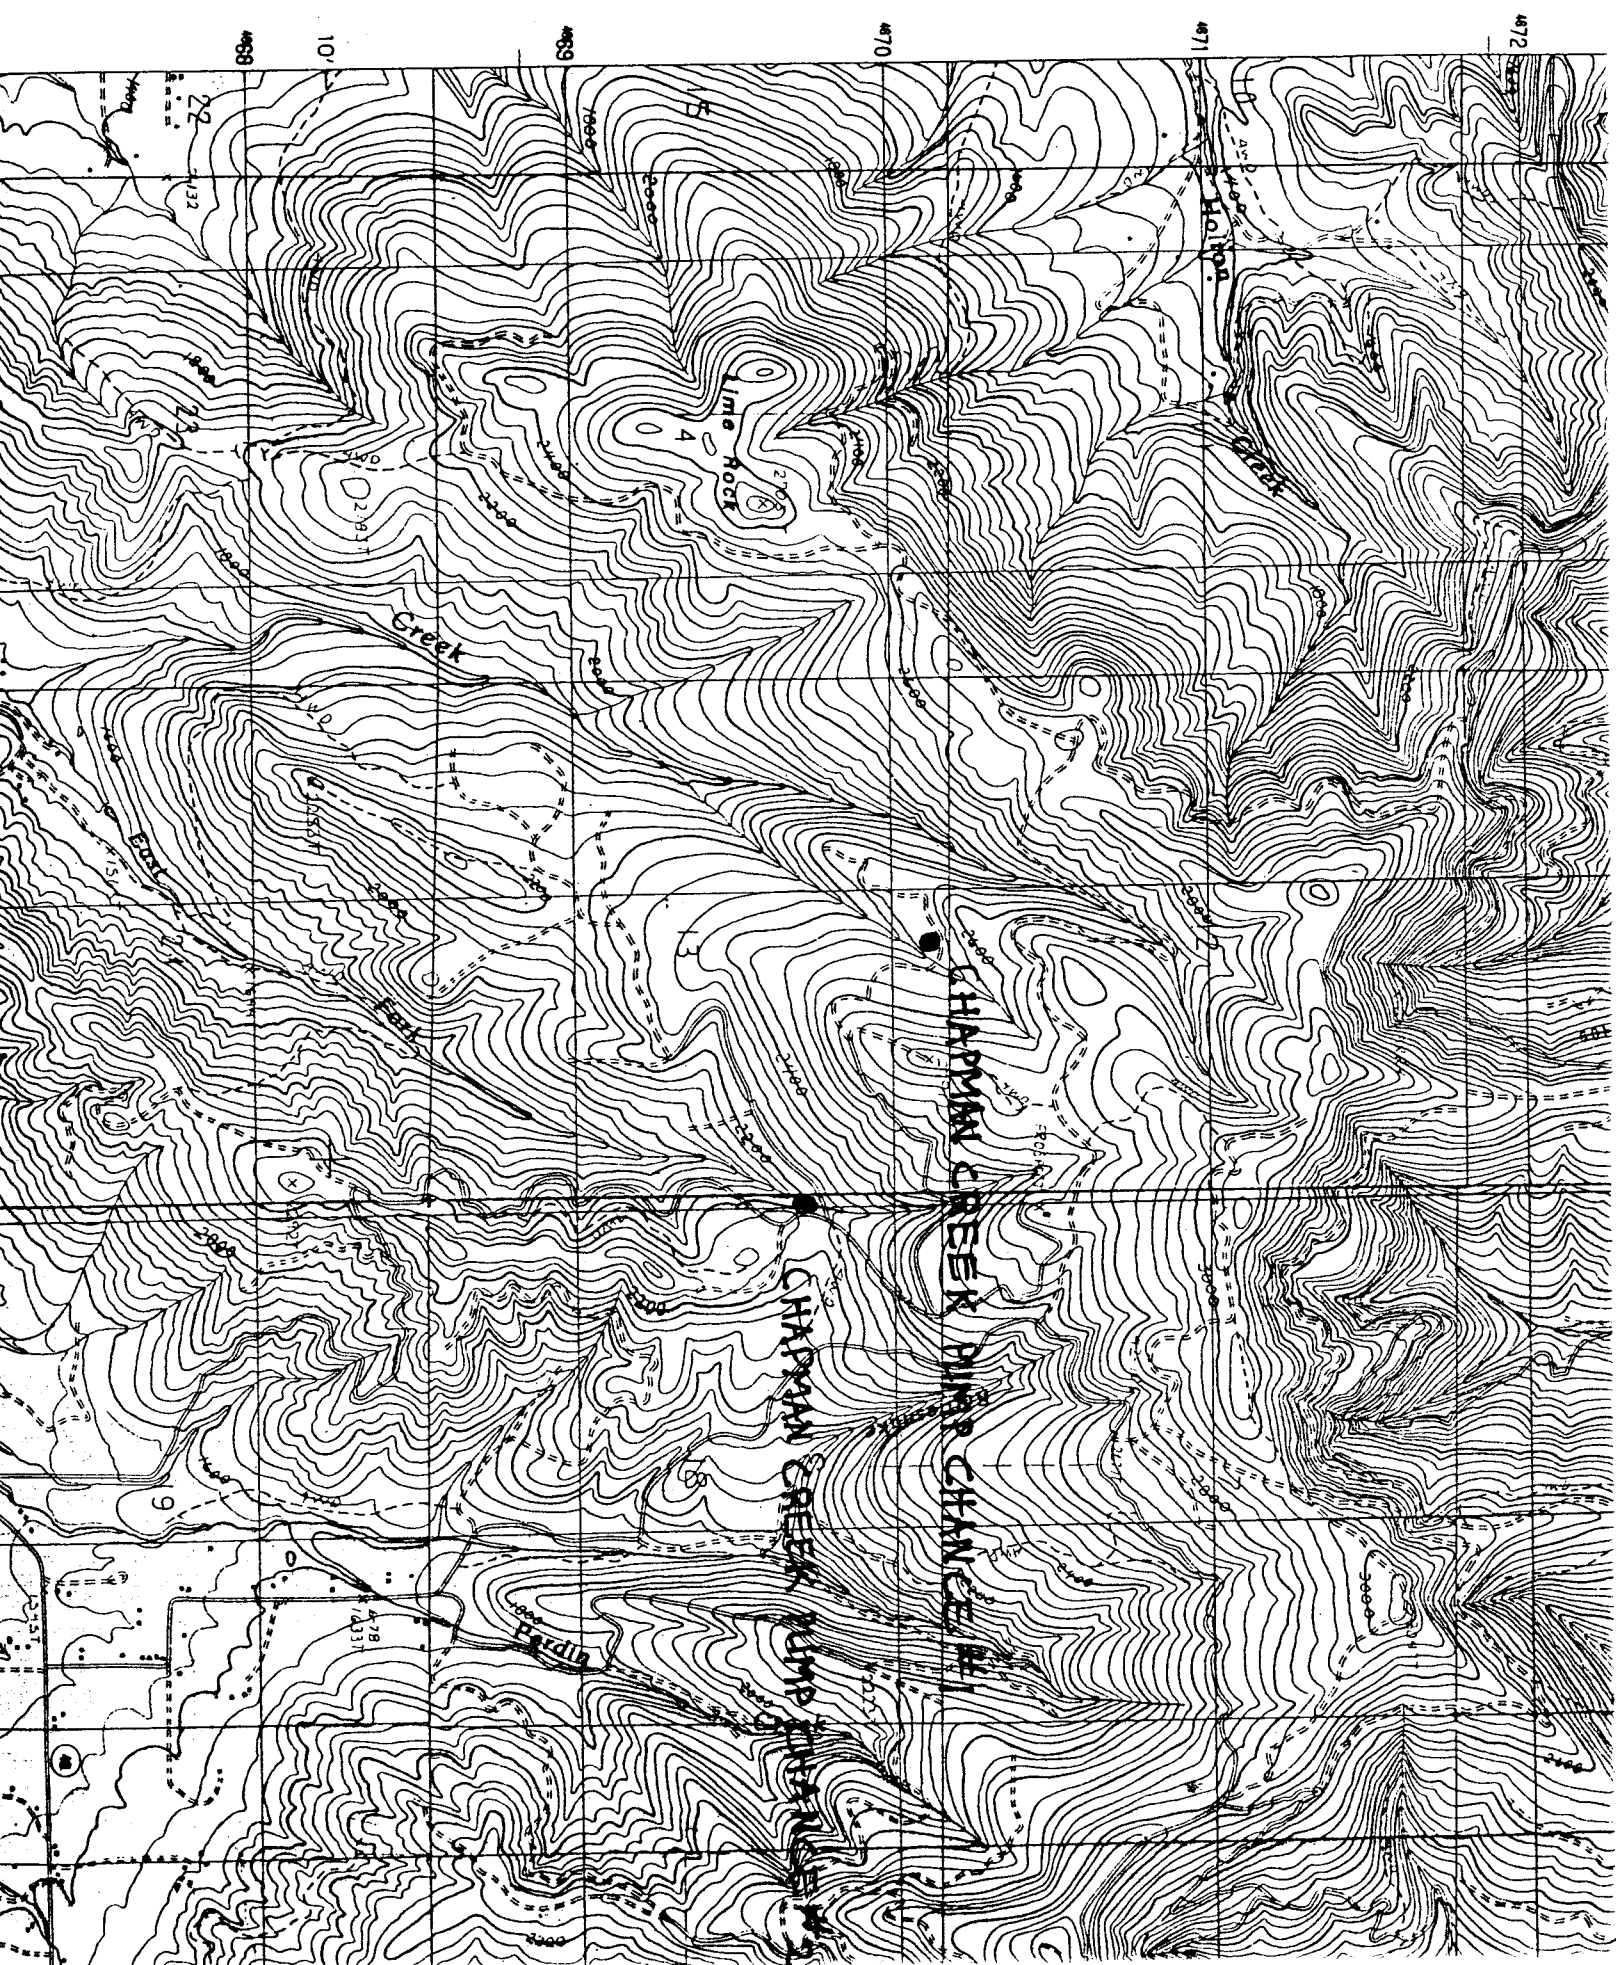

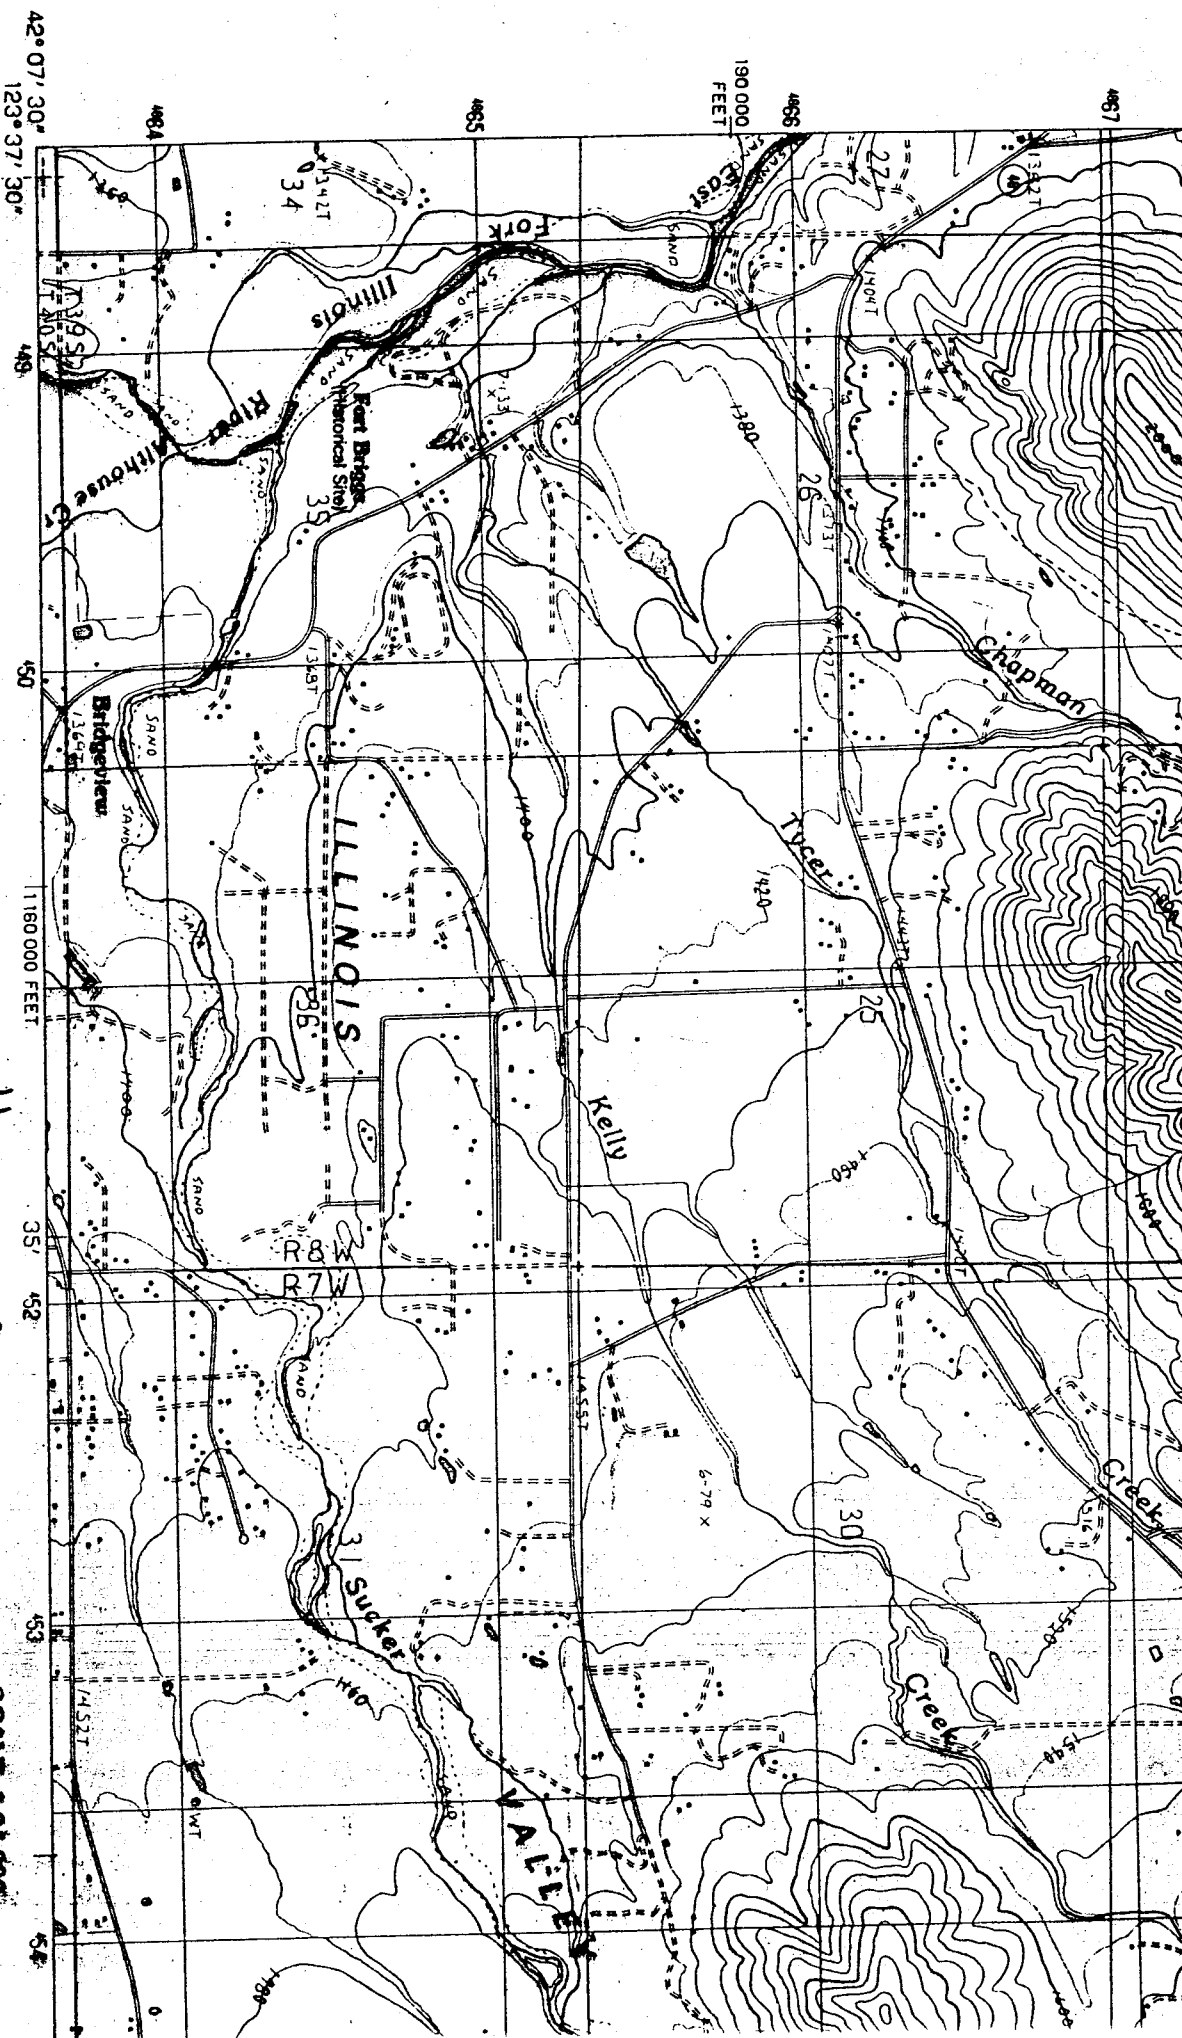

PRODUCED BY THE UNITED STATES GEOLOGICAL SURVEY
CONTINUED BY USGS AND NOS/NOAA
CORRECTED FROM AERIAL PHOTOGRAPHS TAKEN 1968
FIELD CHECKED 1984
MADE EDITED (1988)
PROJECTION LAMBERT CONFORMAL CONIC

(28 meters north and 96 meters east). There may be private holdings within the boundaries of any Federal or State reservations shown on this map. No distinction made between houses, barns, and other buildings.

CERTIFICATE NO.

HOLLAND QUADRANGLE

SCALE 1:24 000

71362

NORTH

PROVISIONAL MAP

Application No. 1088

Permit No. 75712

Produced from original manuscript drawings. Information shown as of date of photography.

CONTOUR INTERVAL 40 FEET

SUPPLEMENTARY CONTOUR INTERVAL 20 FEET

METERS

FEET

MILES

To convert feet to meters multiply by .3048

To convert meters to feet multiply by 3.2808

THIS MAP COMPLETES WITH NATIONAL MAP ACQUIREMENT FOR SALE BY U.S. GEOLOGICAL SURVEY

DRAWN BY GEORGE A. STROUD AND BENJAMIN L. WILSON