



Application No. 88832  
Permit No. 177

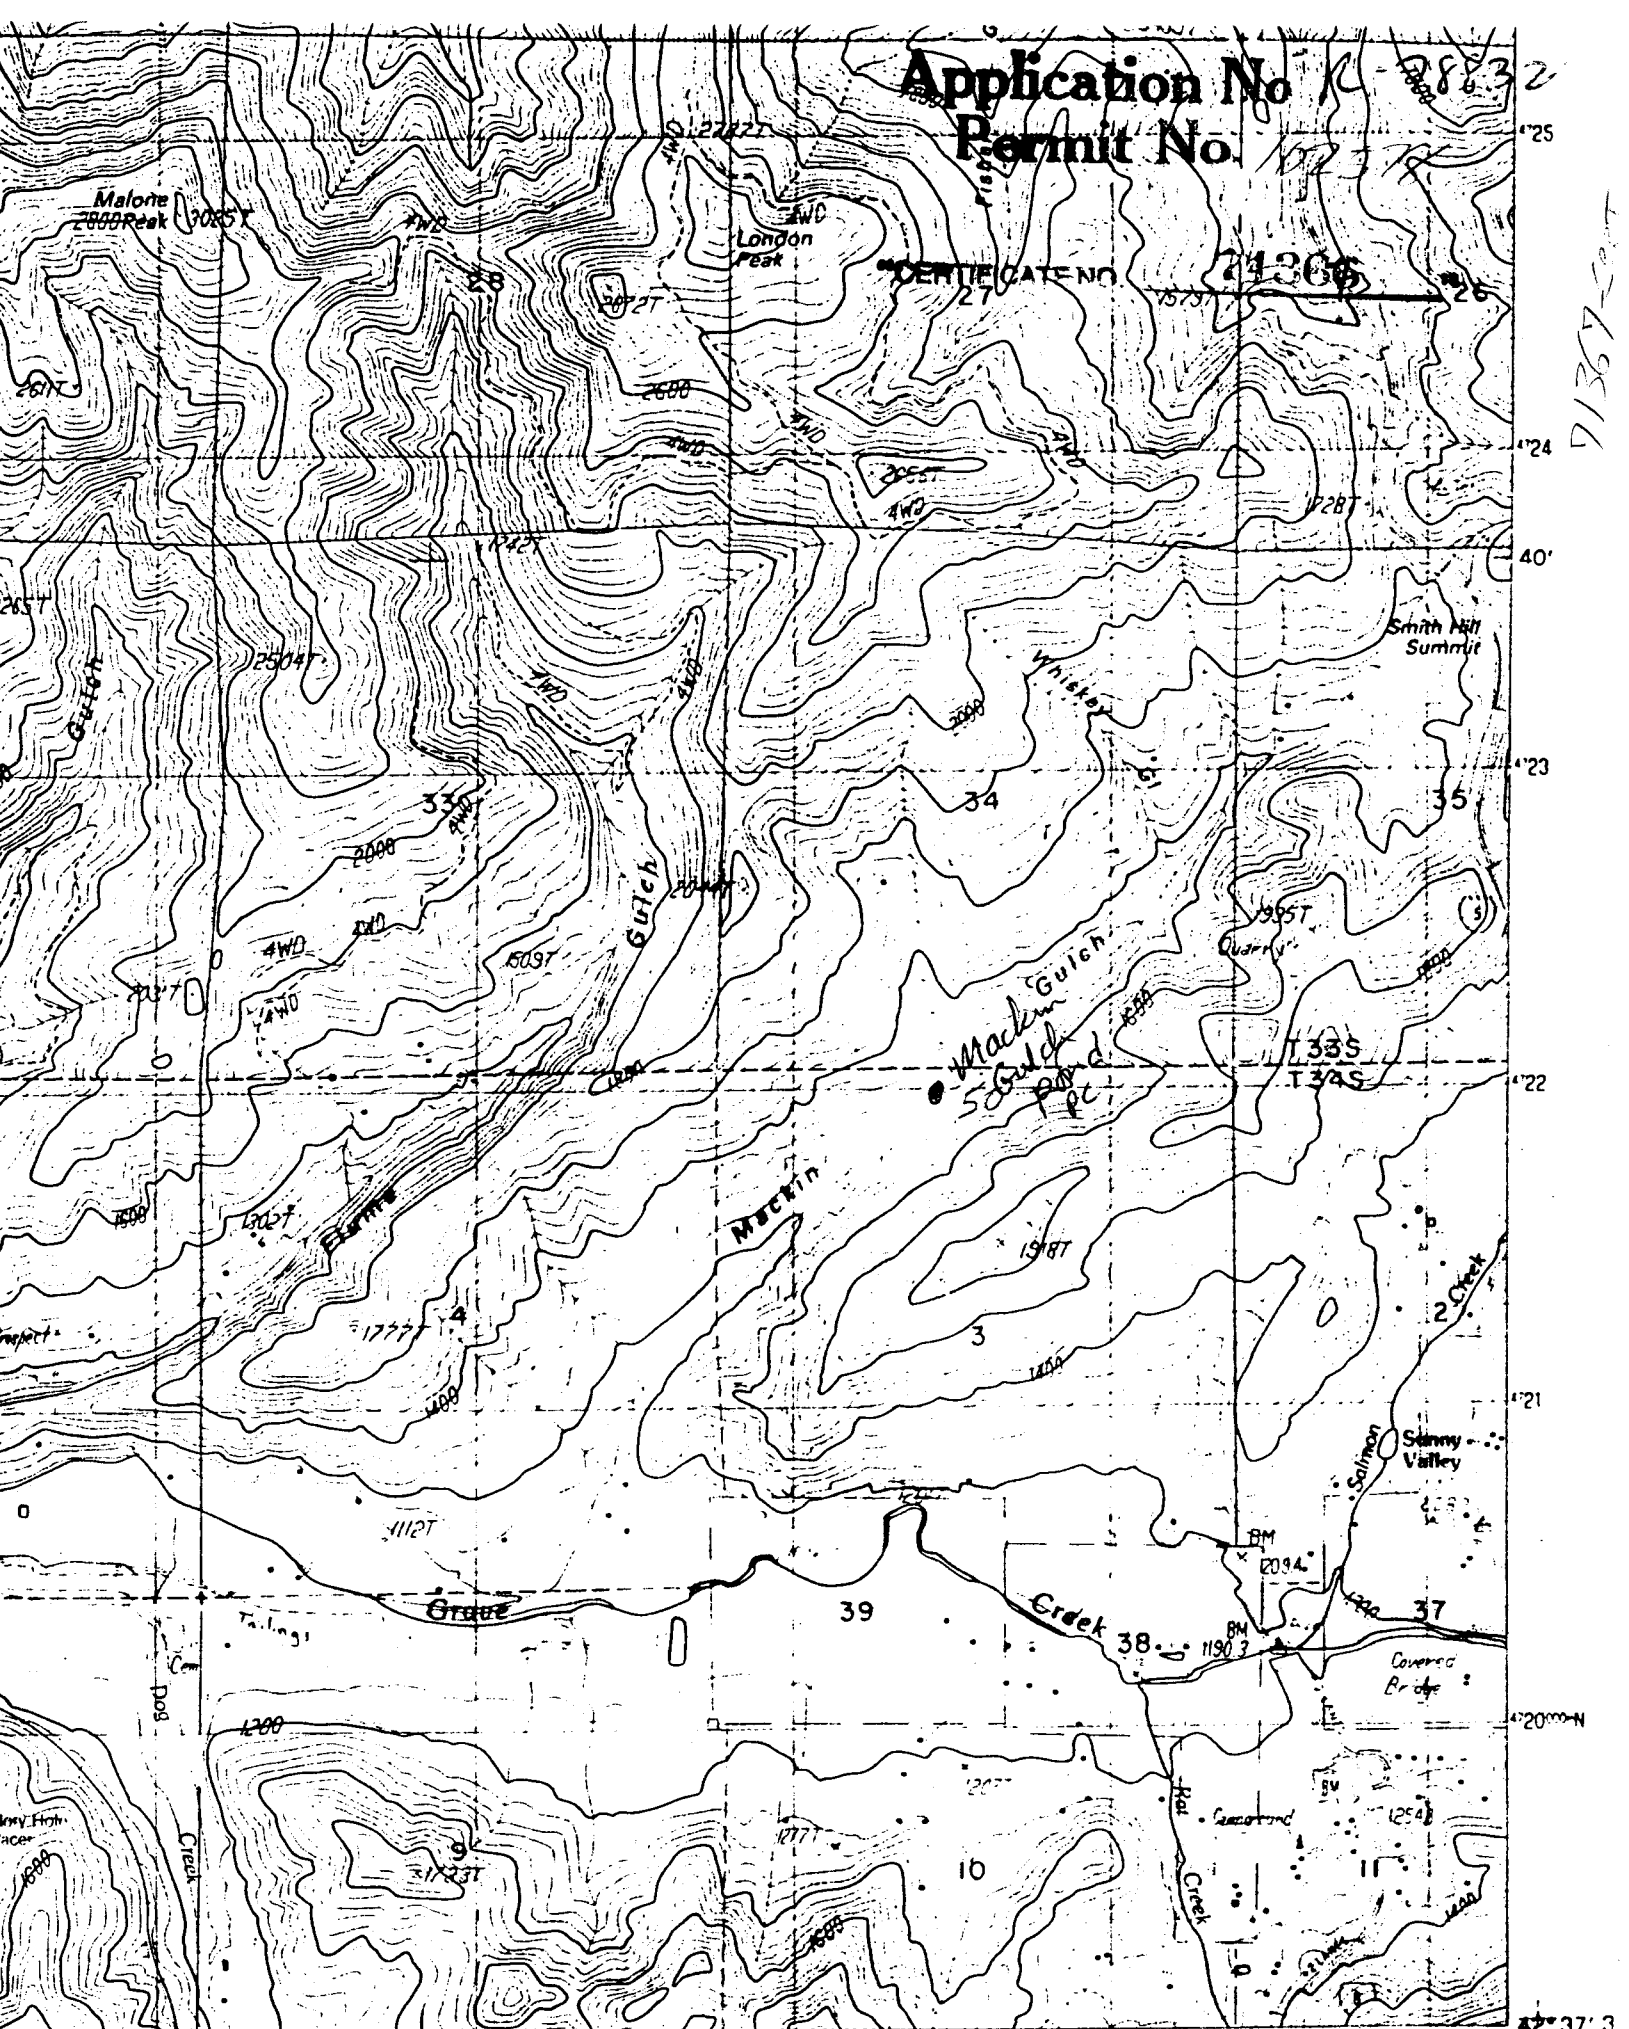

71367-207

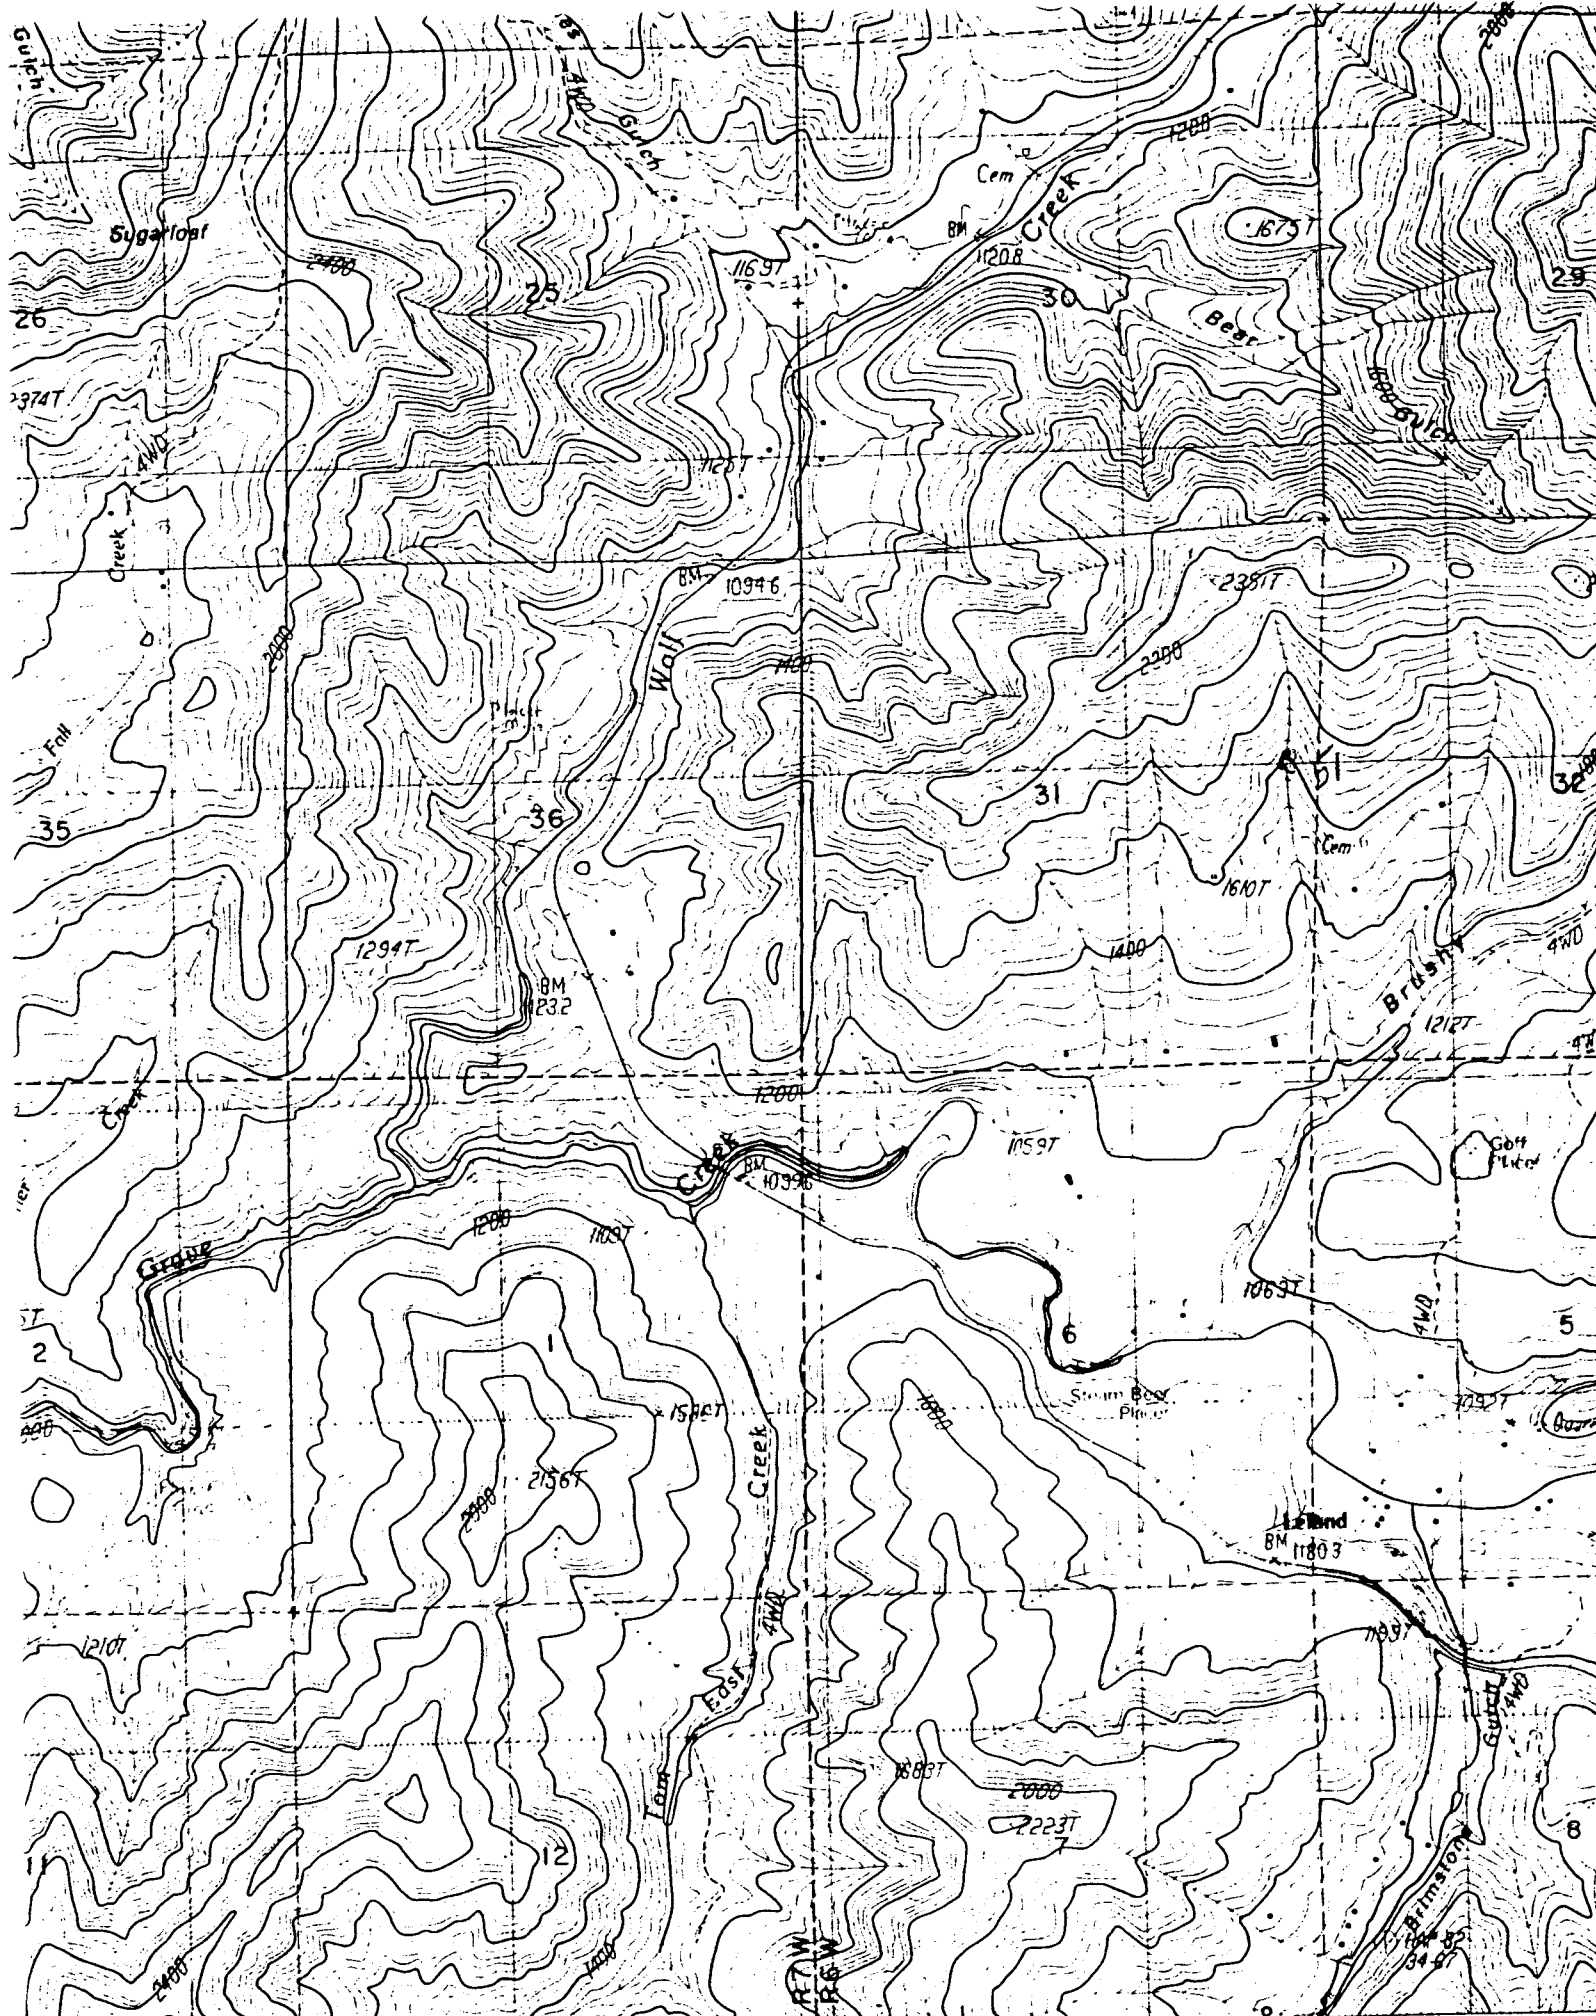

60

1:200000 FEE!

62

27' 30"

63

Mackin Gulch

64

SCALE 1:21 MM