

UNITED STATES
DEPARTMENT OF THE INTERIOR
BUREAU OF LAND MANAGEMENT

RECEIVED
MARCH 1961
BUREAU OF LAND MANAGEMENT
WASHINGTON, D.C.


SECTION

10

Oregon State Water Filings

TOWNSHIP 22 S, RANGE 29 E, W. M.

North

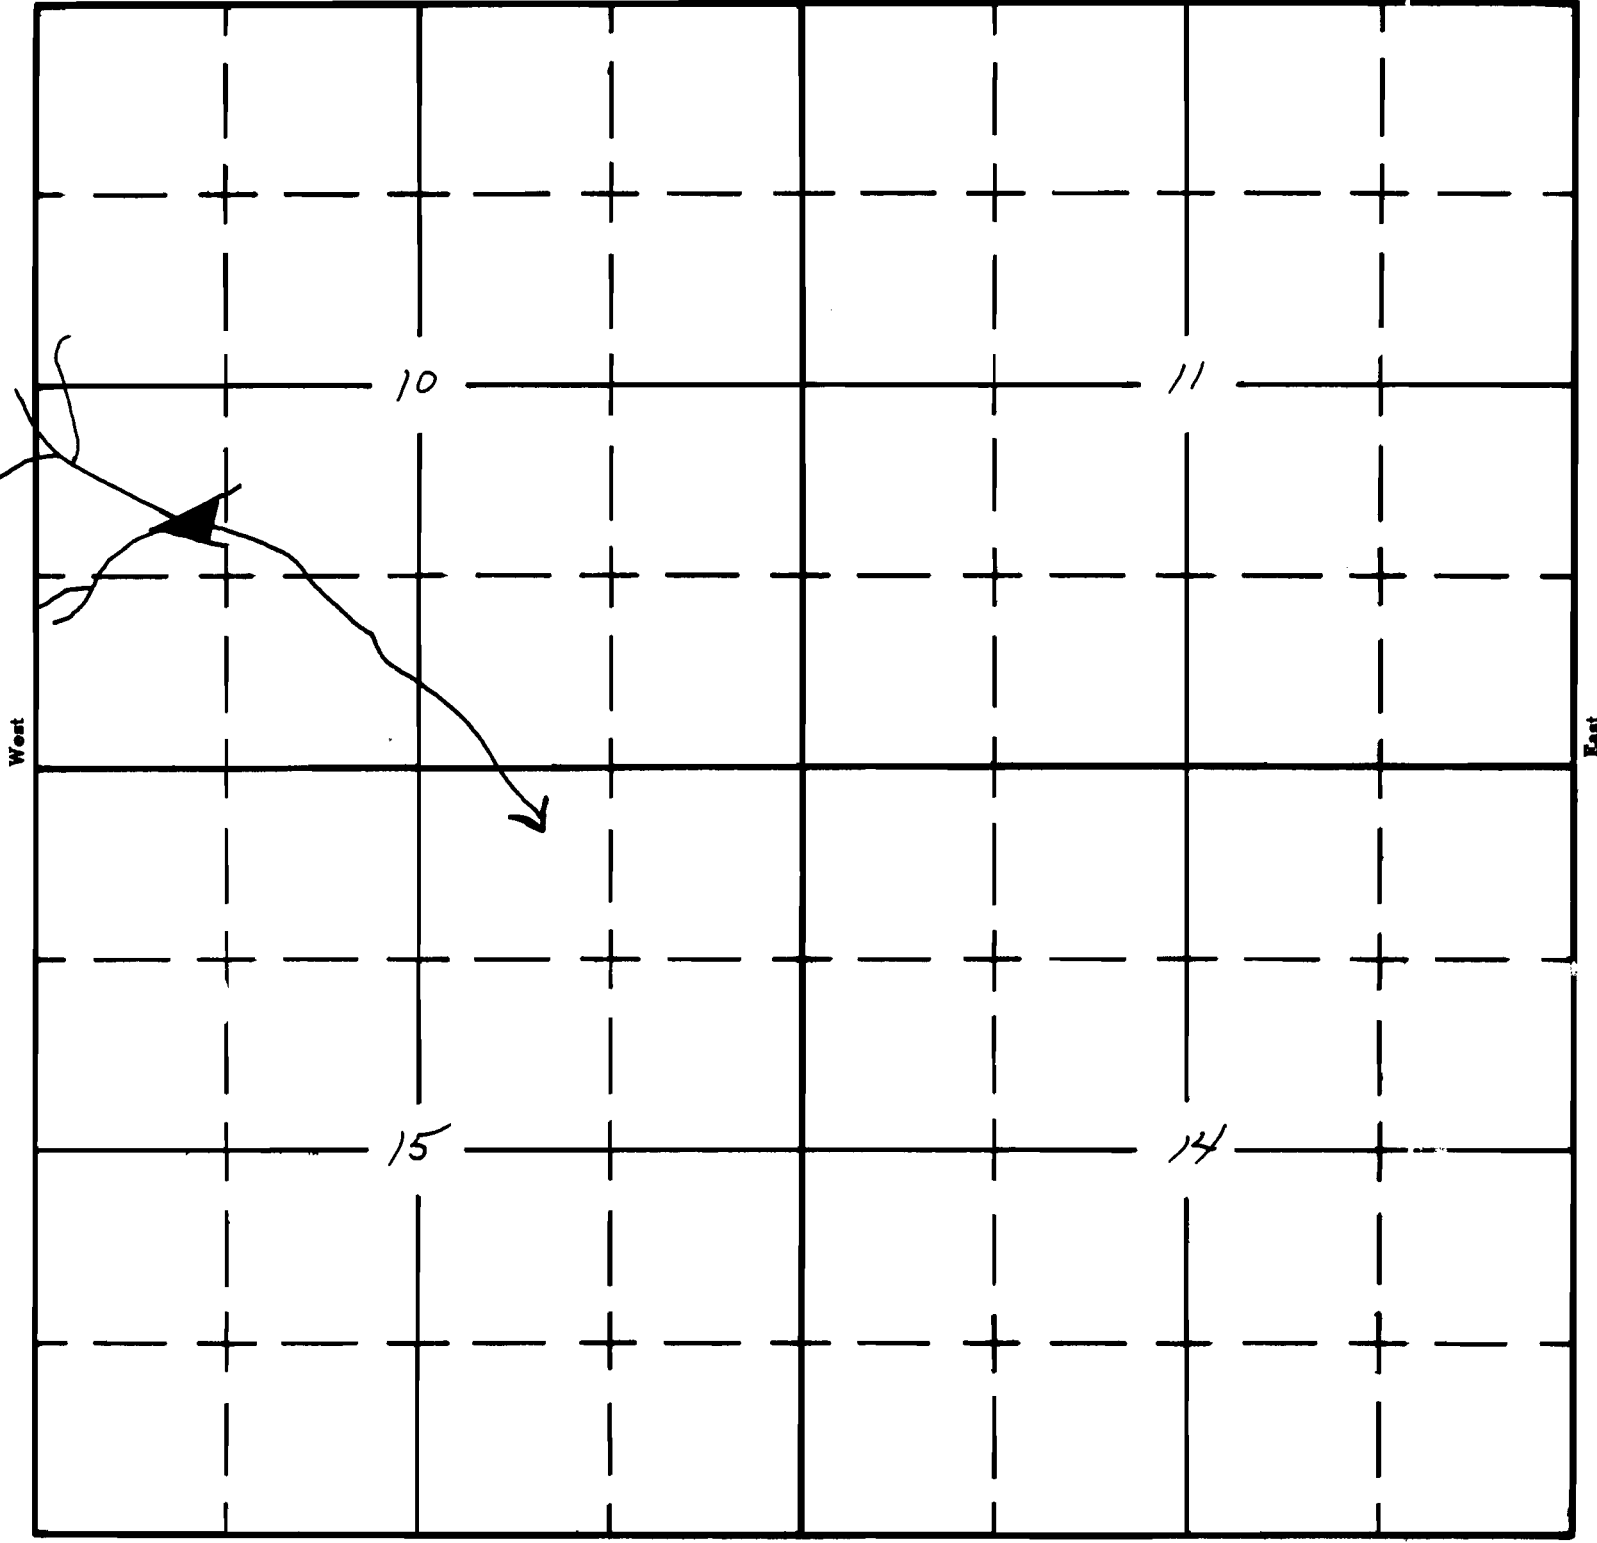

South

APPLICATION No. R-38979
PERMIT No. R-3468