

NE1/4 NW1/4 SEC.02 TWP.08S. RGE.2W. WM
MARION COUNTY, OREGON

DEC 30 1994

Application No. R-79035
Permit No.

"CERTIFICATE NO. 71006"

RECEIVED

SEE MAP 07 2W 35C

LEGEND

LINE TYPES

- TAX LOT BOUNDARIES
- OLD PROPERTY LINES
- RIVERS, LAKES, ETC.
- CREEKS, POND, ETC.
- RAILROADS
- TAX CODE BOUNDARIES
- SUBDIVISION BOUNDARIES

SYMBOL TYPES


- CONTROL POINTS
- SURVEY MONUMENTS
- G.L.O. CORNERS (APPROX) (FOUND)
- SECTION
- 1/4 SEC
- 1/16 SEC
- D.L.C.
- OREGON STATE PLANE COORDINATE SYSTEM GRID MARKS - NAD 27

NUMBERS

TAX CODE NO.
000 00 00 0


ACREAGE - ALL ACREAGES EXCLUDE ANY PORTION THAT MAY LIE WITHIN THE INDICATED PUBLIC RIGHT OF WAYS.

TICK MARKS - WHEN A TICK MARK IS INDICATED ON THE EXTENSION OF A LINE, THEN THE DIMENSION GOES TO THE TICK MARK. GENERALLY THIS IS USED WHEN DIMENSIONS GO INTO PUBLIC RIGHT OF WAYS.

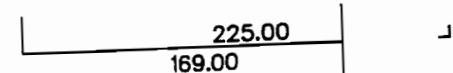

ARROWS ARE USED WITH DIMENSIONS IN AREAS OF GREATER COMPLEXITY.

WARNING: This map was created by digitizing assorted existing maps. NO Research was done. Created for Assessor's Office use ONLY.

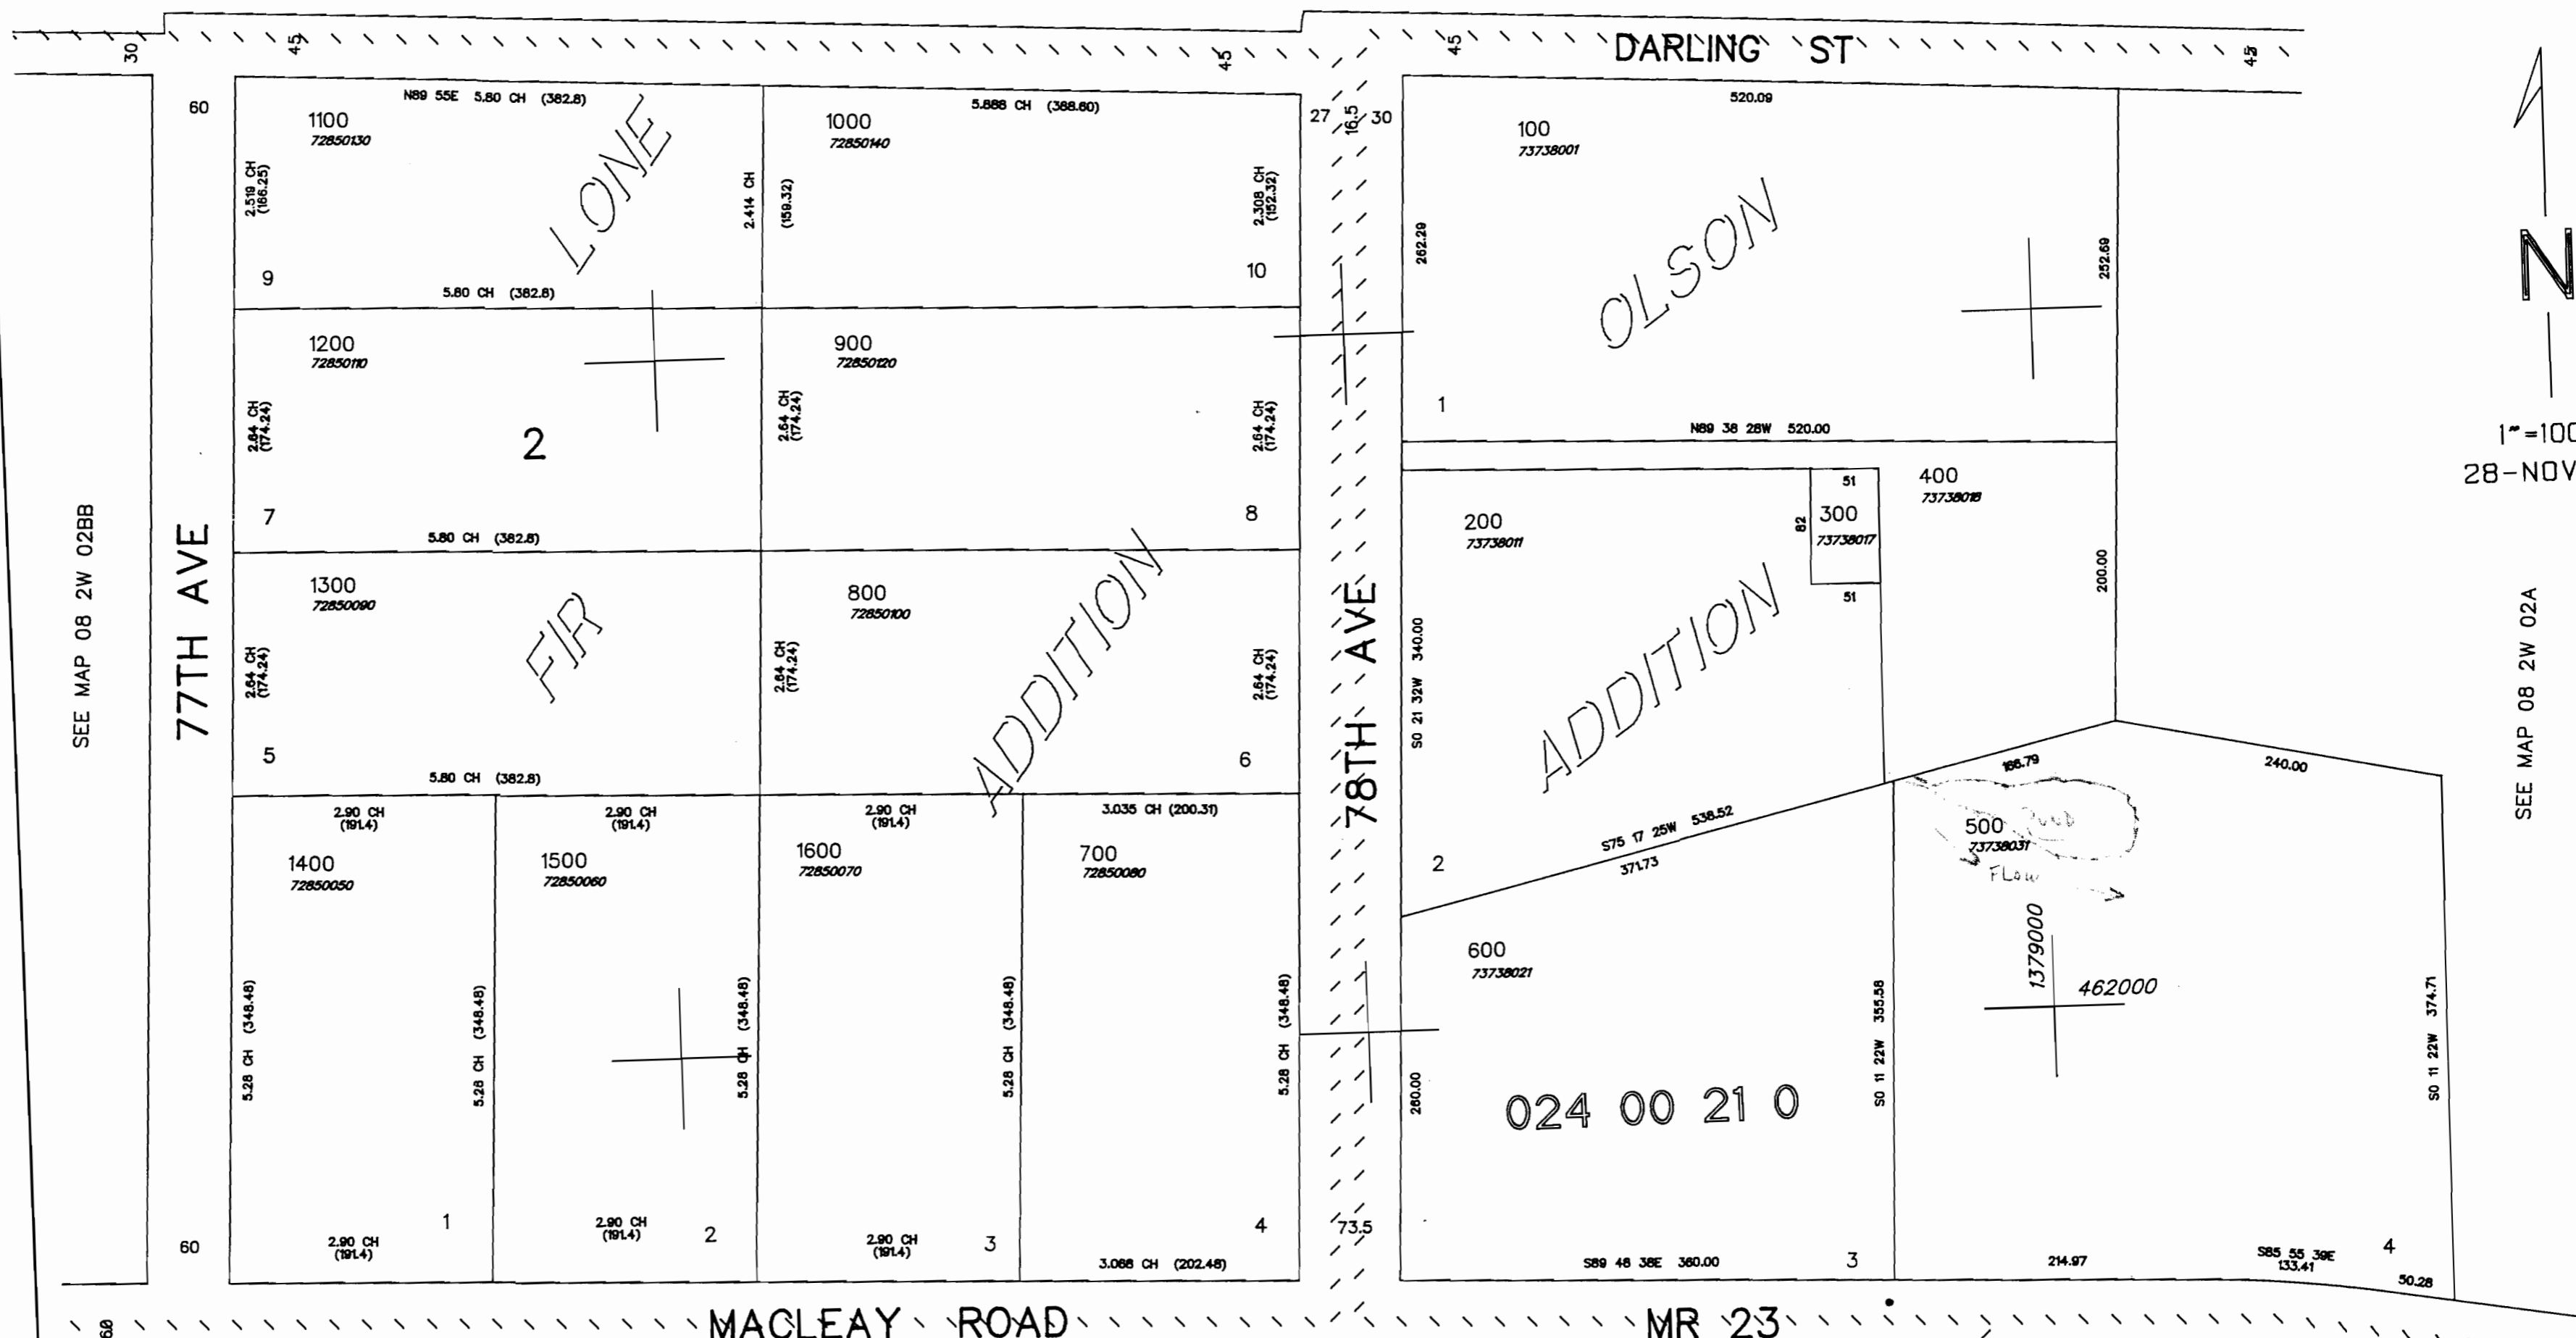

1"=100'
28-NOV-90

SEE MAP 08 2W 02A

SEE MAP 08 2W 02BD

1/16 COR