


U M P Q U A

NATIONAL

Cleveland Ridge  
Trail NW Quad

F O R

Scale 1:25,000

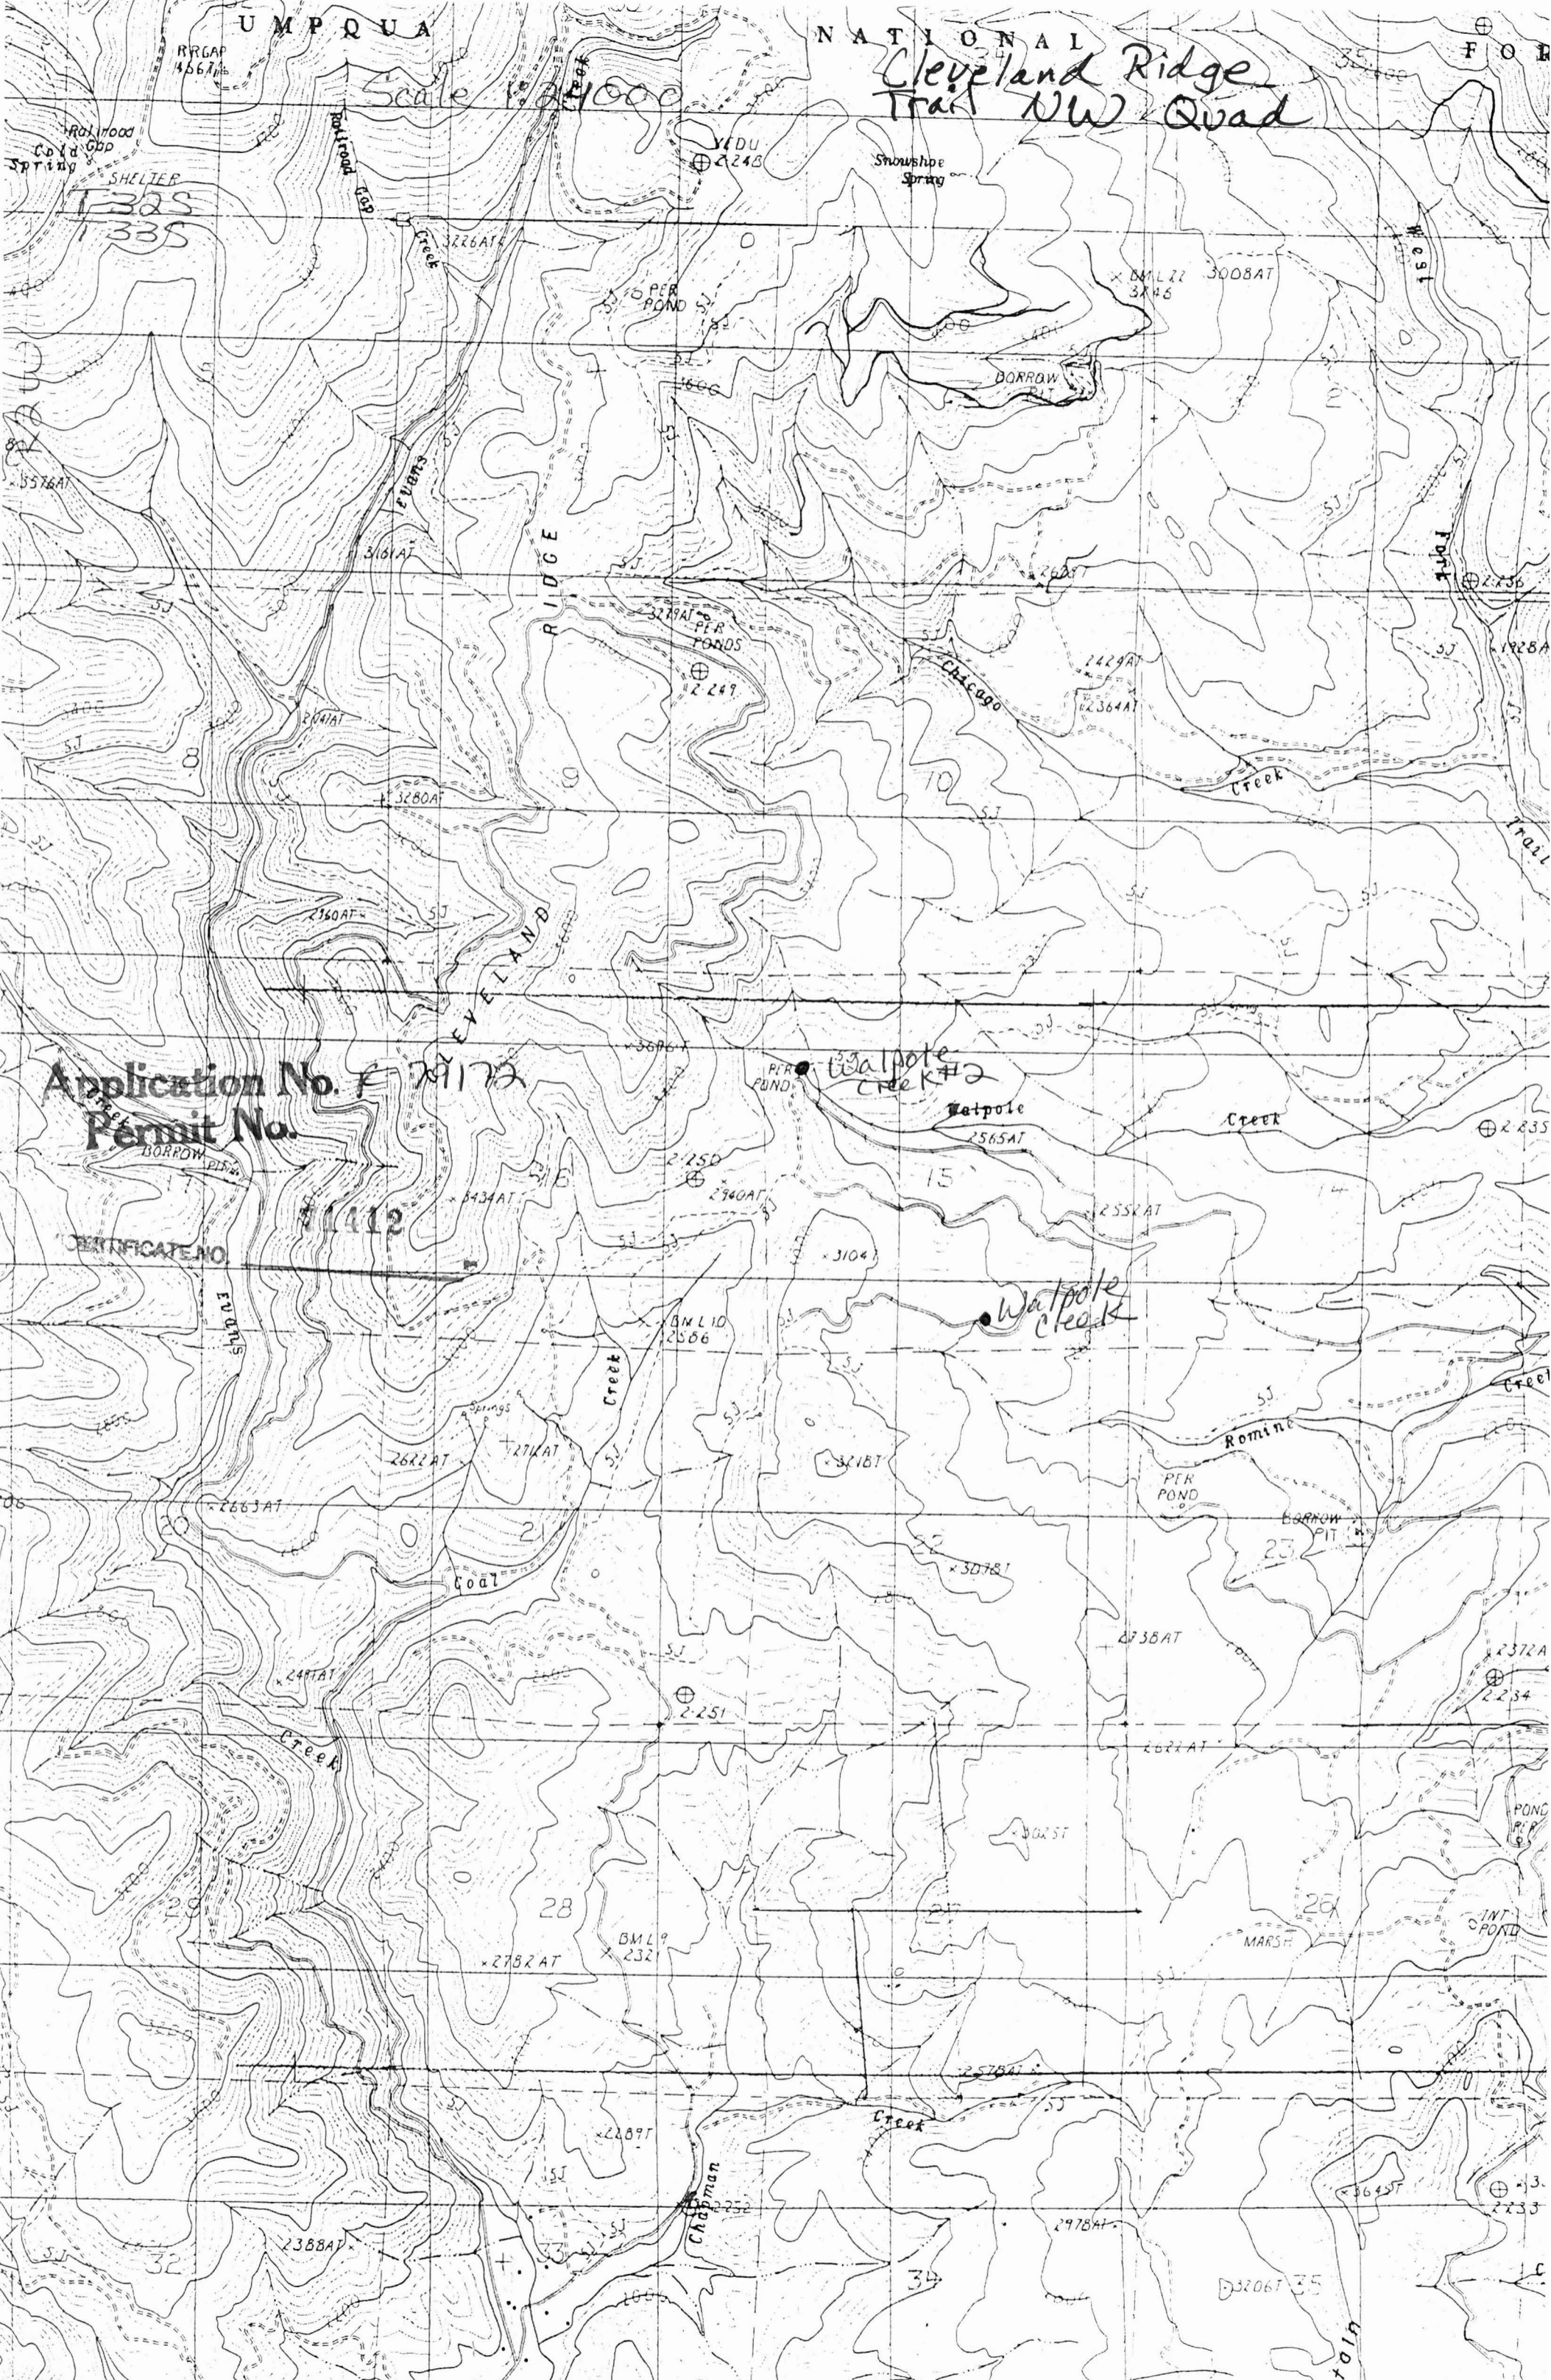

No Final Proof Map available

No Permit Map available