


Application No. R-79176
Permit No.

CERTIFICATE NO. 114
Scale 1:24000

SKELETON MTN. QUADRANGLE
OREGON—JACKSON CO.
7.5 MINUTE SERIES (TOPOGRAPHIC)

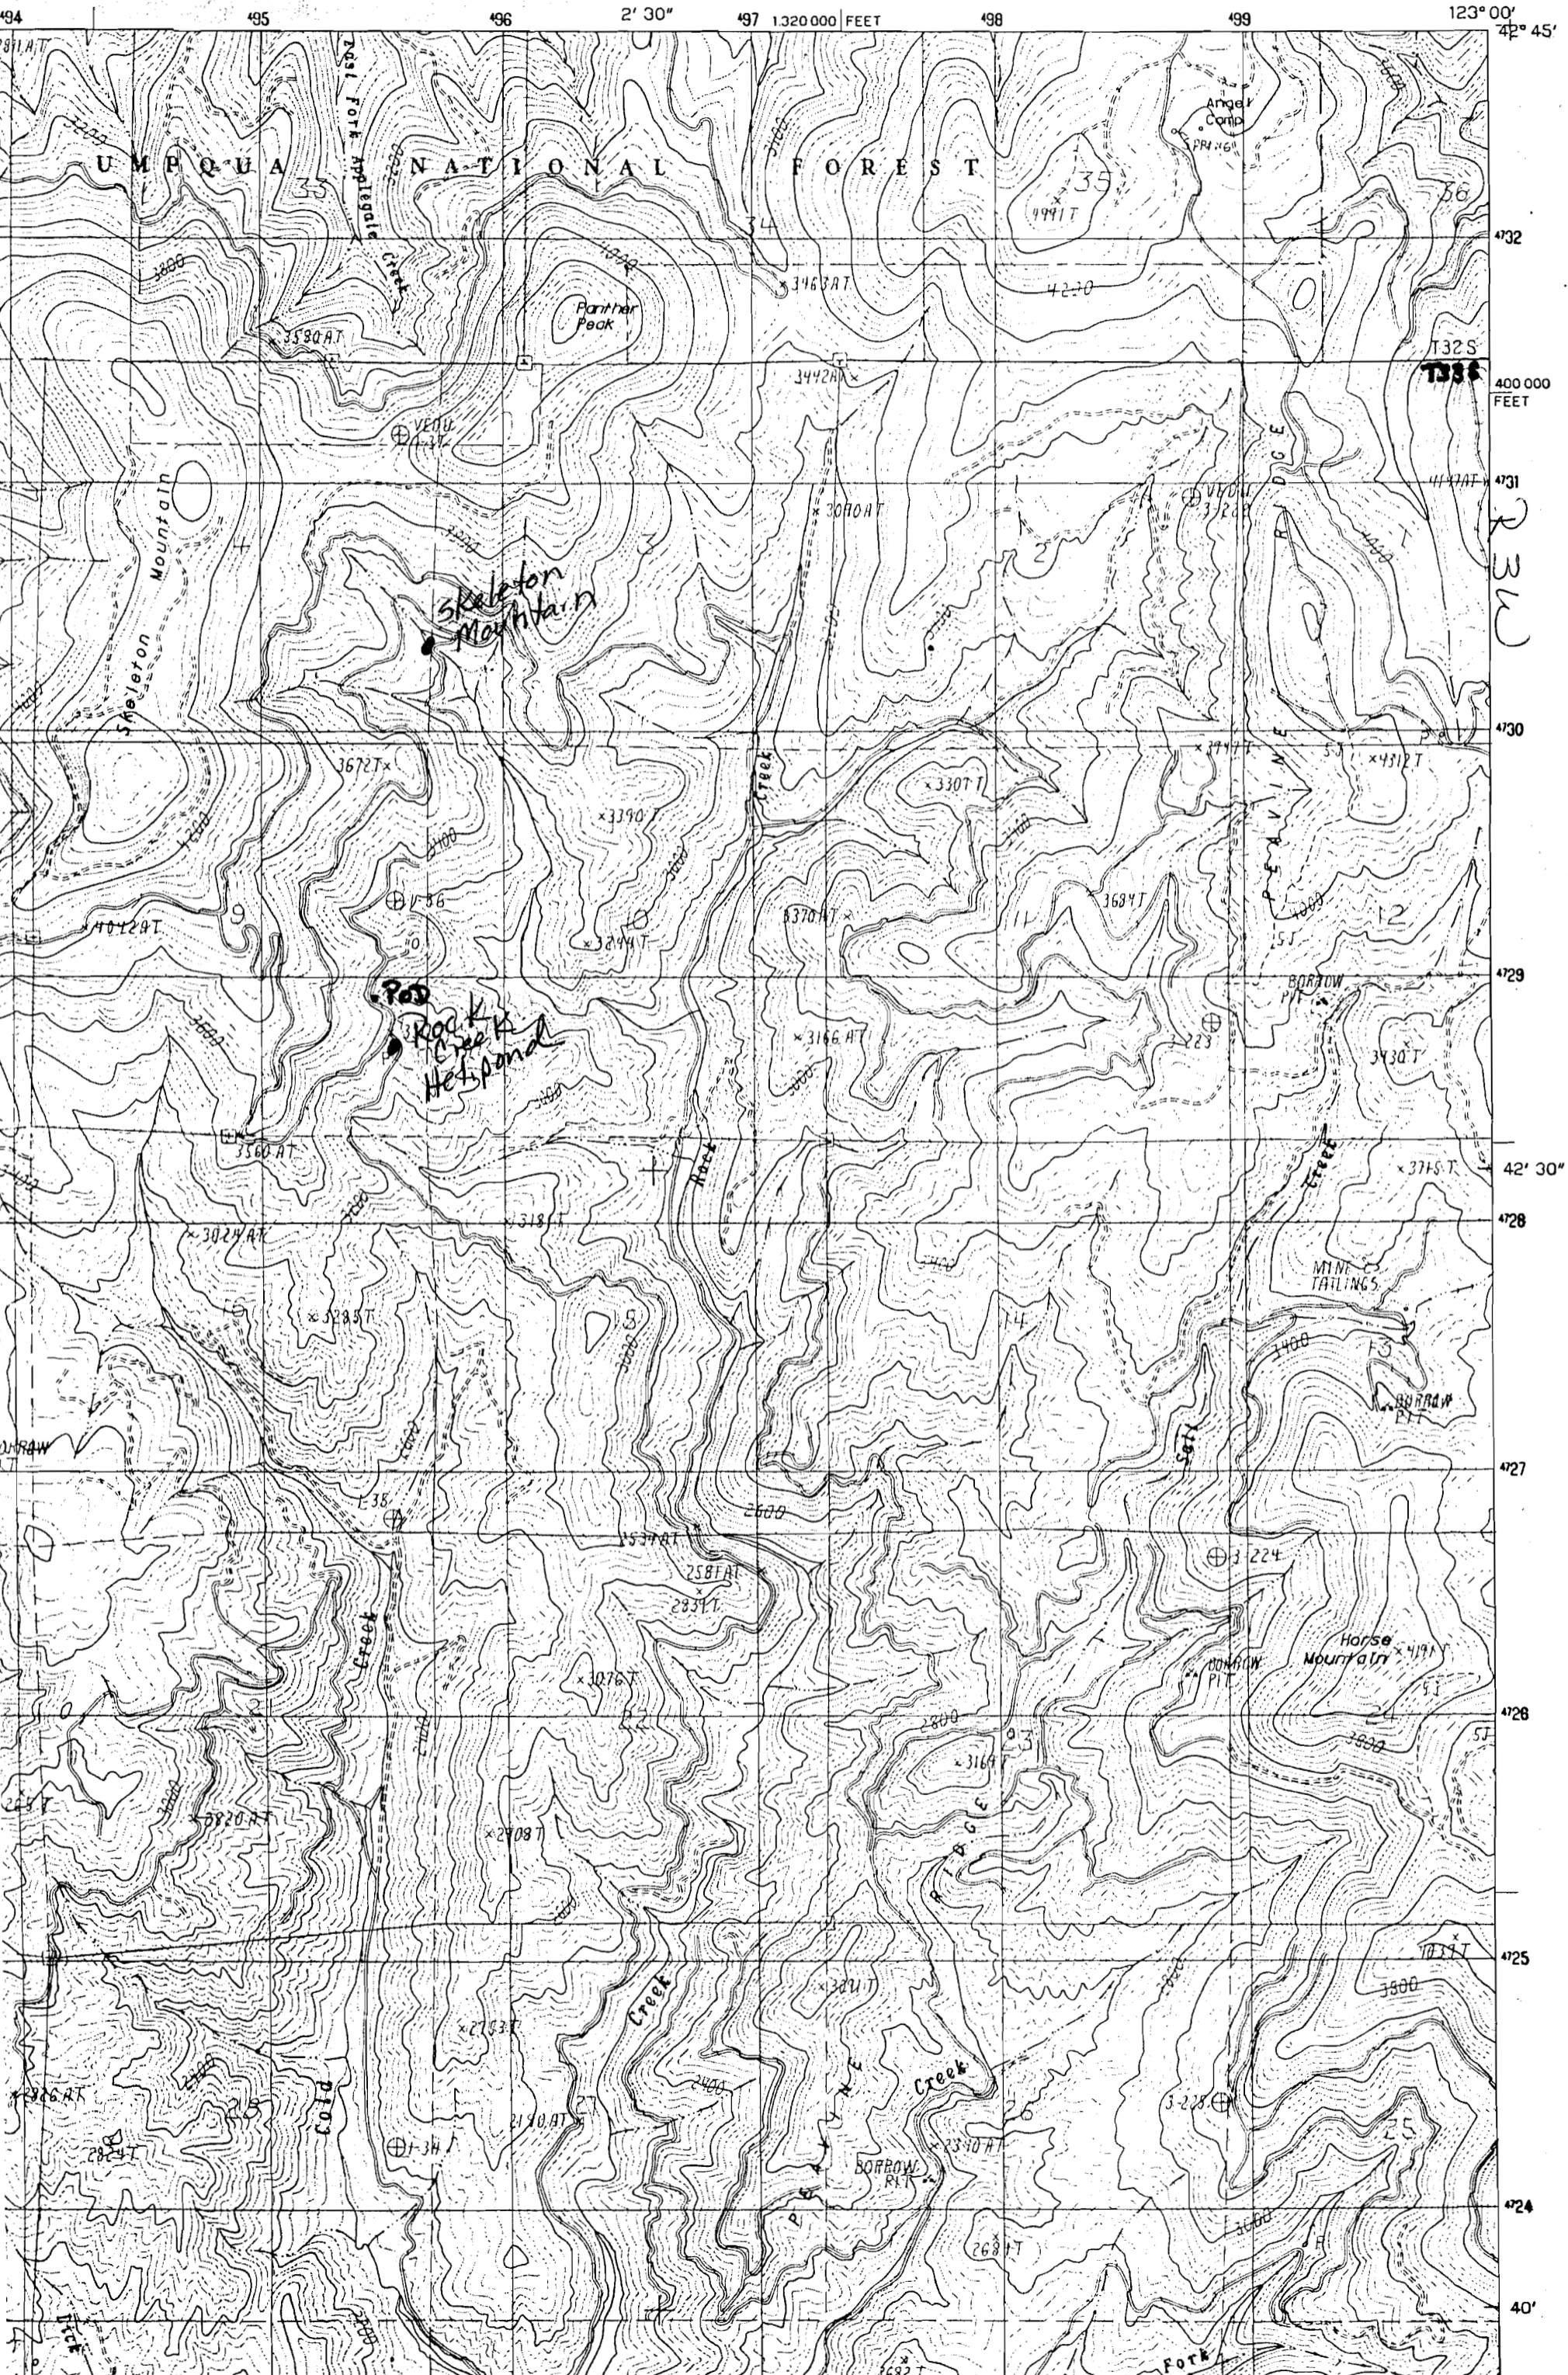

No Final Proof Map available

No Permit Map available