



Application No. R-79182  
Permit No. 18.1

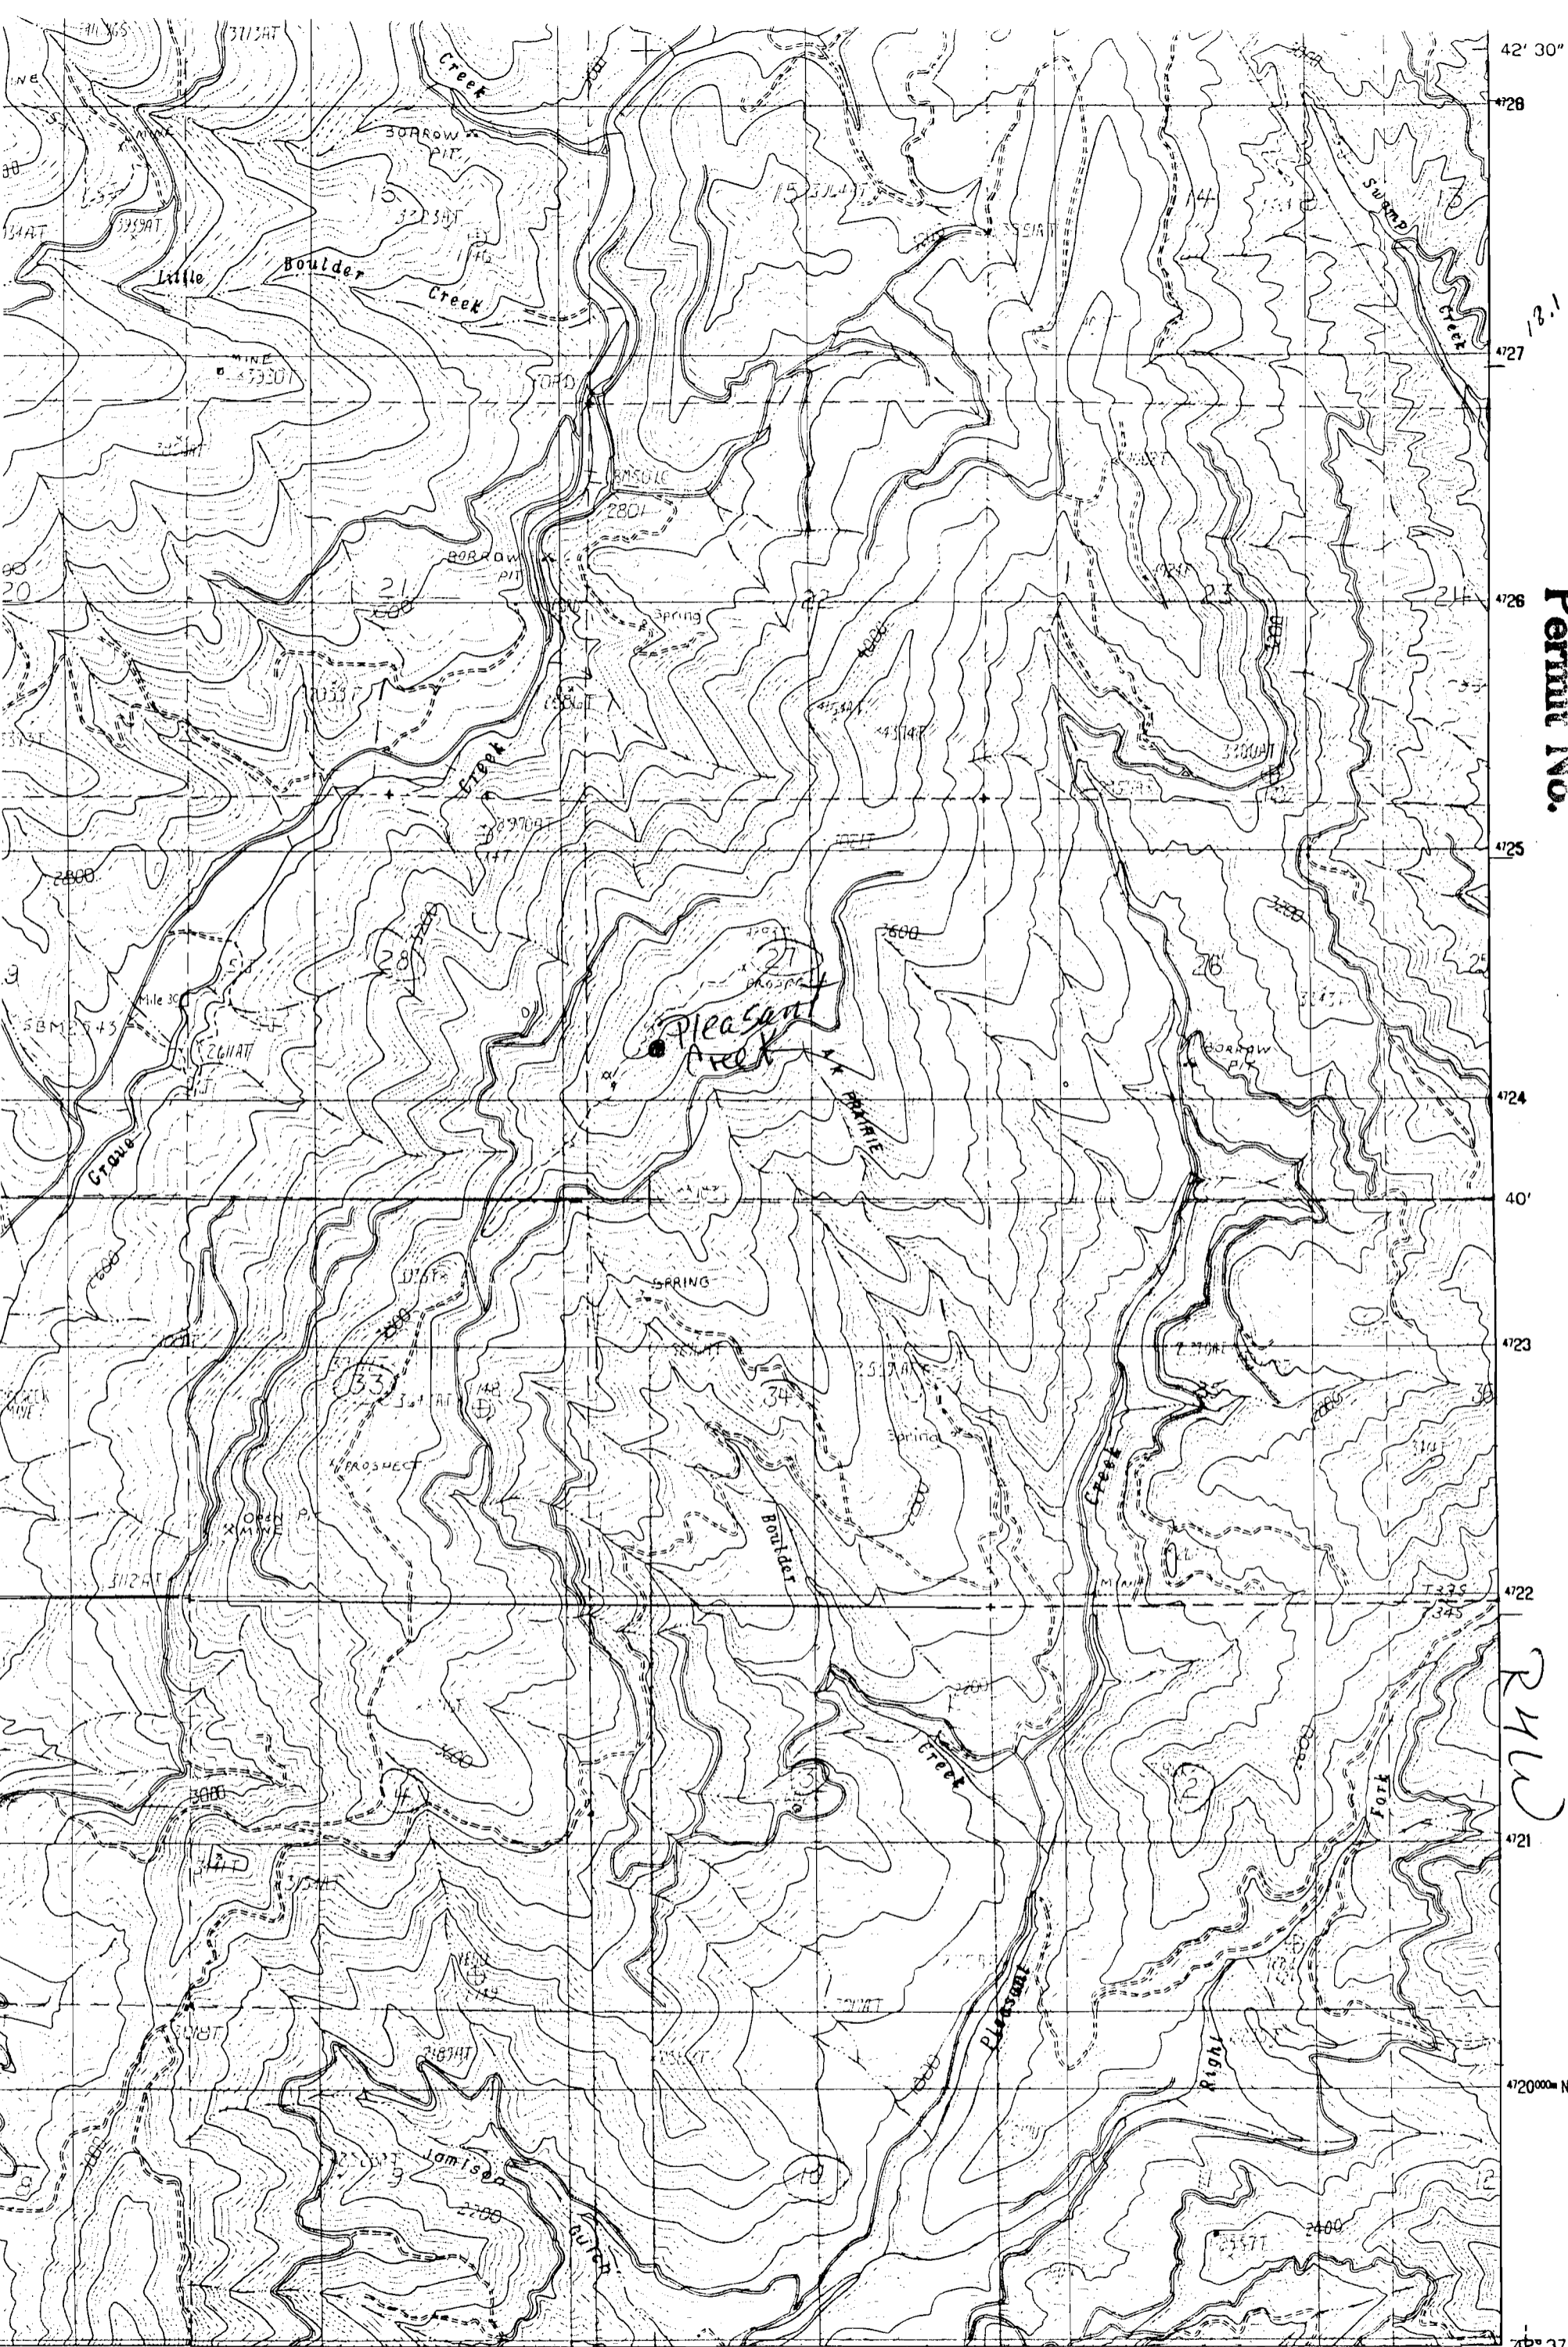


42' 30"  
428  
427  
426  
425  
424  
40'  
423  
422  
421  
420000 N  
42' 37' 30"

R411D

SCALE 1:24 000

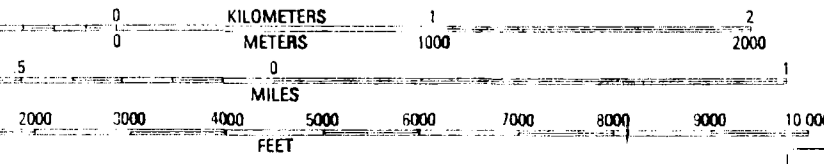

INTERIOR GEOLOGICAL SURVEY RESTON, VIRGINIA 1983

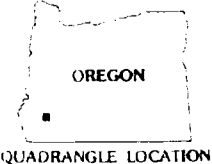

King Mountain Quad  
ROAD LEGEND

- Improved Road.....
- Unimproved Road.....
- Trail.....
- Interstate Route
- U.S. Route
- State Route

CONTOUR INTERVAL 40 FEET

QUADRANGLE LOCATION