


# Skeleton Mtn Road

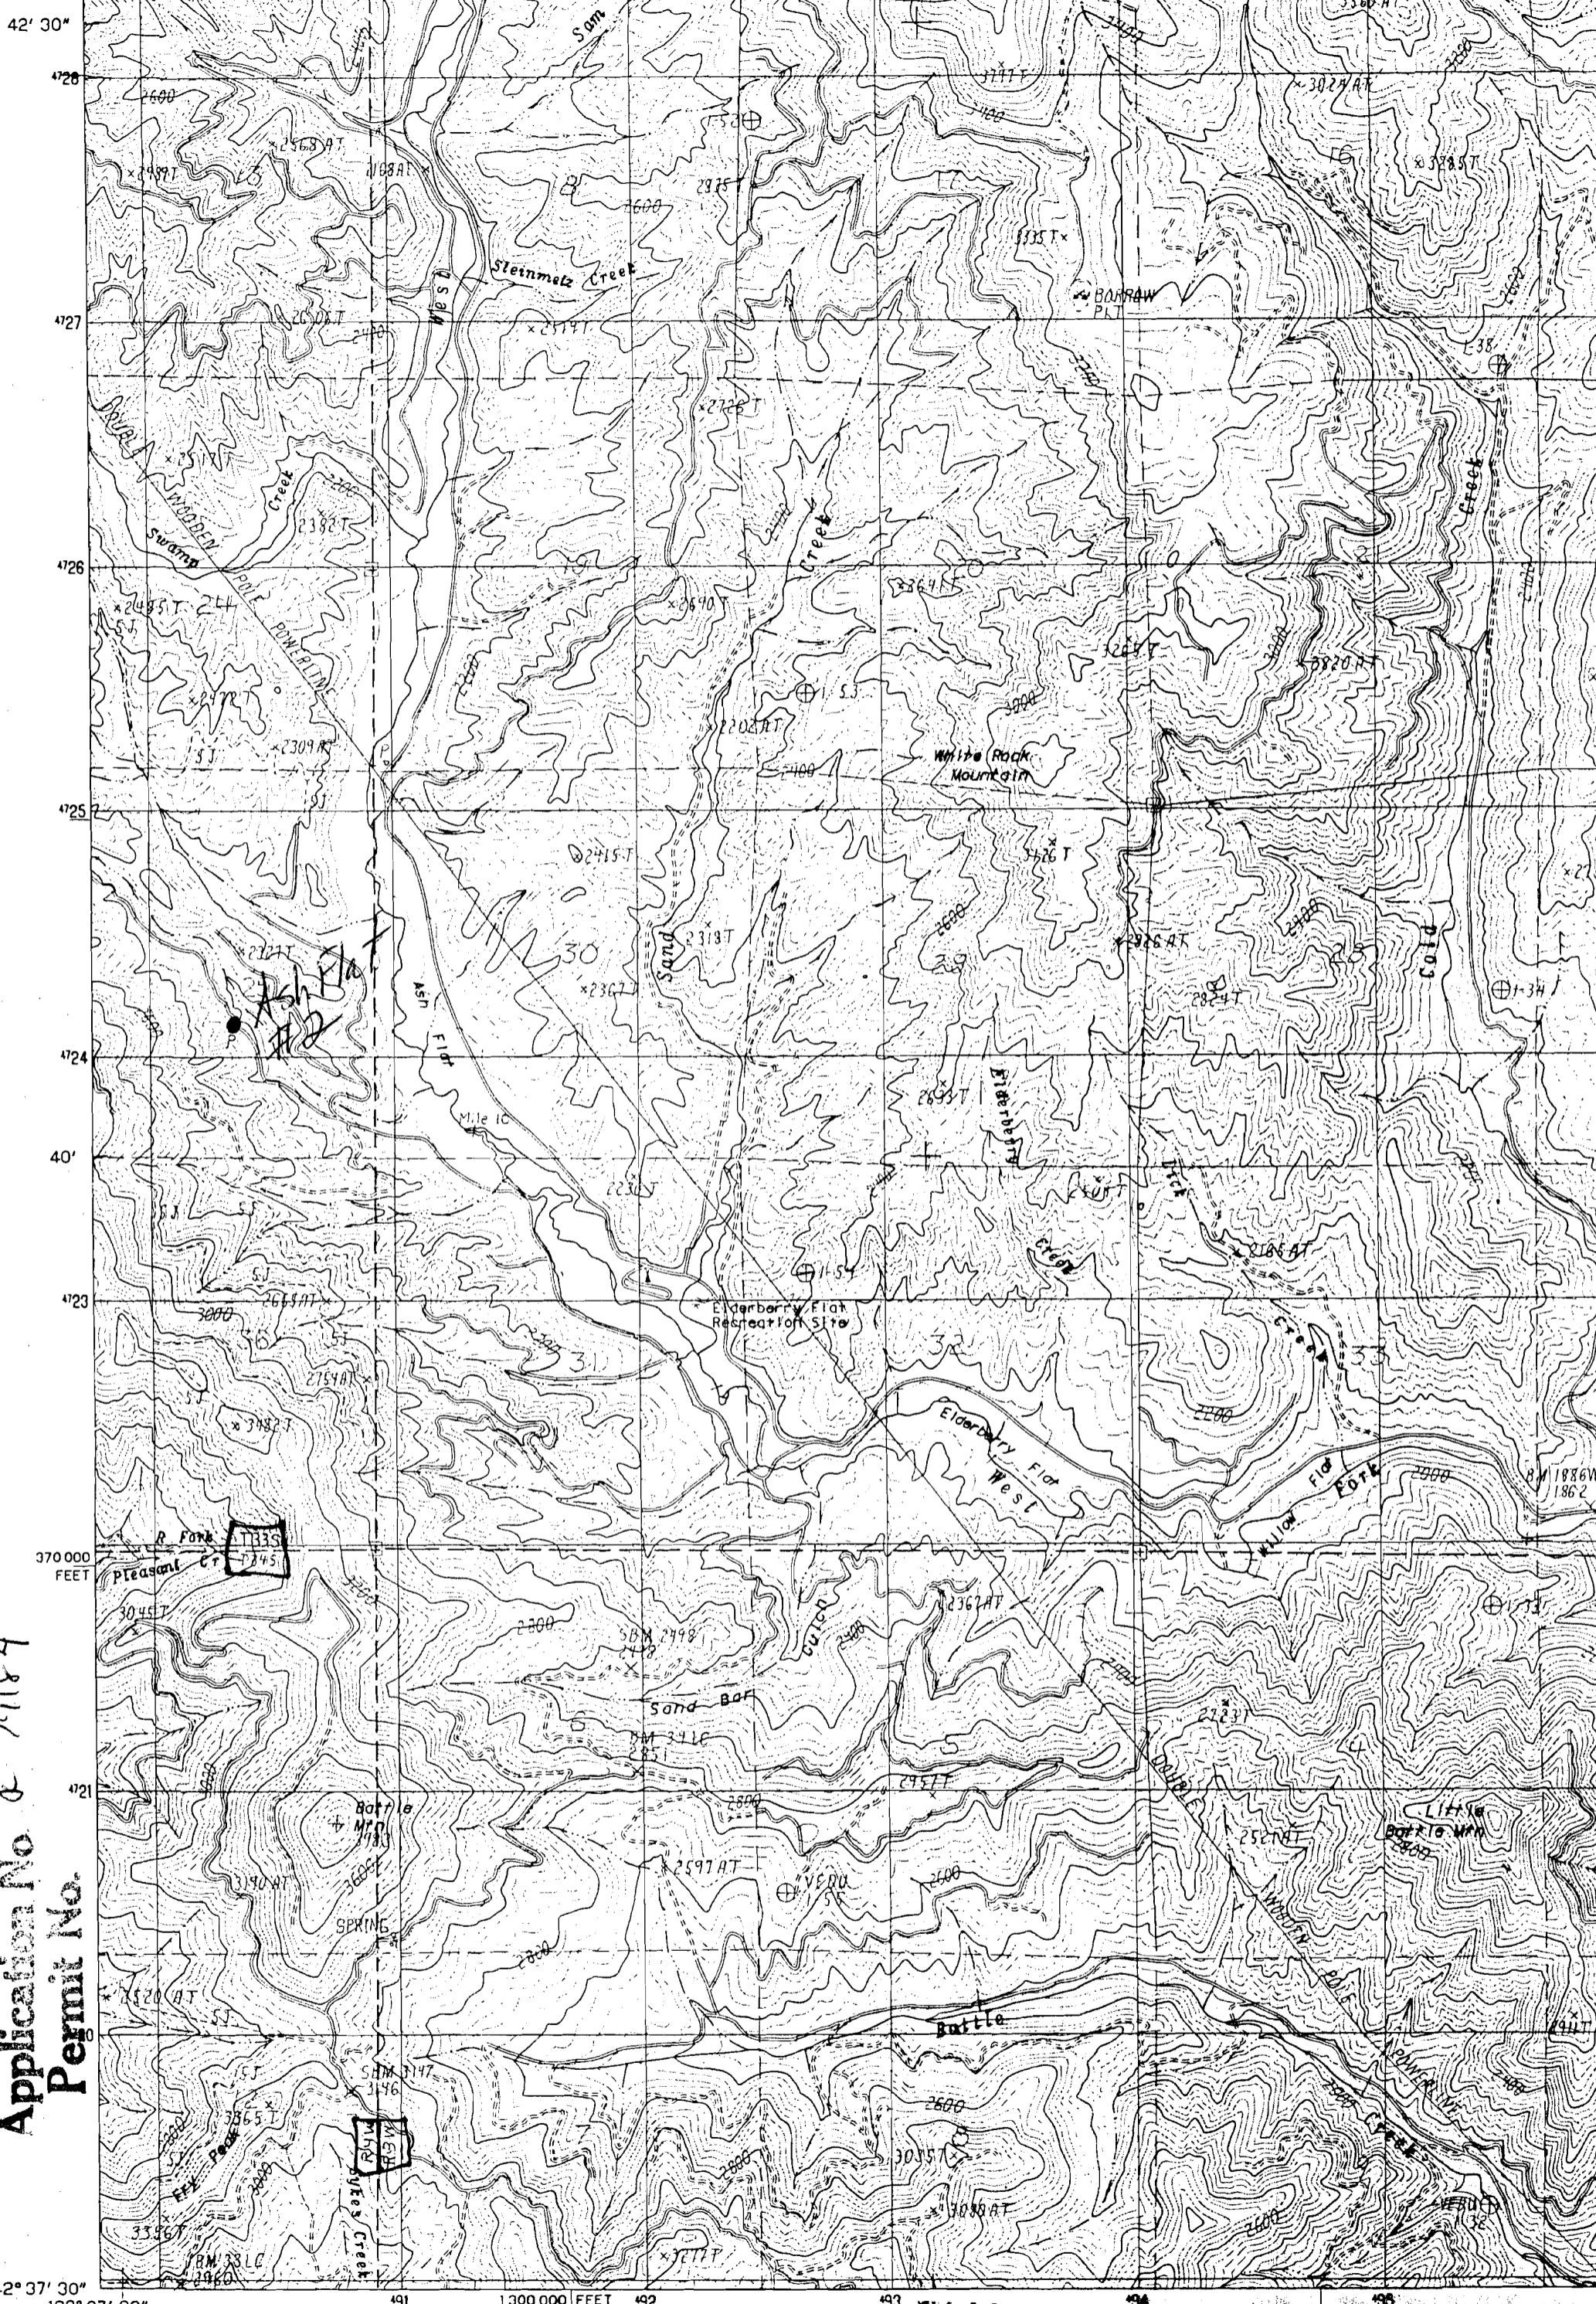

Application No. 879184  
Permit No.

42° 37' 30"  
123° 07' 30"

PRODUCED BY THE UNITED STATES GEOLOGICAL SURVEY  
CONTROL BY USGS, NOS/NOAA  
COMPILED FROM AERIAL PHOTOGRAPHS TAKEN 1976  
FIELD CHECKED 1978 MAP EDITED 1983  
PROJECTION LAMBERT CONFORMAL CONIC  
GRID: 1000-METER UNIVERSAL TRANSVERSE MERCATOR... ZONE 10  
10 000-FOOT STATE GRID TICKS OREGON, SOUTH ZONE

1:18

SCALE 1:24 000

1 5 0 1000 KILOMETERS  
1 5 0 1000 METERS  
MILES

INTERIOR-GEOLC

No Final Proof Map available

No Permit Map available