

Scale 1:24000

(RUSTLER PEAK NW)


25°

R 4 E

14 90 000 FEET

122°22'30"

42°37'30"

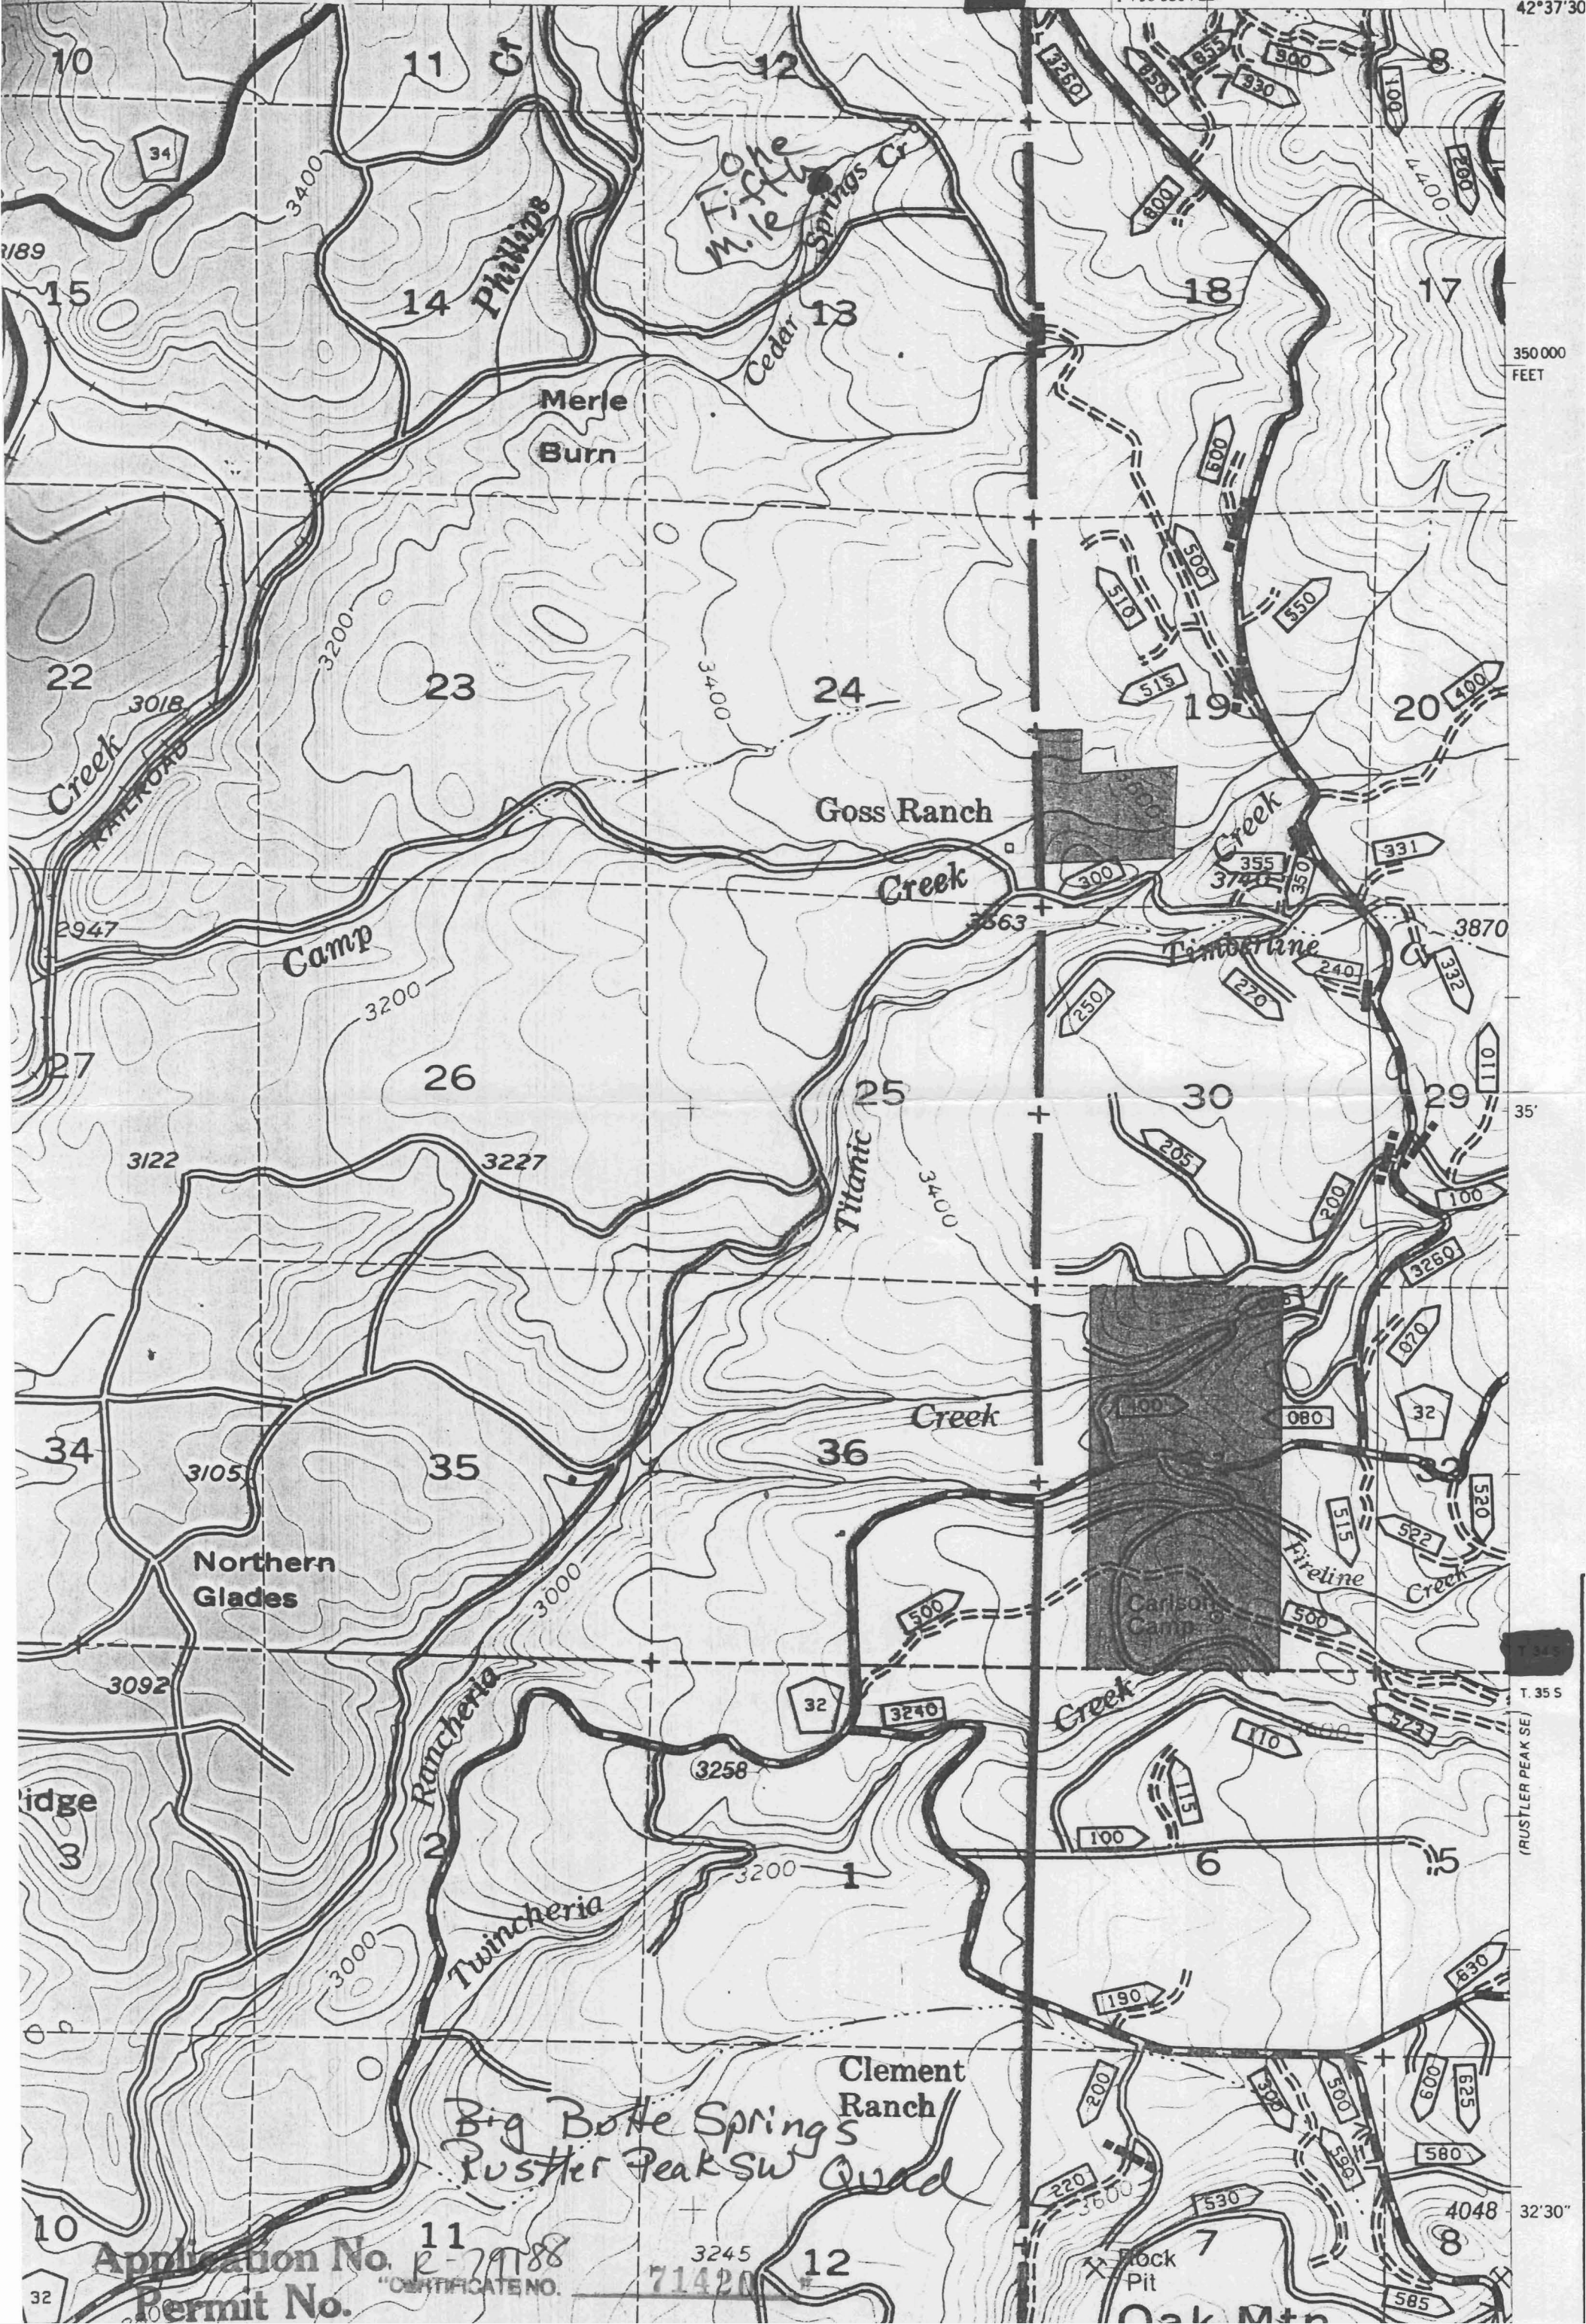

350 000
FEET

35°

T. 35 S

(RUSTLER PEAK SE)

32°30"

Application No. R-79188

Permit No.

CERTIFICATE NO.

3245
71420

No Final Proof Map available

No Permit Map available