


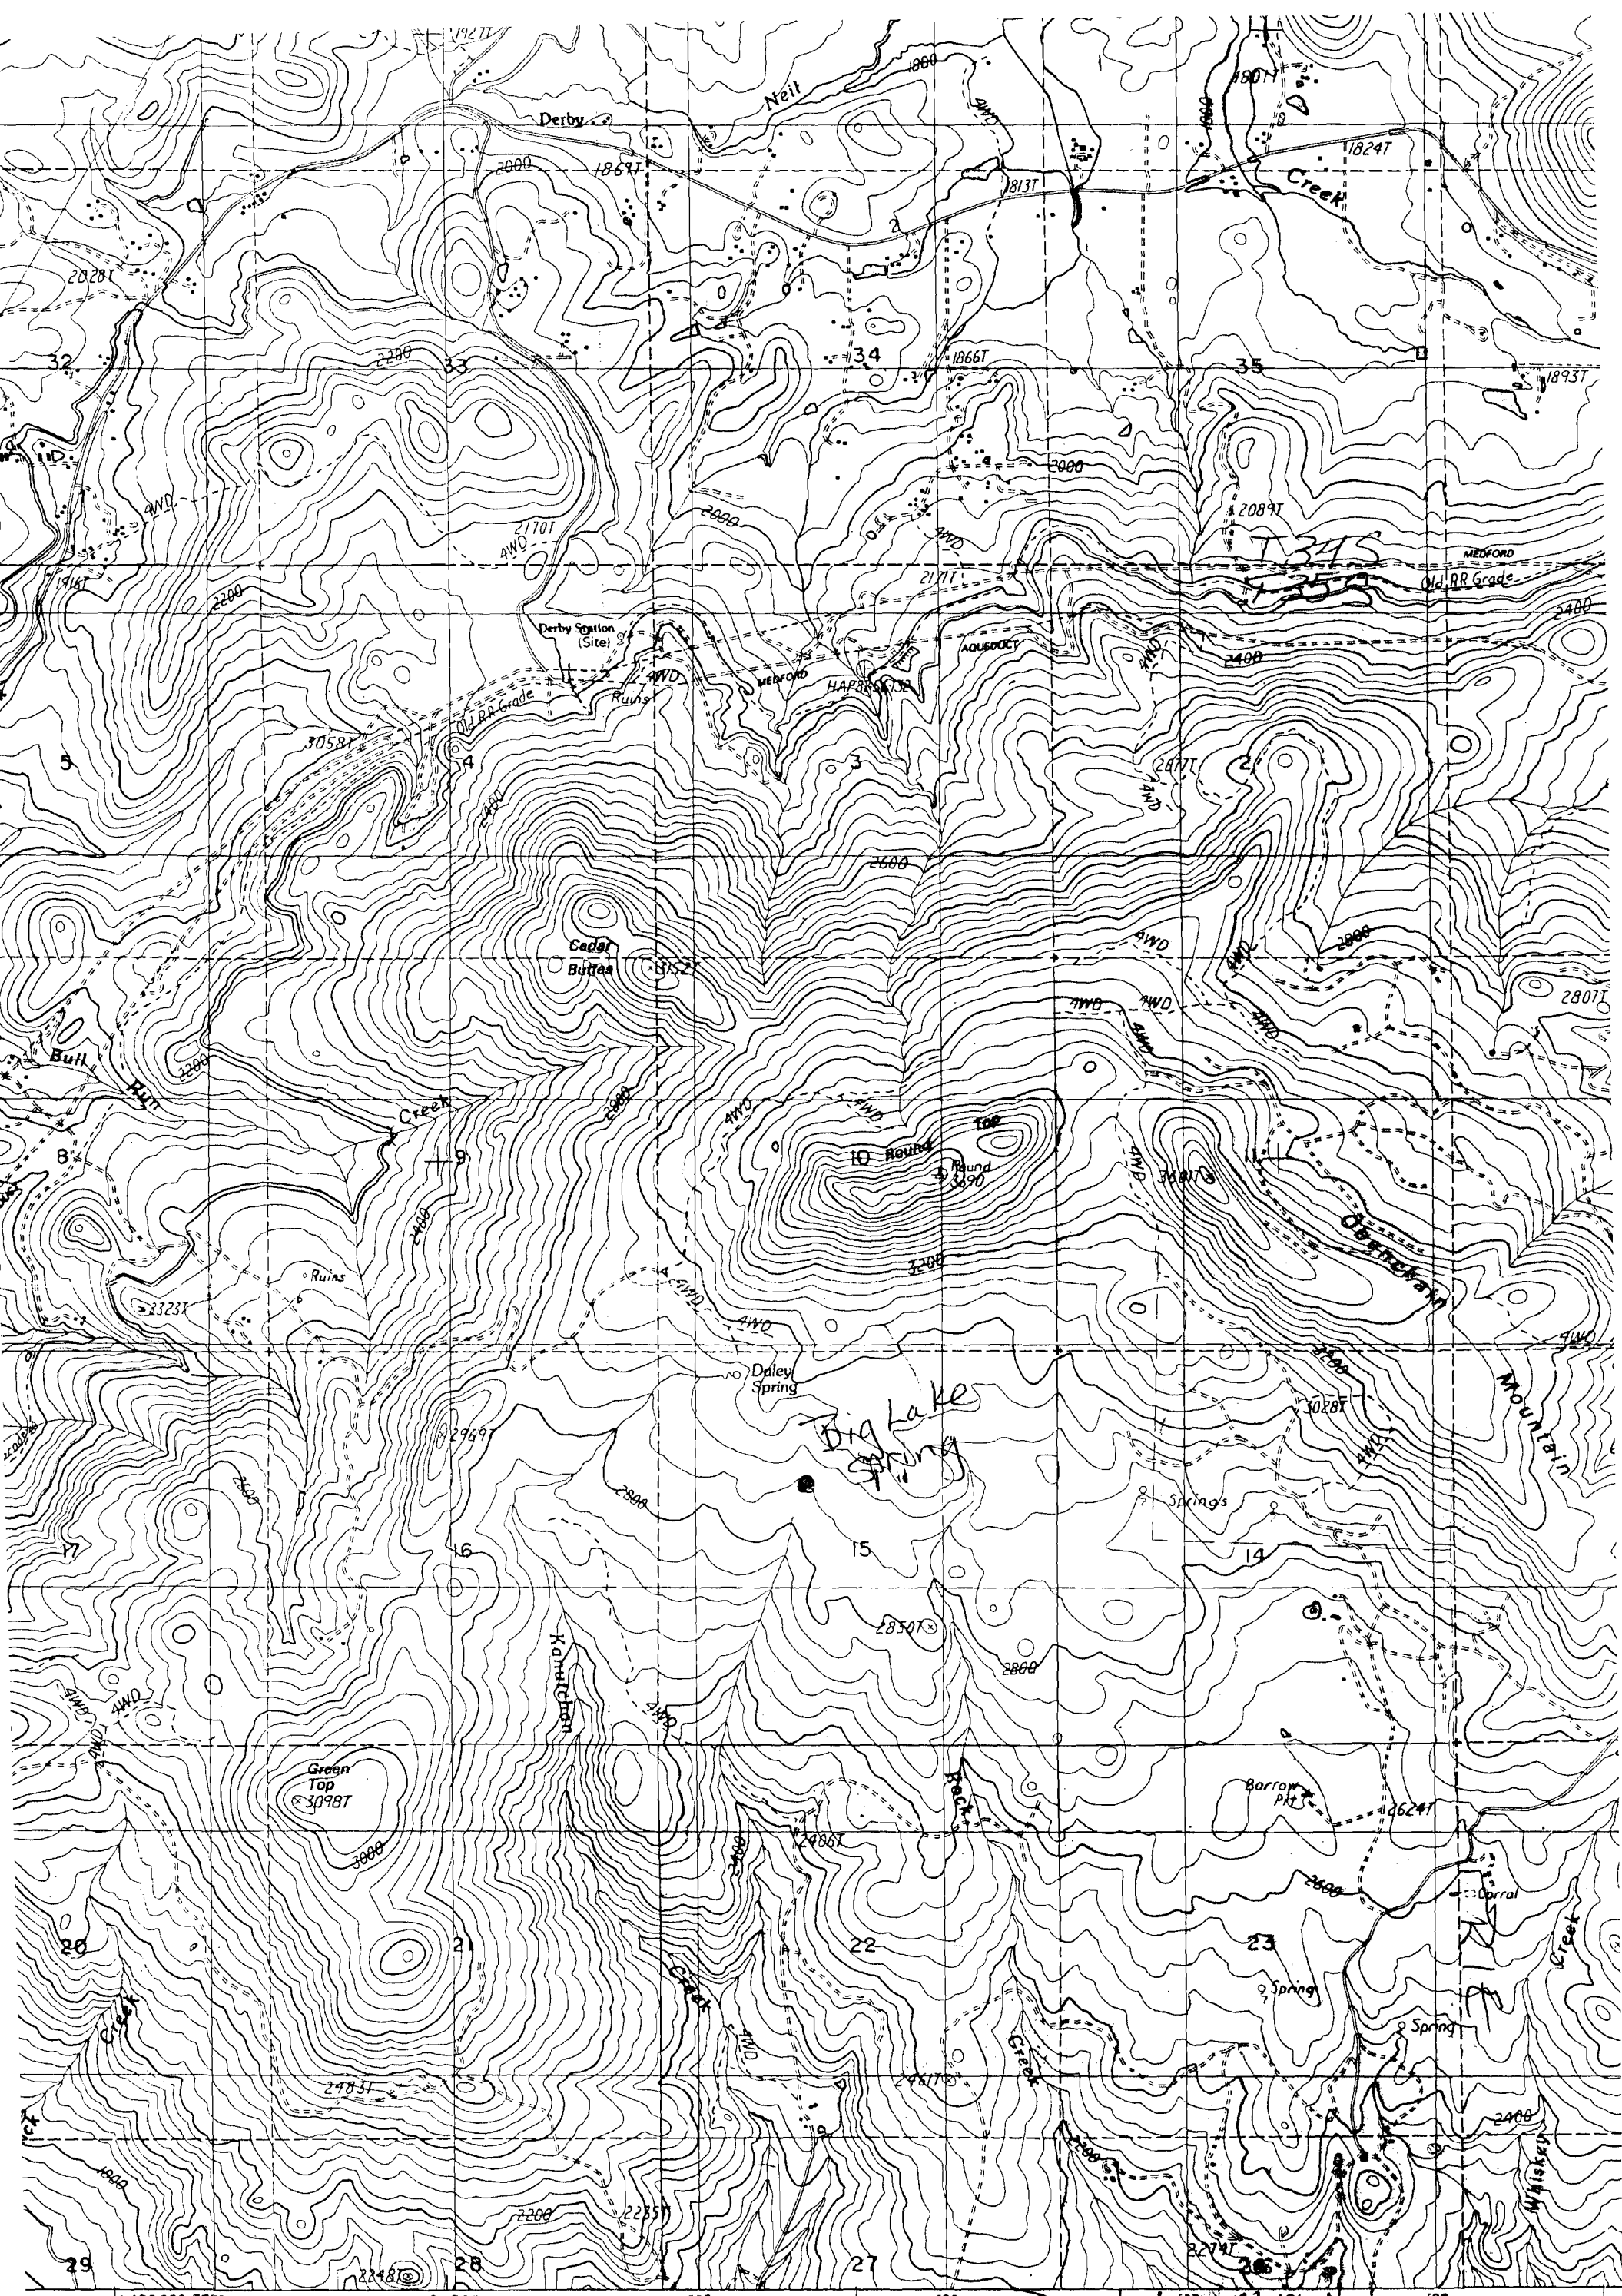

Application No. **R-79198**

Permit No. **11125**

PROVISIONAL MAP

SCALE 1:24 000




CONTOUR INTERVAL 40 FEET

OREGON

QUADRANGLE LOCATION

1	2	3	4
Trail			

No Final Proof Map available

No Permit Map available