


UNITED STATES  
DEPARTMENT OF THE INTERIOR  
GEOLOGICAL SURVEY

Lakecreek NE Quad  
Scale 1:24000

Application No. 276204

Permit No. 306

Salt  
Creek  
Ridge

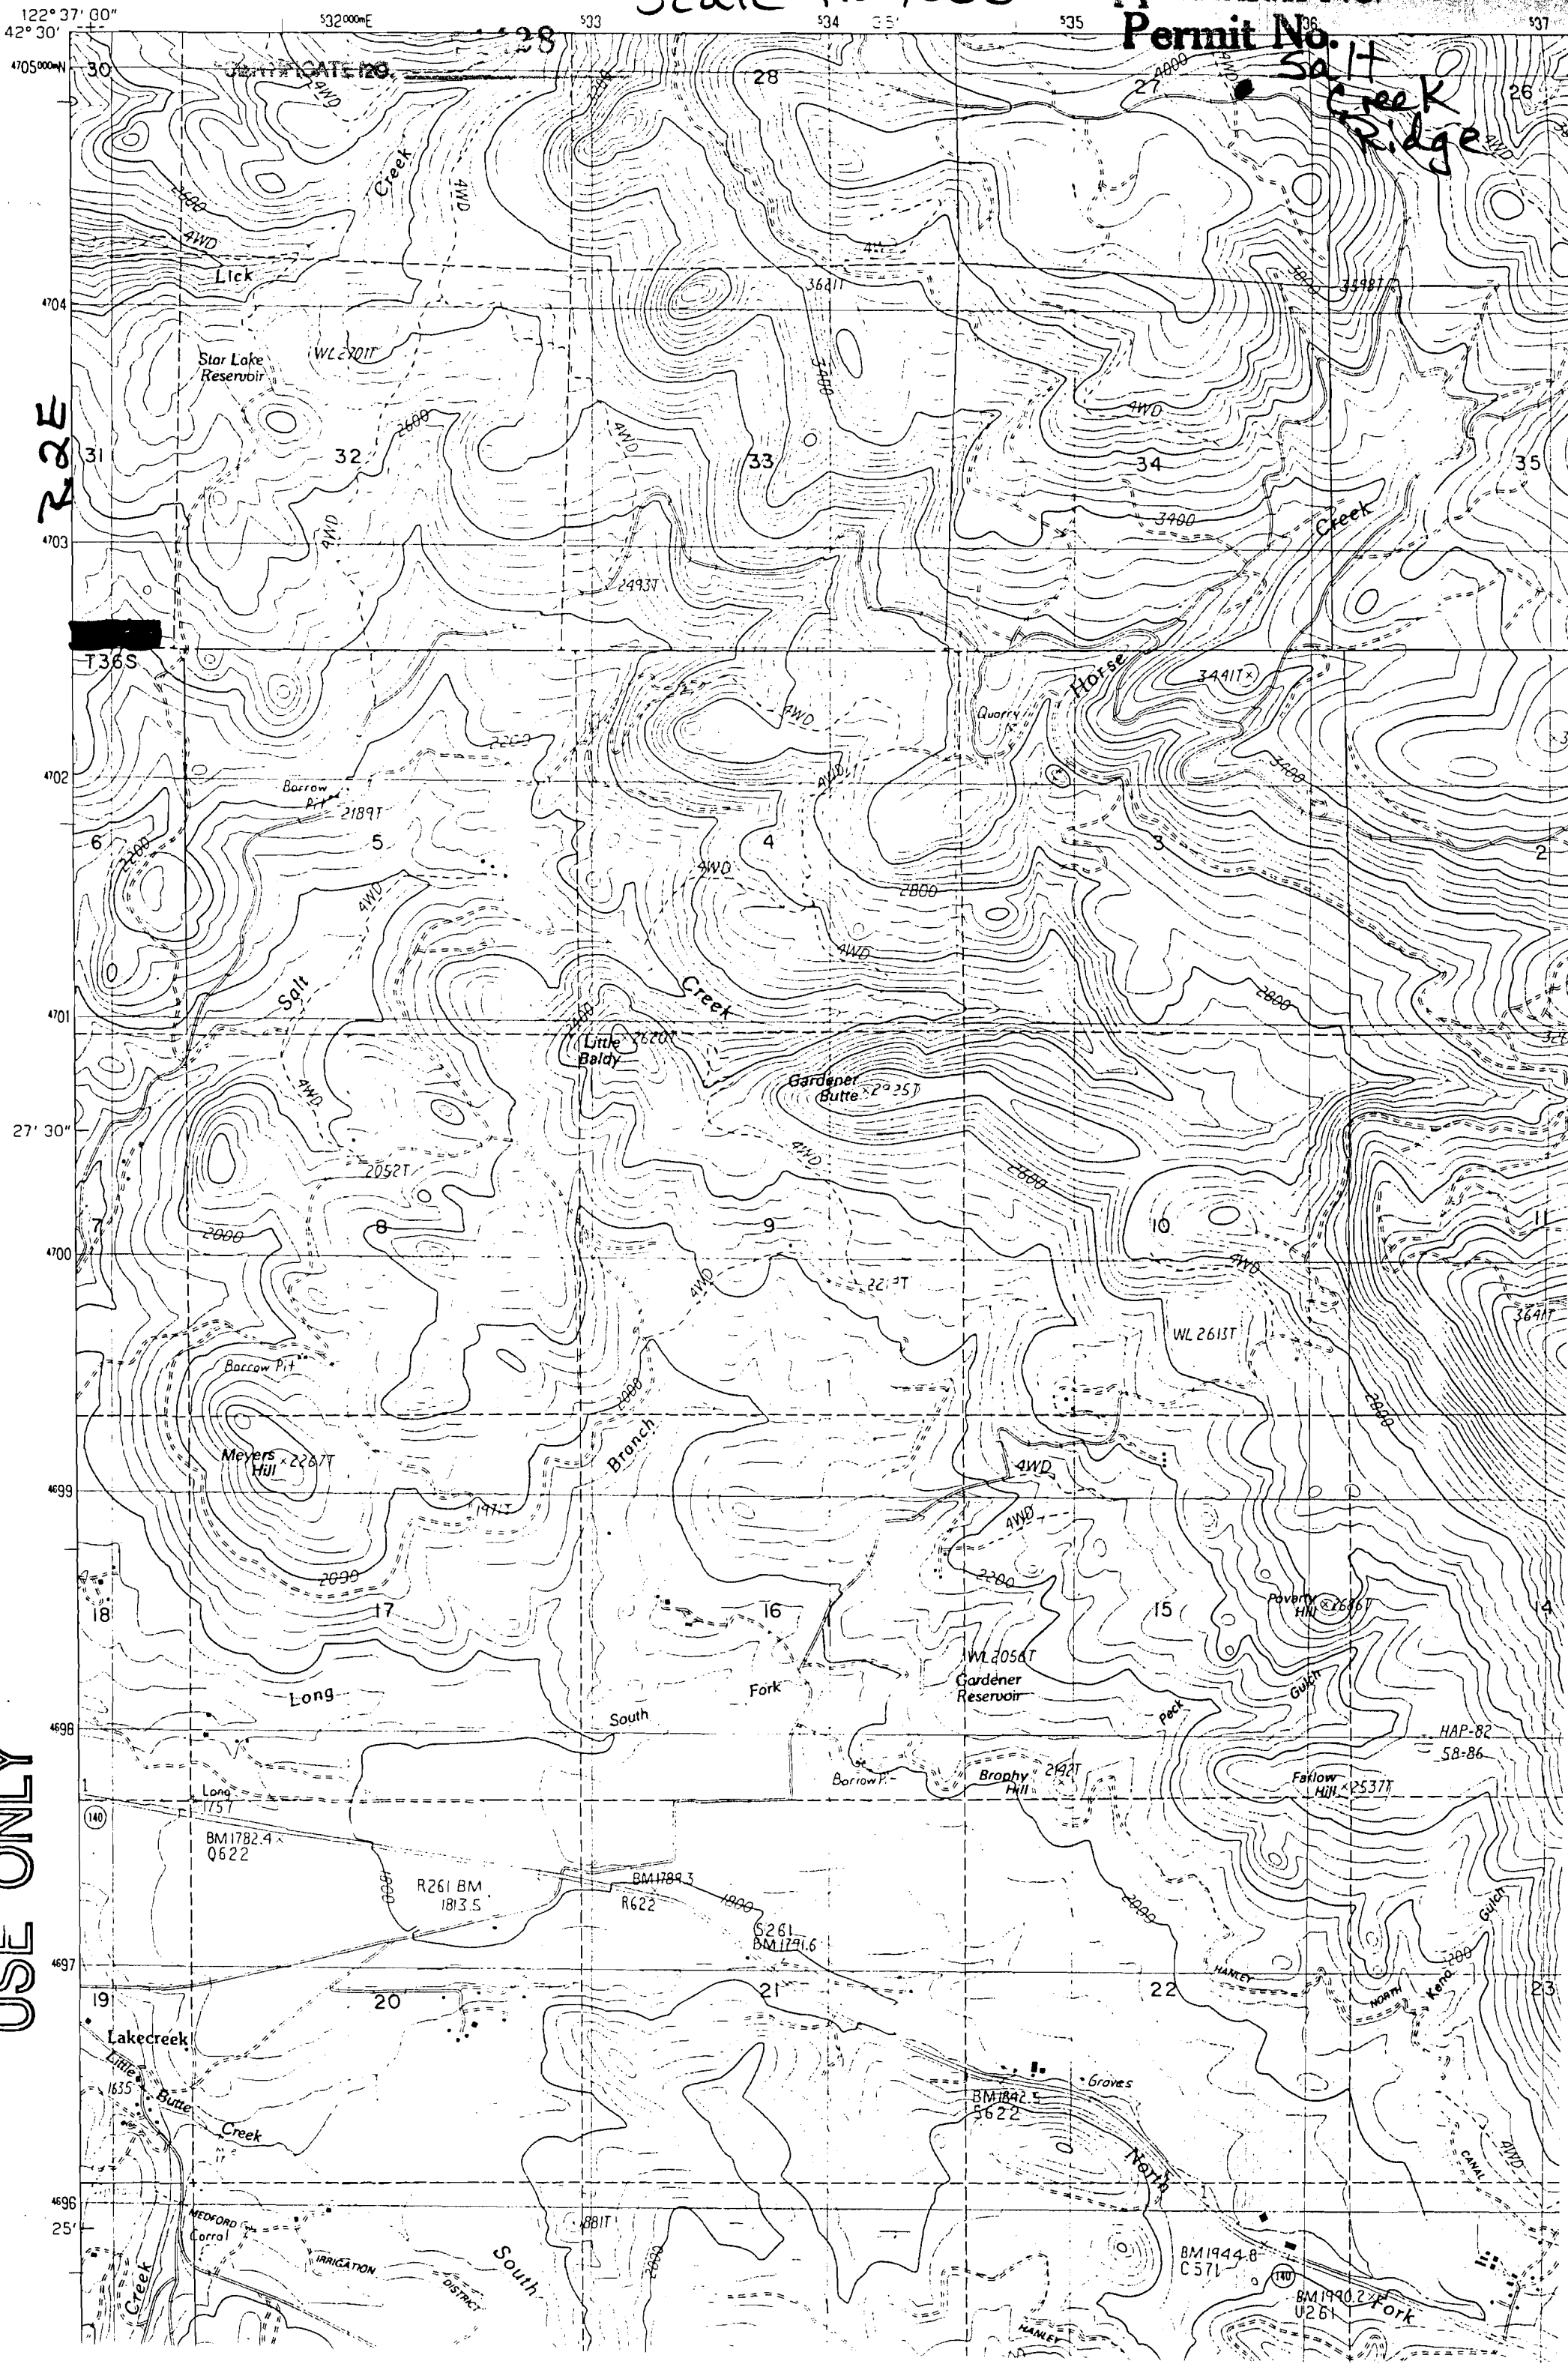

USE ONLY

No Final Proof Map available

No Permit Map available