


Application No. K 79210  
Permit No.

7131

Scale 1:24000

BROWNSBORO QUADRANGLE  
OREGON—JACKSON CO.  
7.5 MINUTE SERIES (TOPOGRAPHIC)

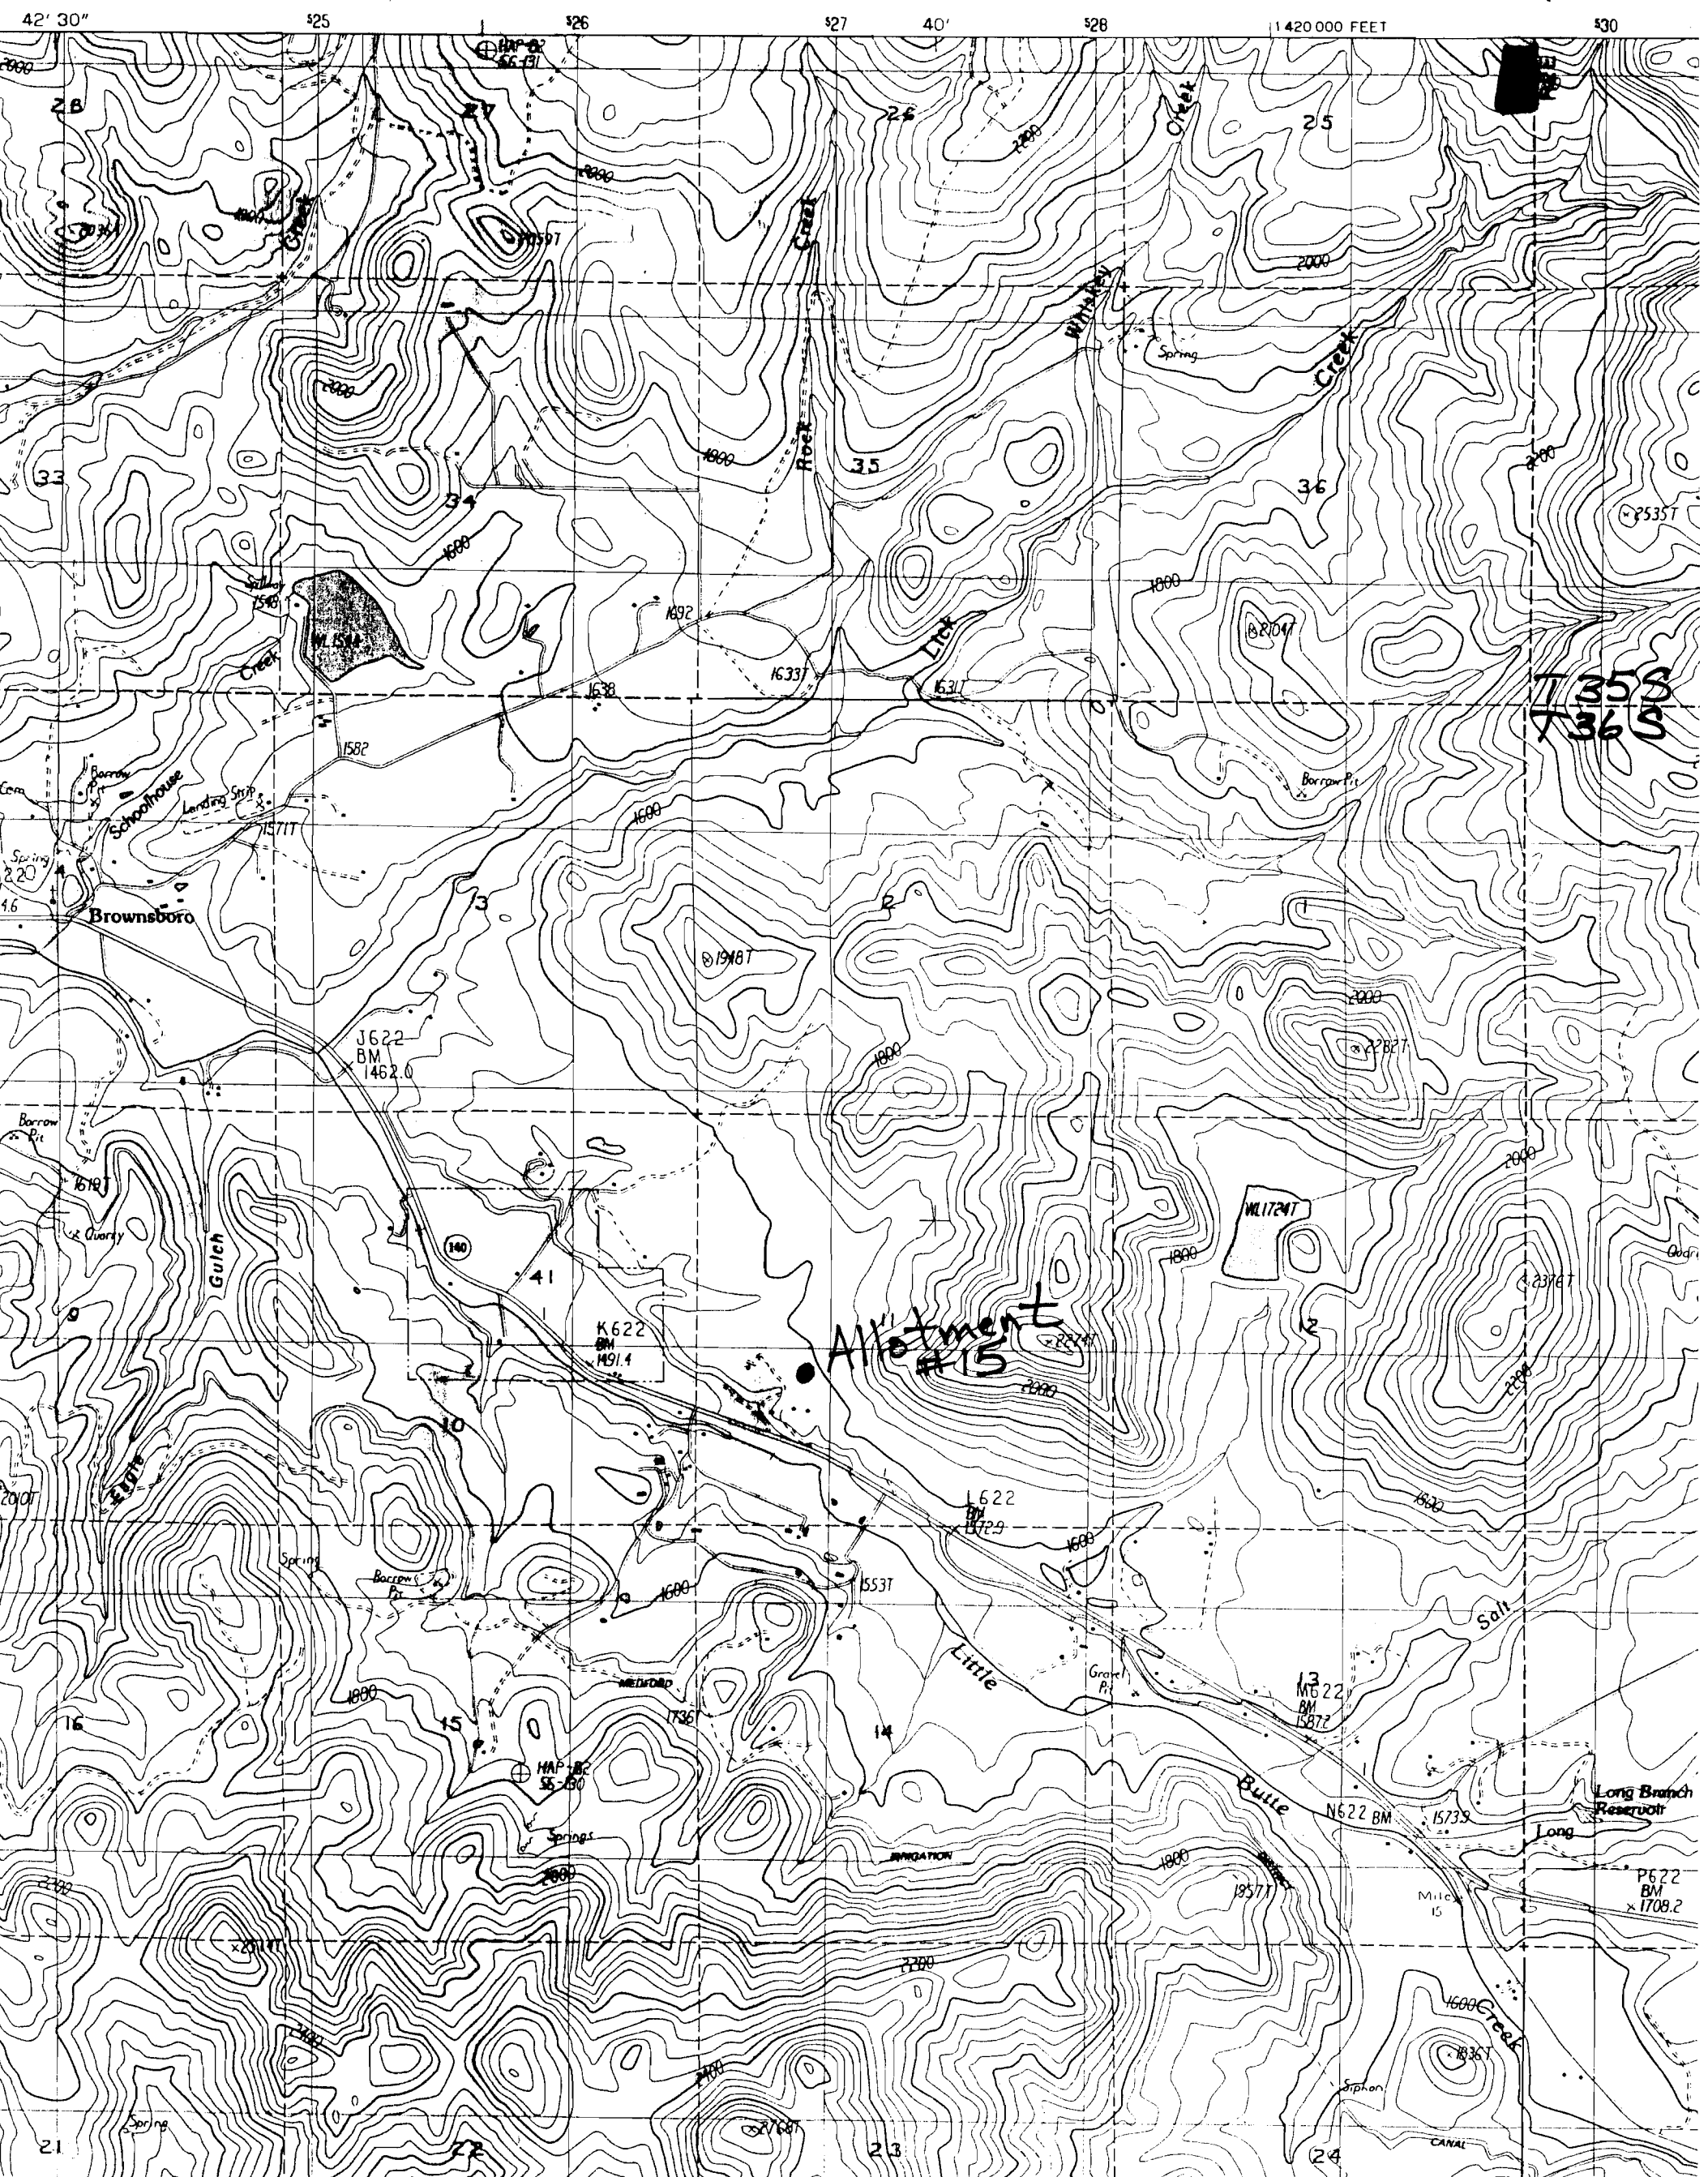

No Final Proof Map available

No Permit Map available