


CERTIFICATE NO.

71132

Scale 1:24000

LAKECREEK QUADRANGLE
OREGON-JACKSON CO.
7.5 MINUTE SERIES (TOPOGRAPHIC)

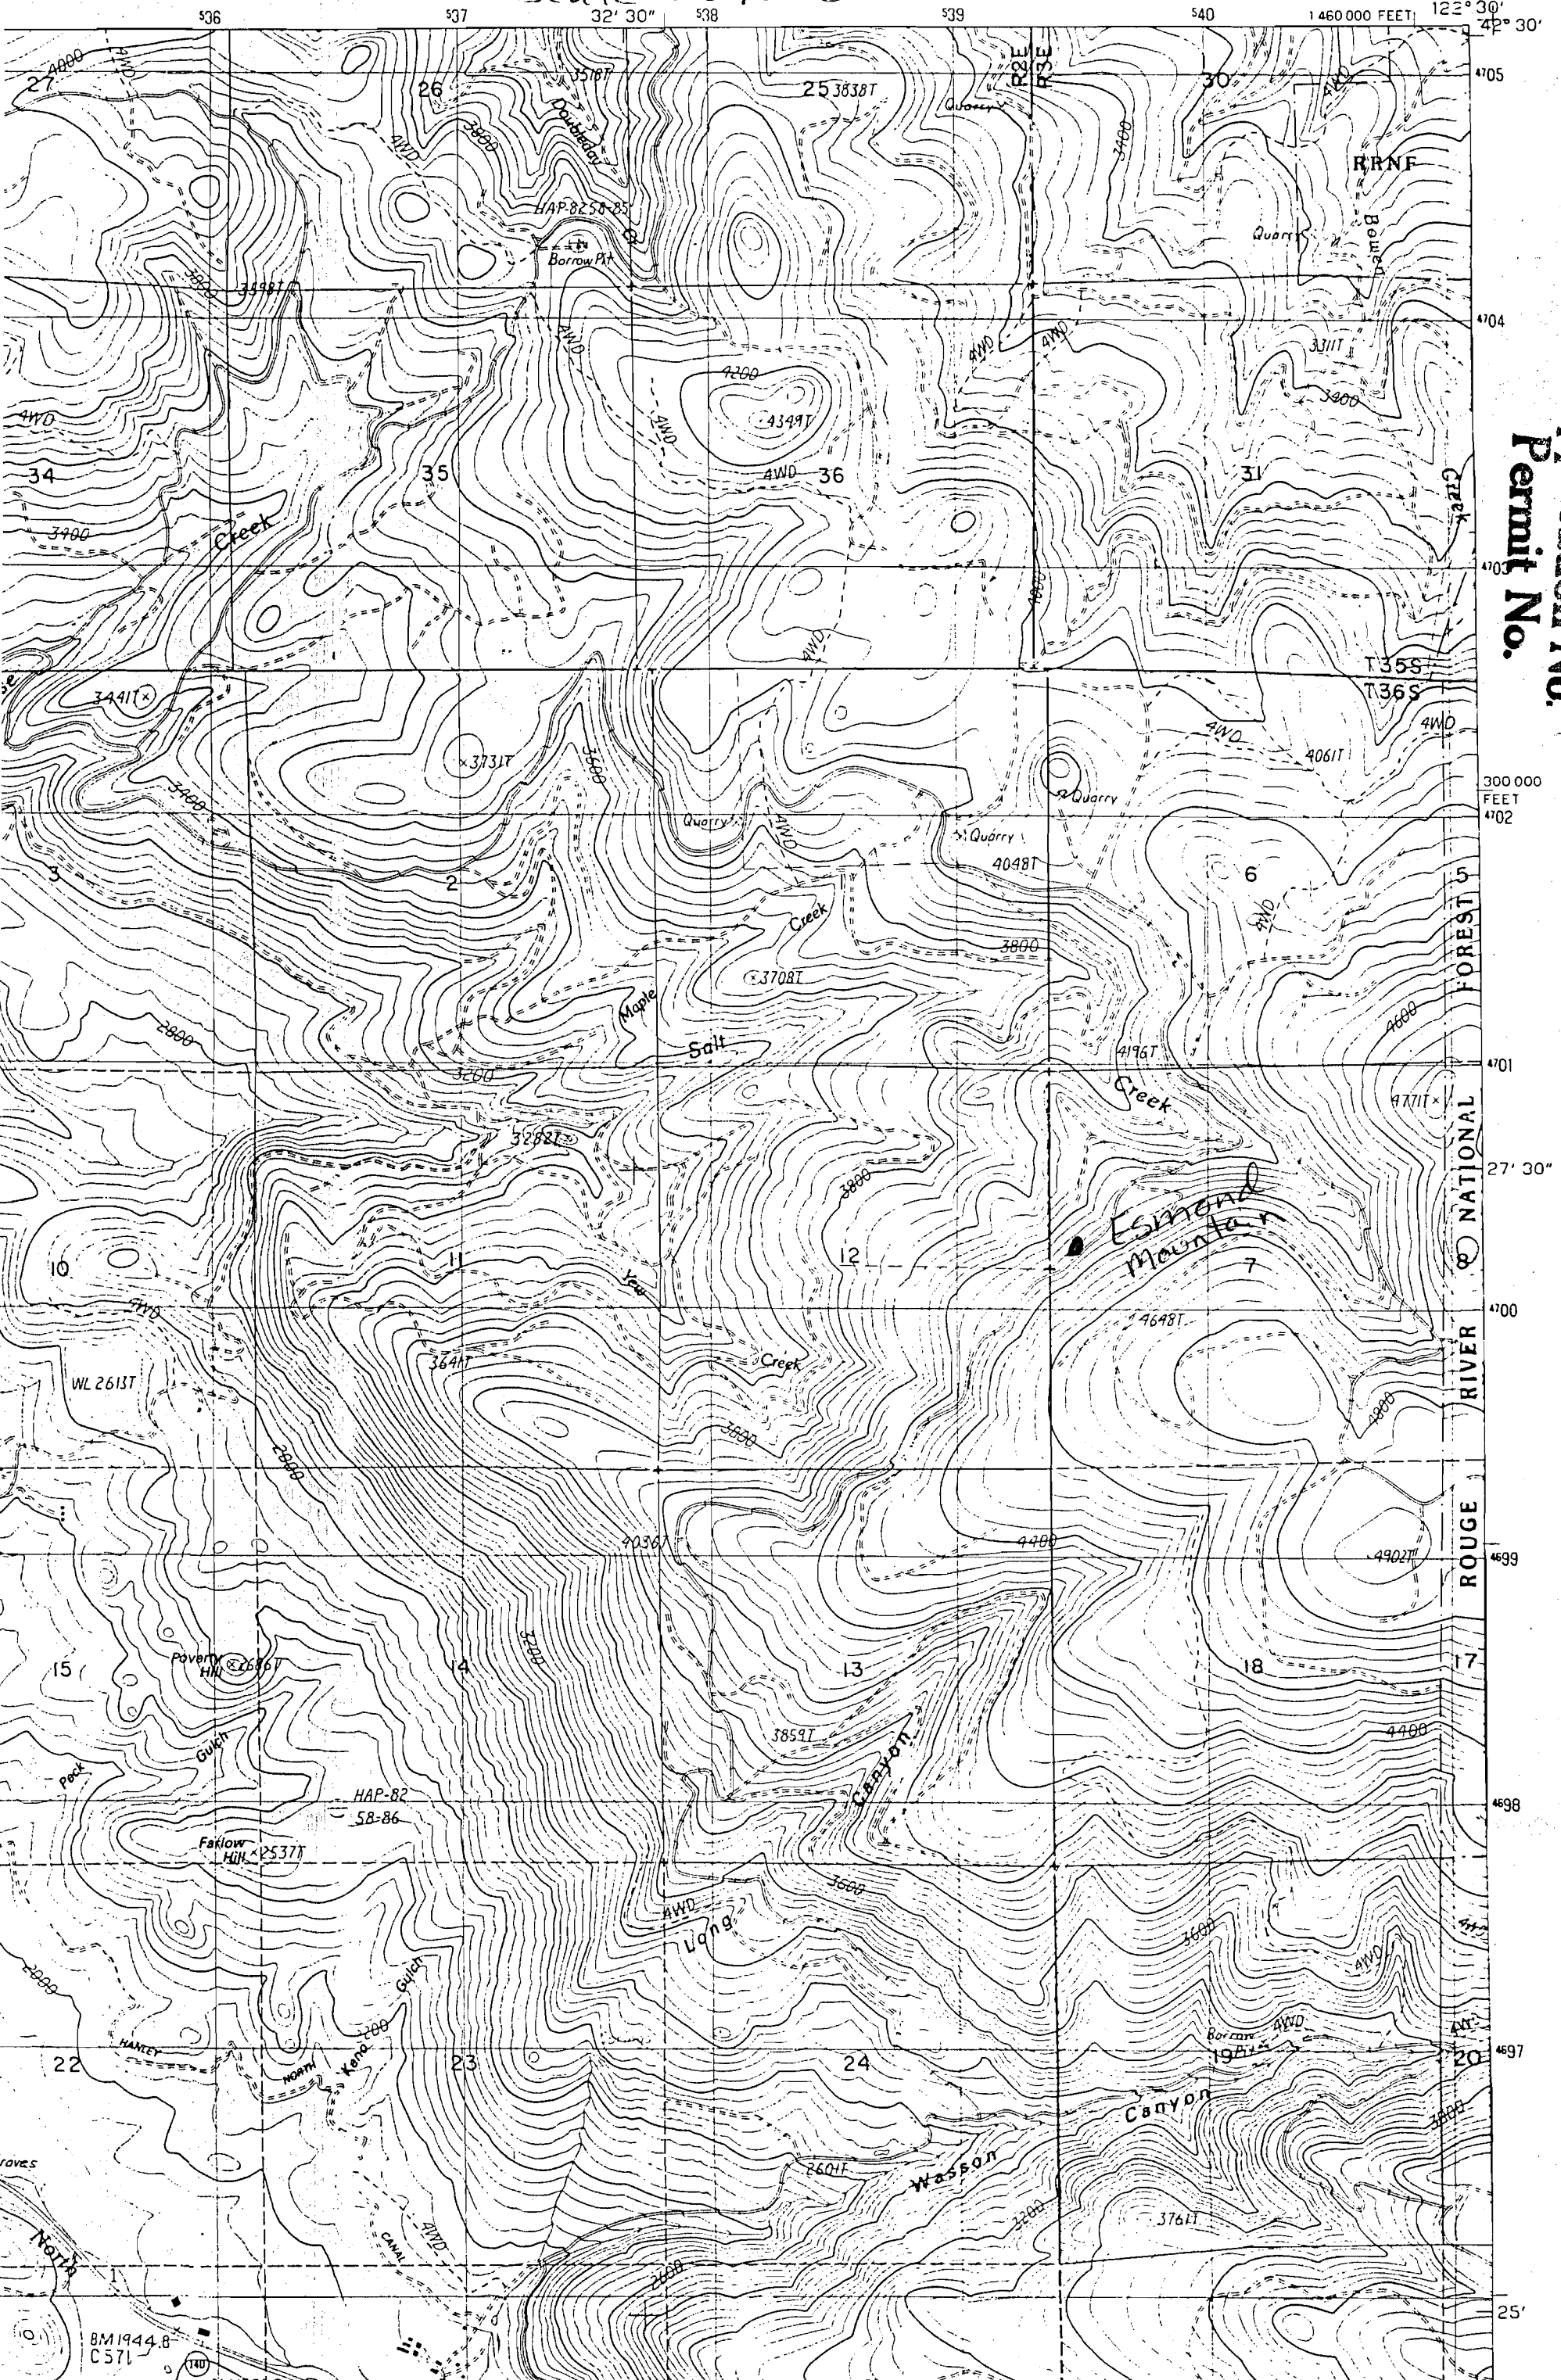

Application No. 279212
Permit No.

USE ONLY