


Application No R-79214
Permit No.

71133

CERTIFICATE NO

UNITED STATES
DEPARTMENT OF THE INTERIOR
GEOLOGICAL SURVEY

Lakecreek NE Quad.
Scale 1:24000

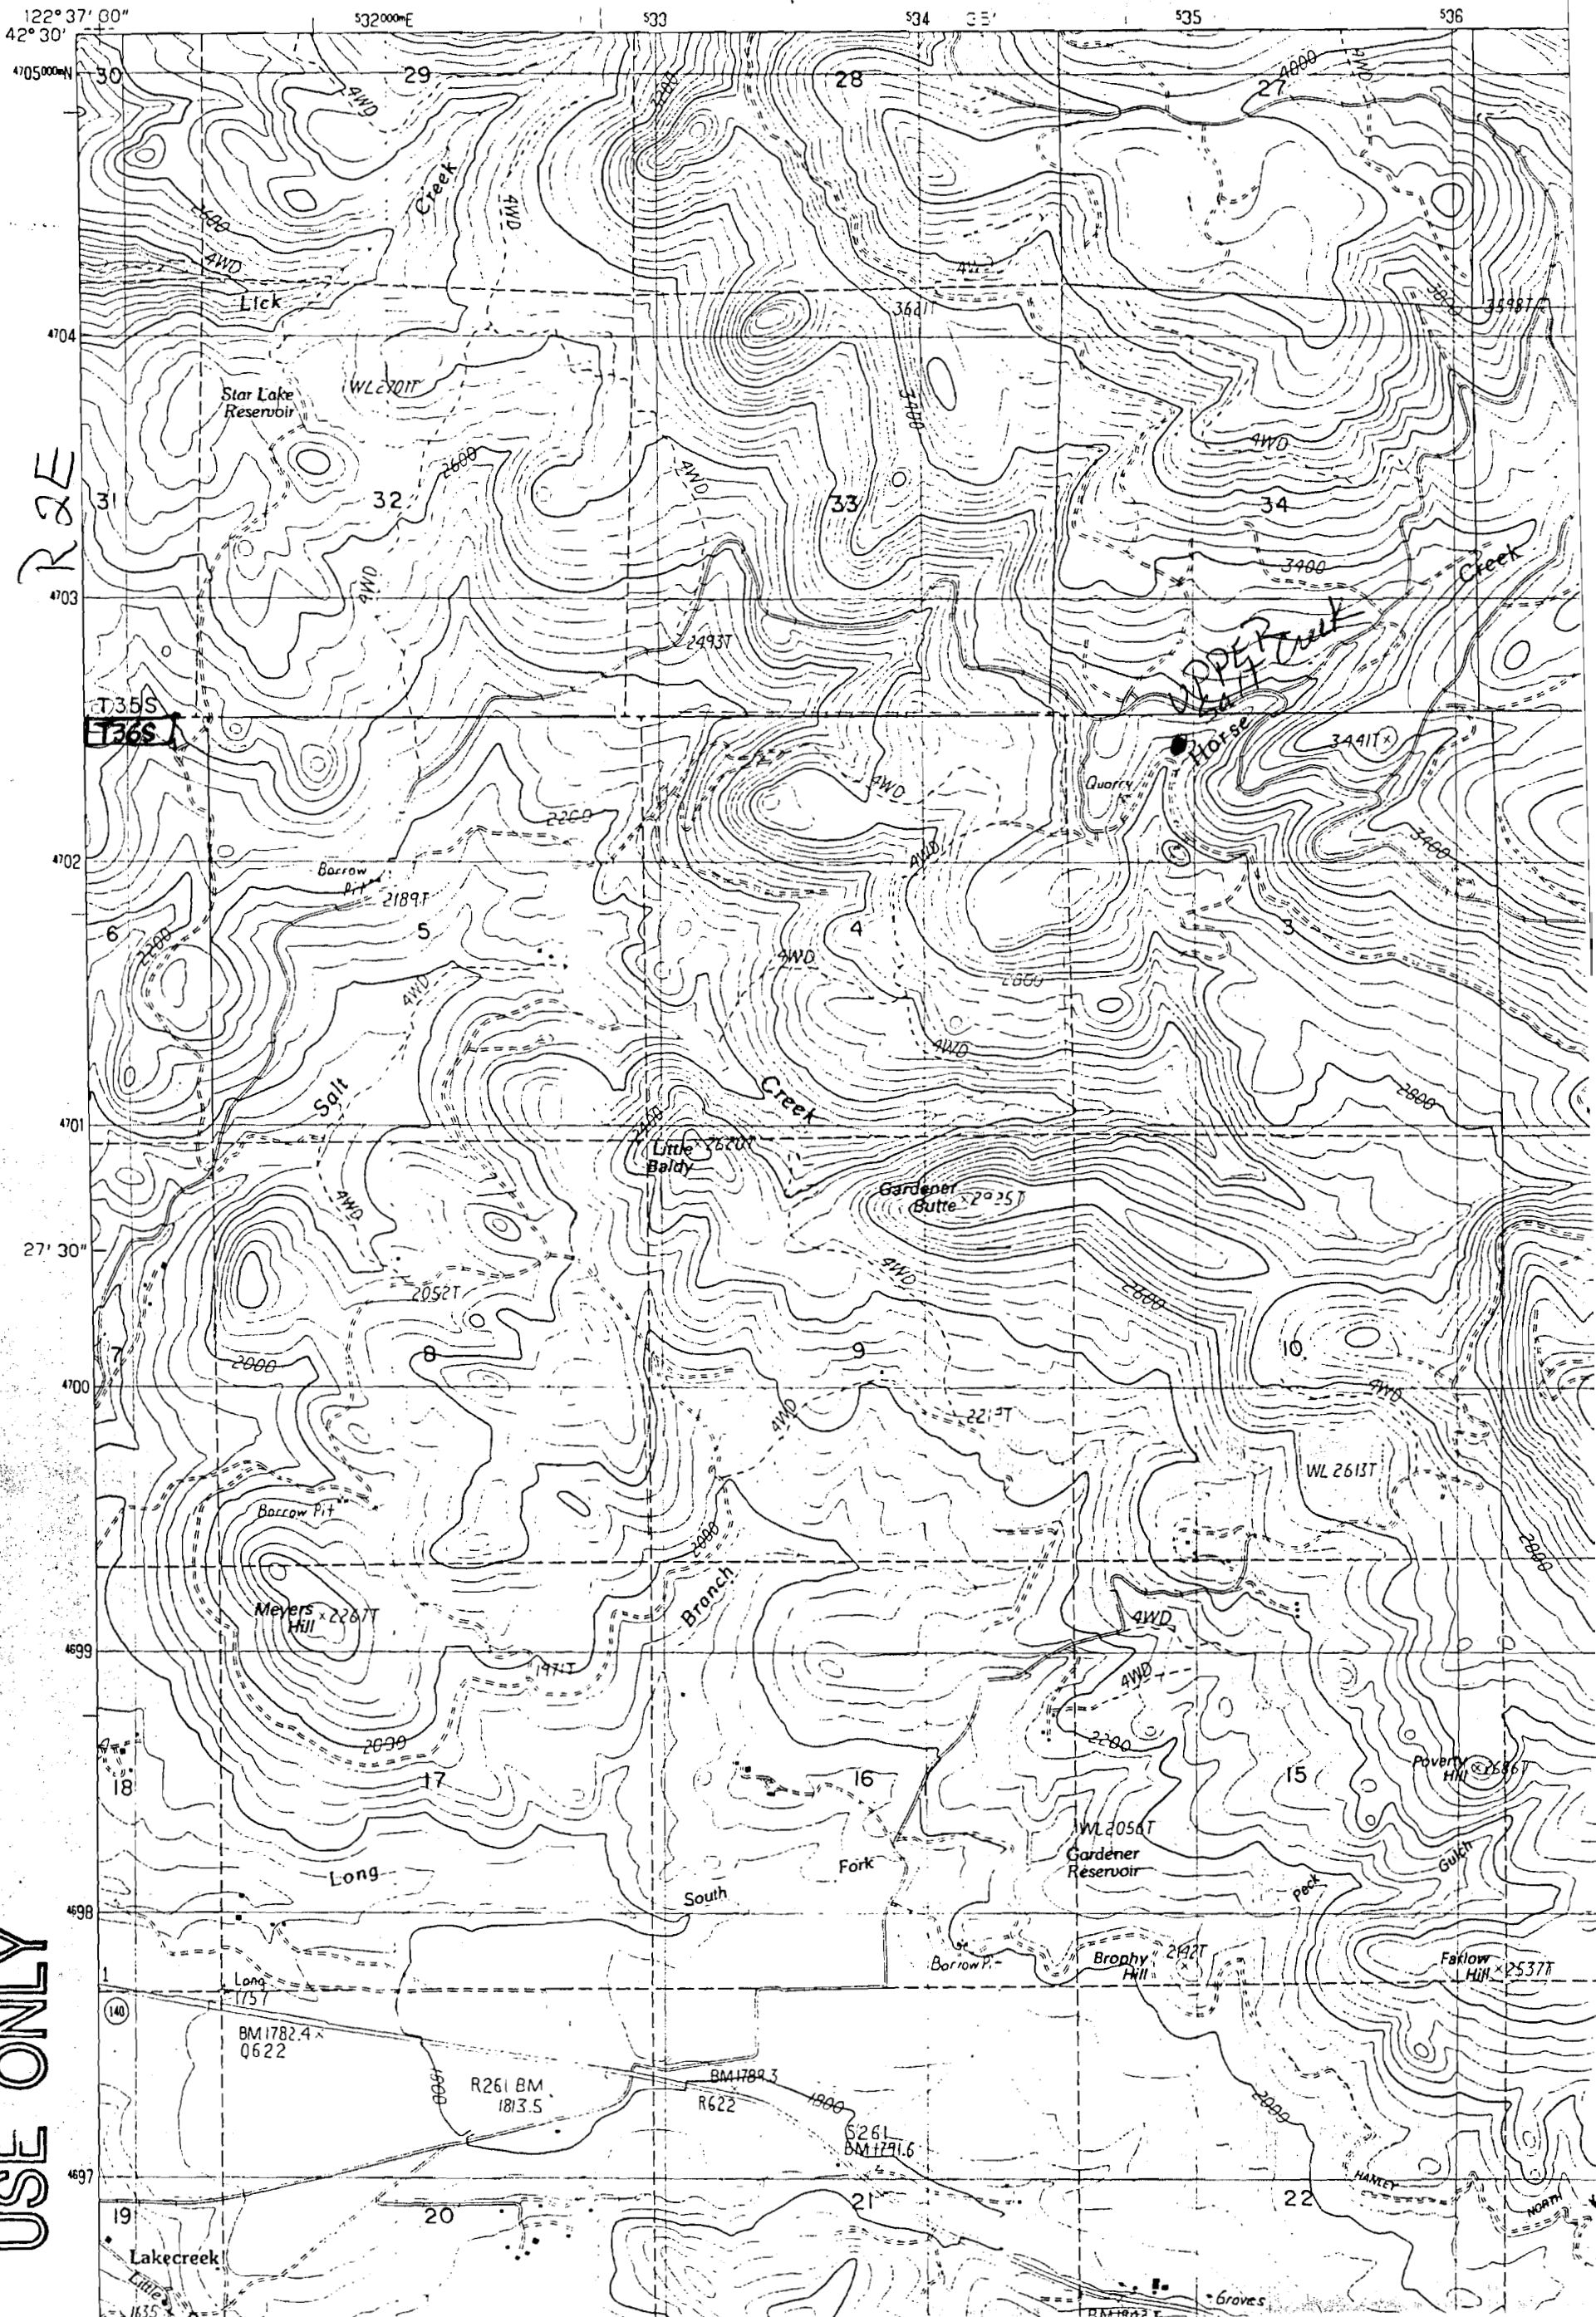

No Final Proof Map available

No Permit Map available