



Application No. **792114**
Permit No.

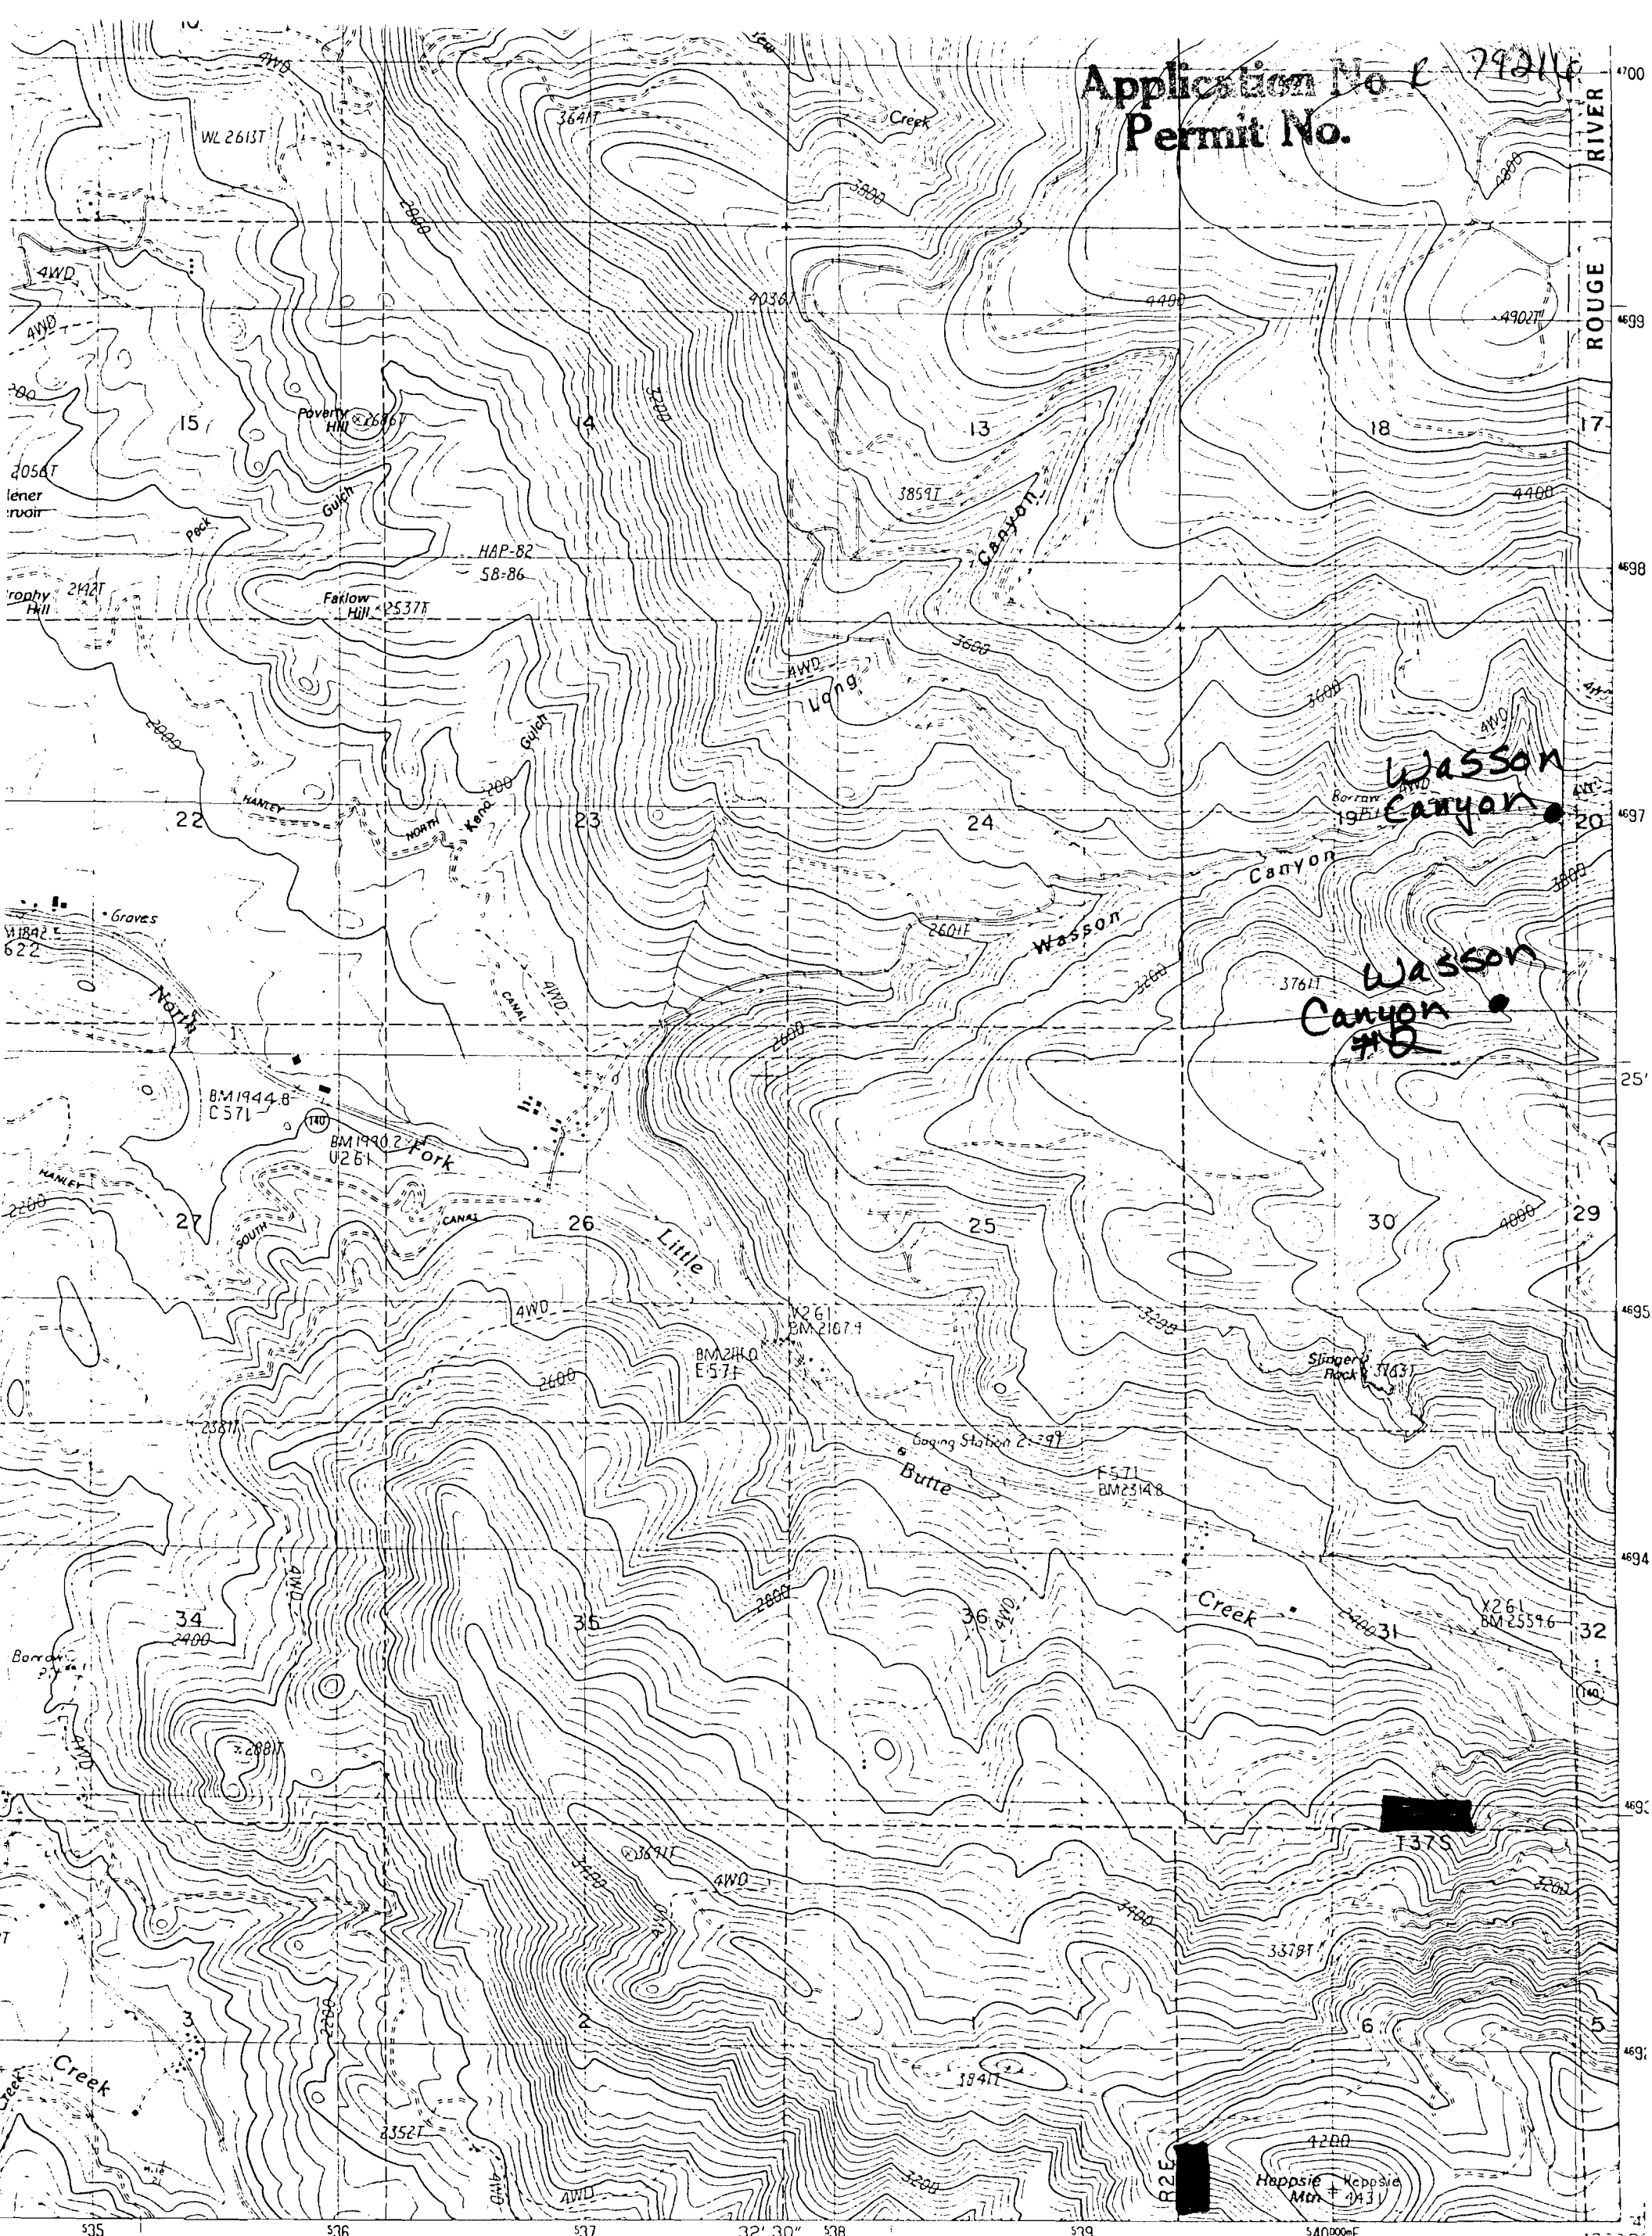


SCALE 1:24 000

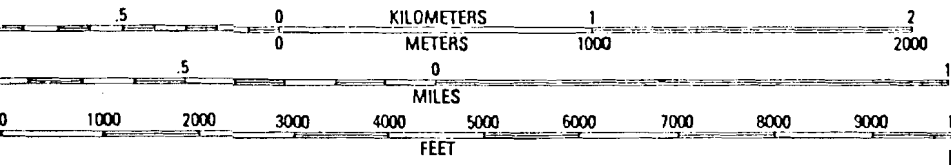

CONTOUR INTERVAL 40 FEET

CONTROL ELEVATIONS SHOWN TO THE NEAREST 0.1 FOOT
OTHER ELEVATIONS SHOWN TO THE NEAREST FOOT
To convert meters to feet multiply by 3.2808
To convert feet to meters multiply by 0.3048

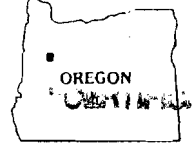

QUADRANGLE LOCATION

1	2	3	1 Obenchain Mtn.
			2 Butte Falls
4		5	3 Big Butte Springs
			4 Brownsboro
			5 Willow Lake
6	7	8	6 Rio Canyon
			7 Grizzly Peak
			8 Robinson Butte

ROAD LEGEND

- Improved Road
Unimproved Road
Trail
○ Interstate Route □ U.S. Route ○ State Route

2010 LAKECREEK, OREG. **NEW**

PROVISIONAL EDITION 1988

No Final Proof Map available

No Permit Map available