


Application No. R-79218
Permit No.

[Scale = 1:24000]

71135

EMIGRANT LAKE QUADRANGLE
OREGON—JACKSON CO.
7.5 MINUTE SERIES (TOPOGRAPHIC)

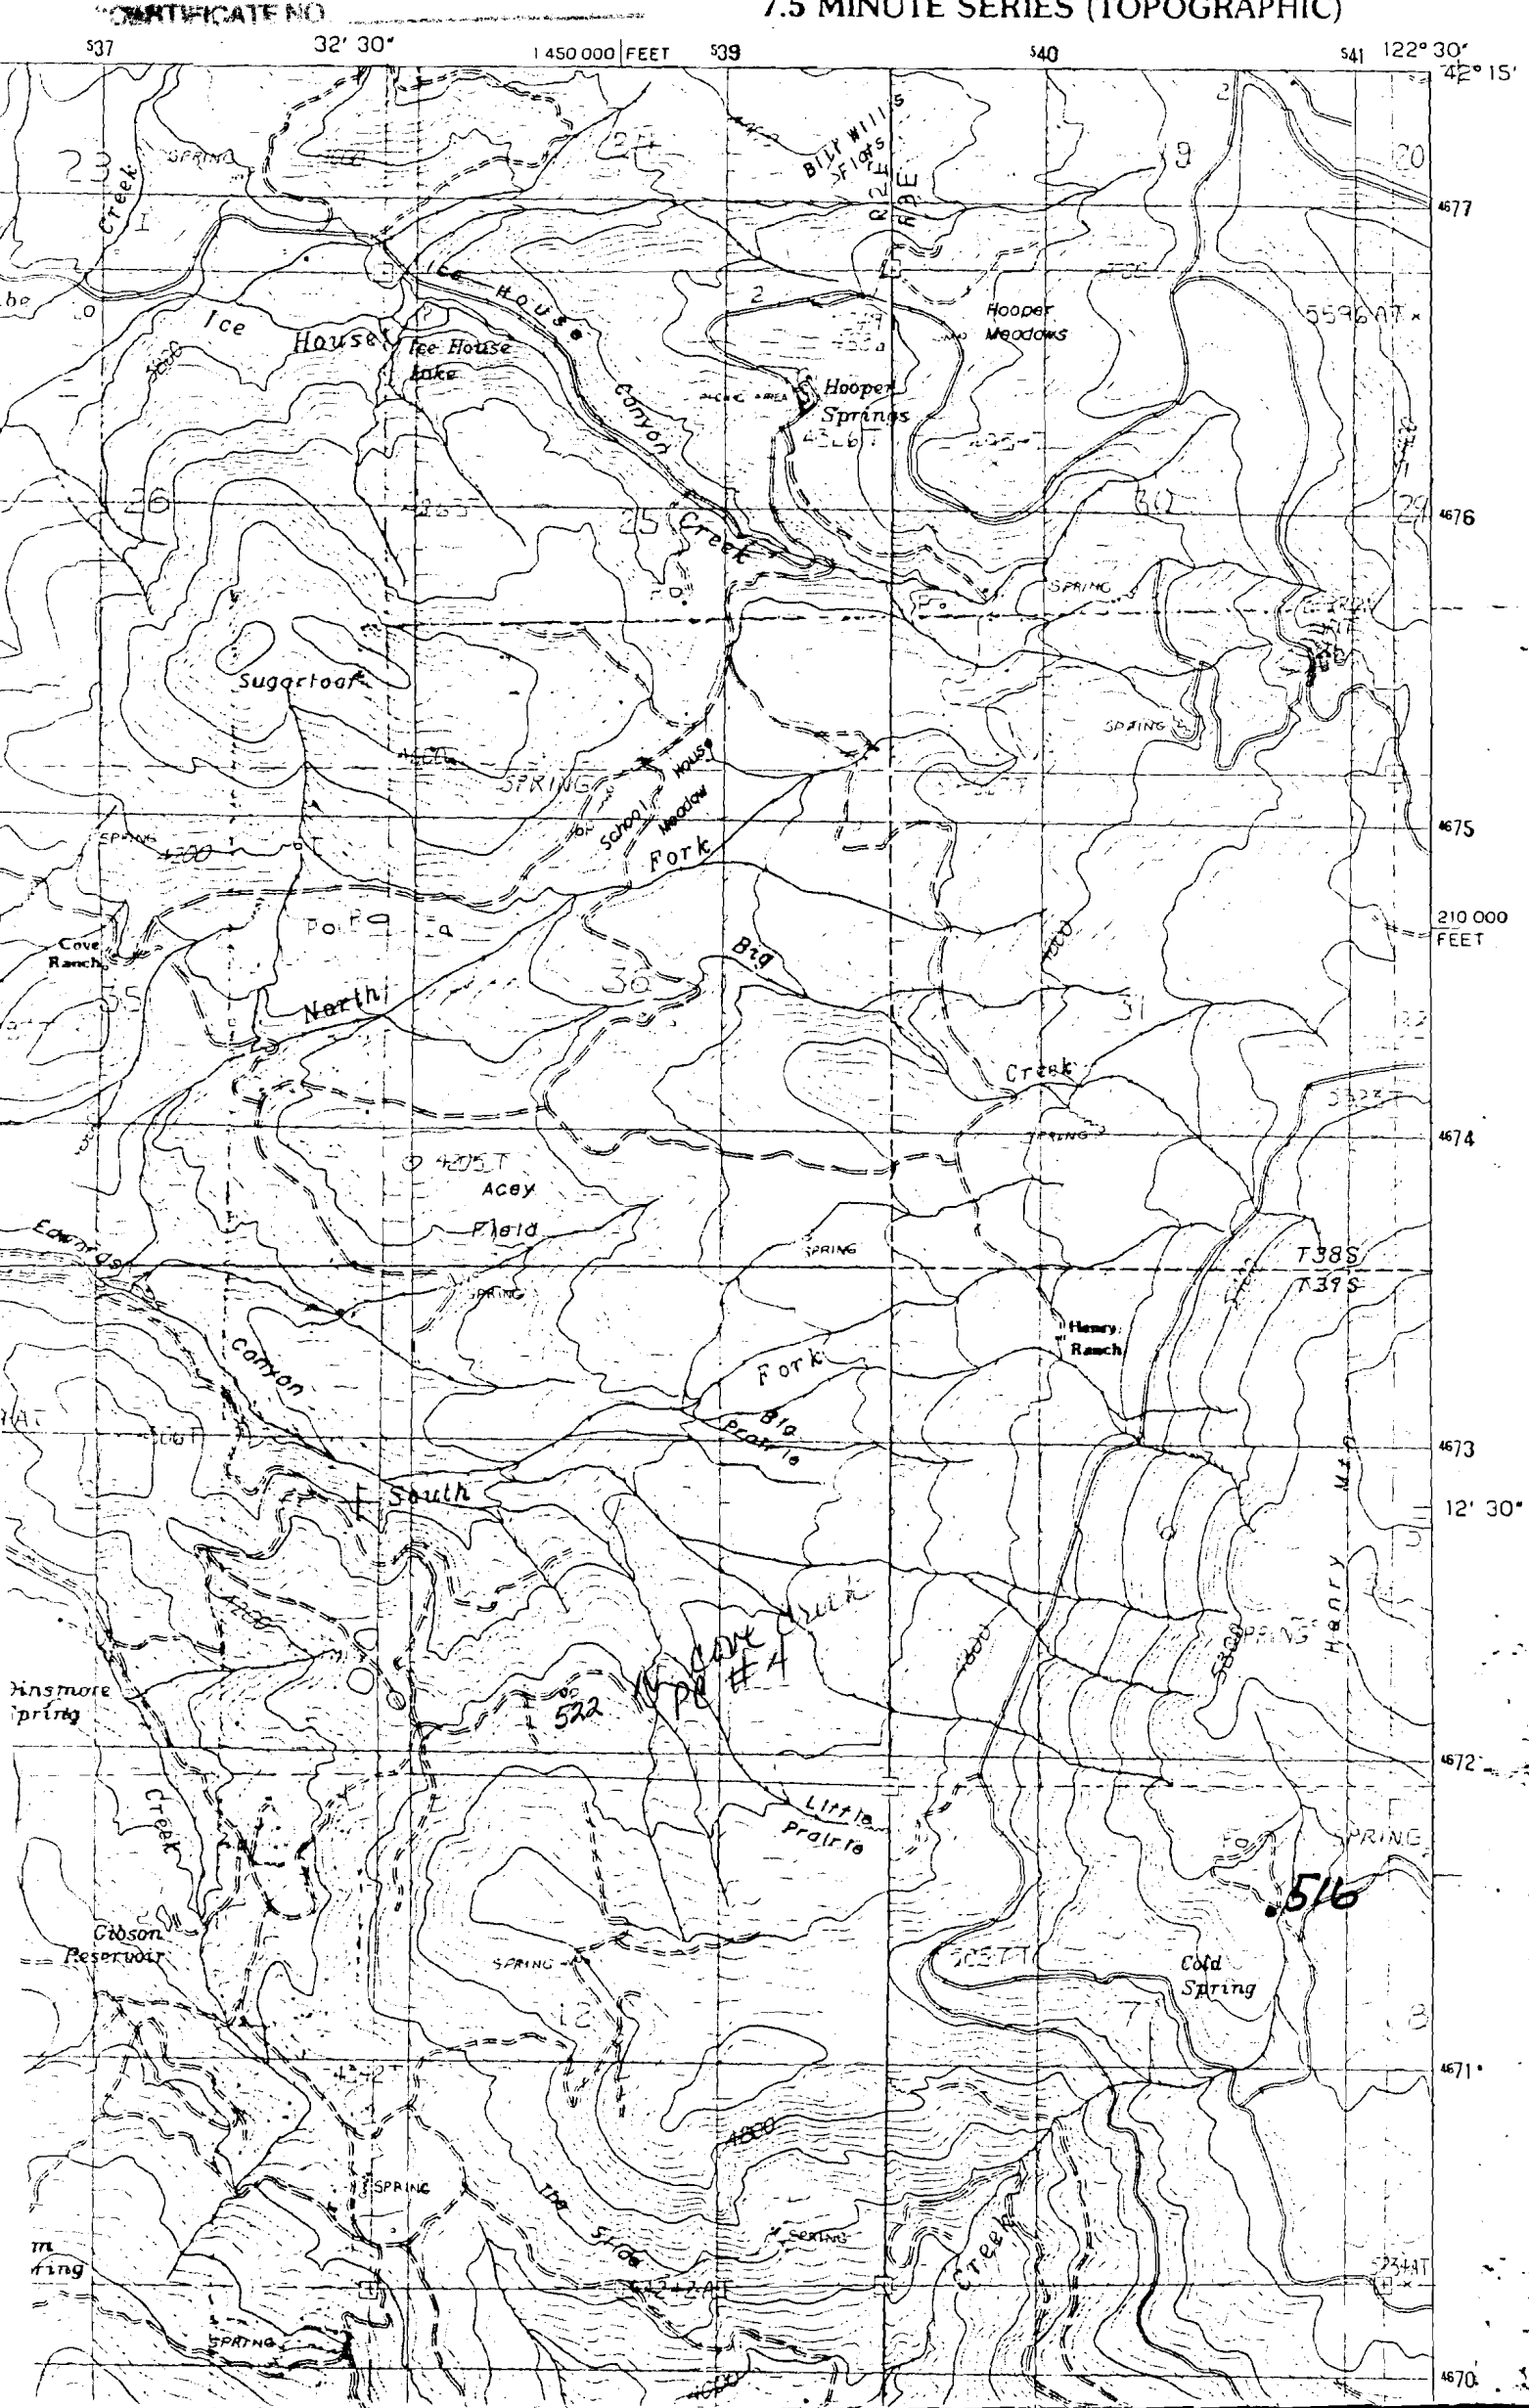

No Final Proof Map available

No Permit Map available