



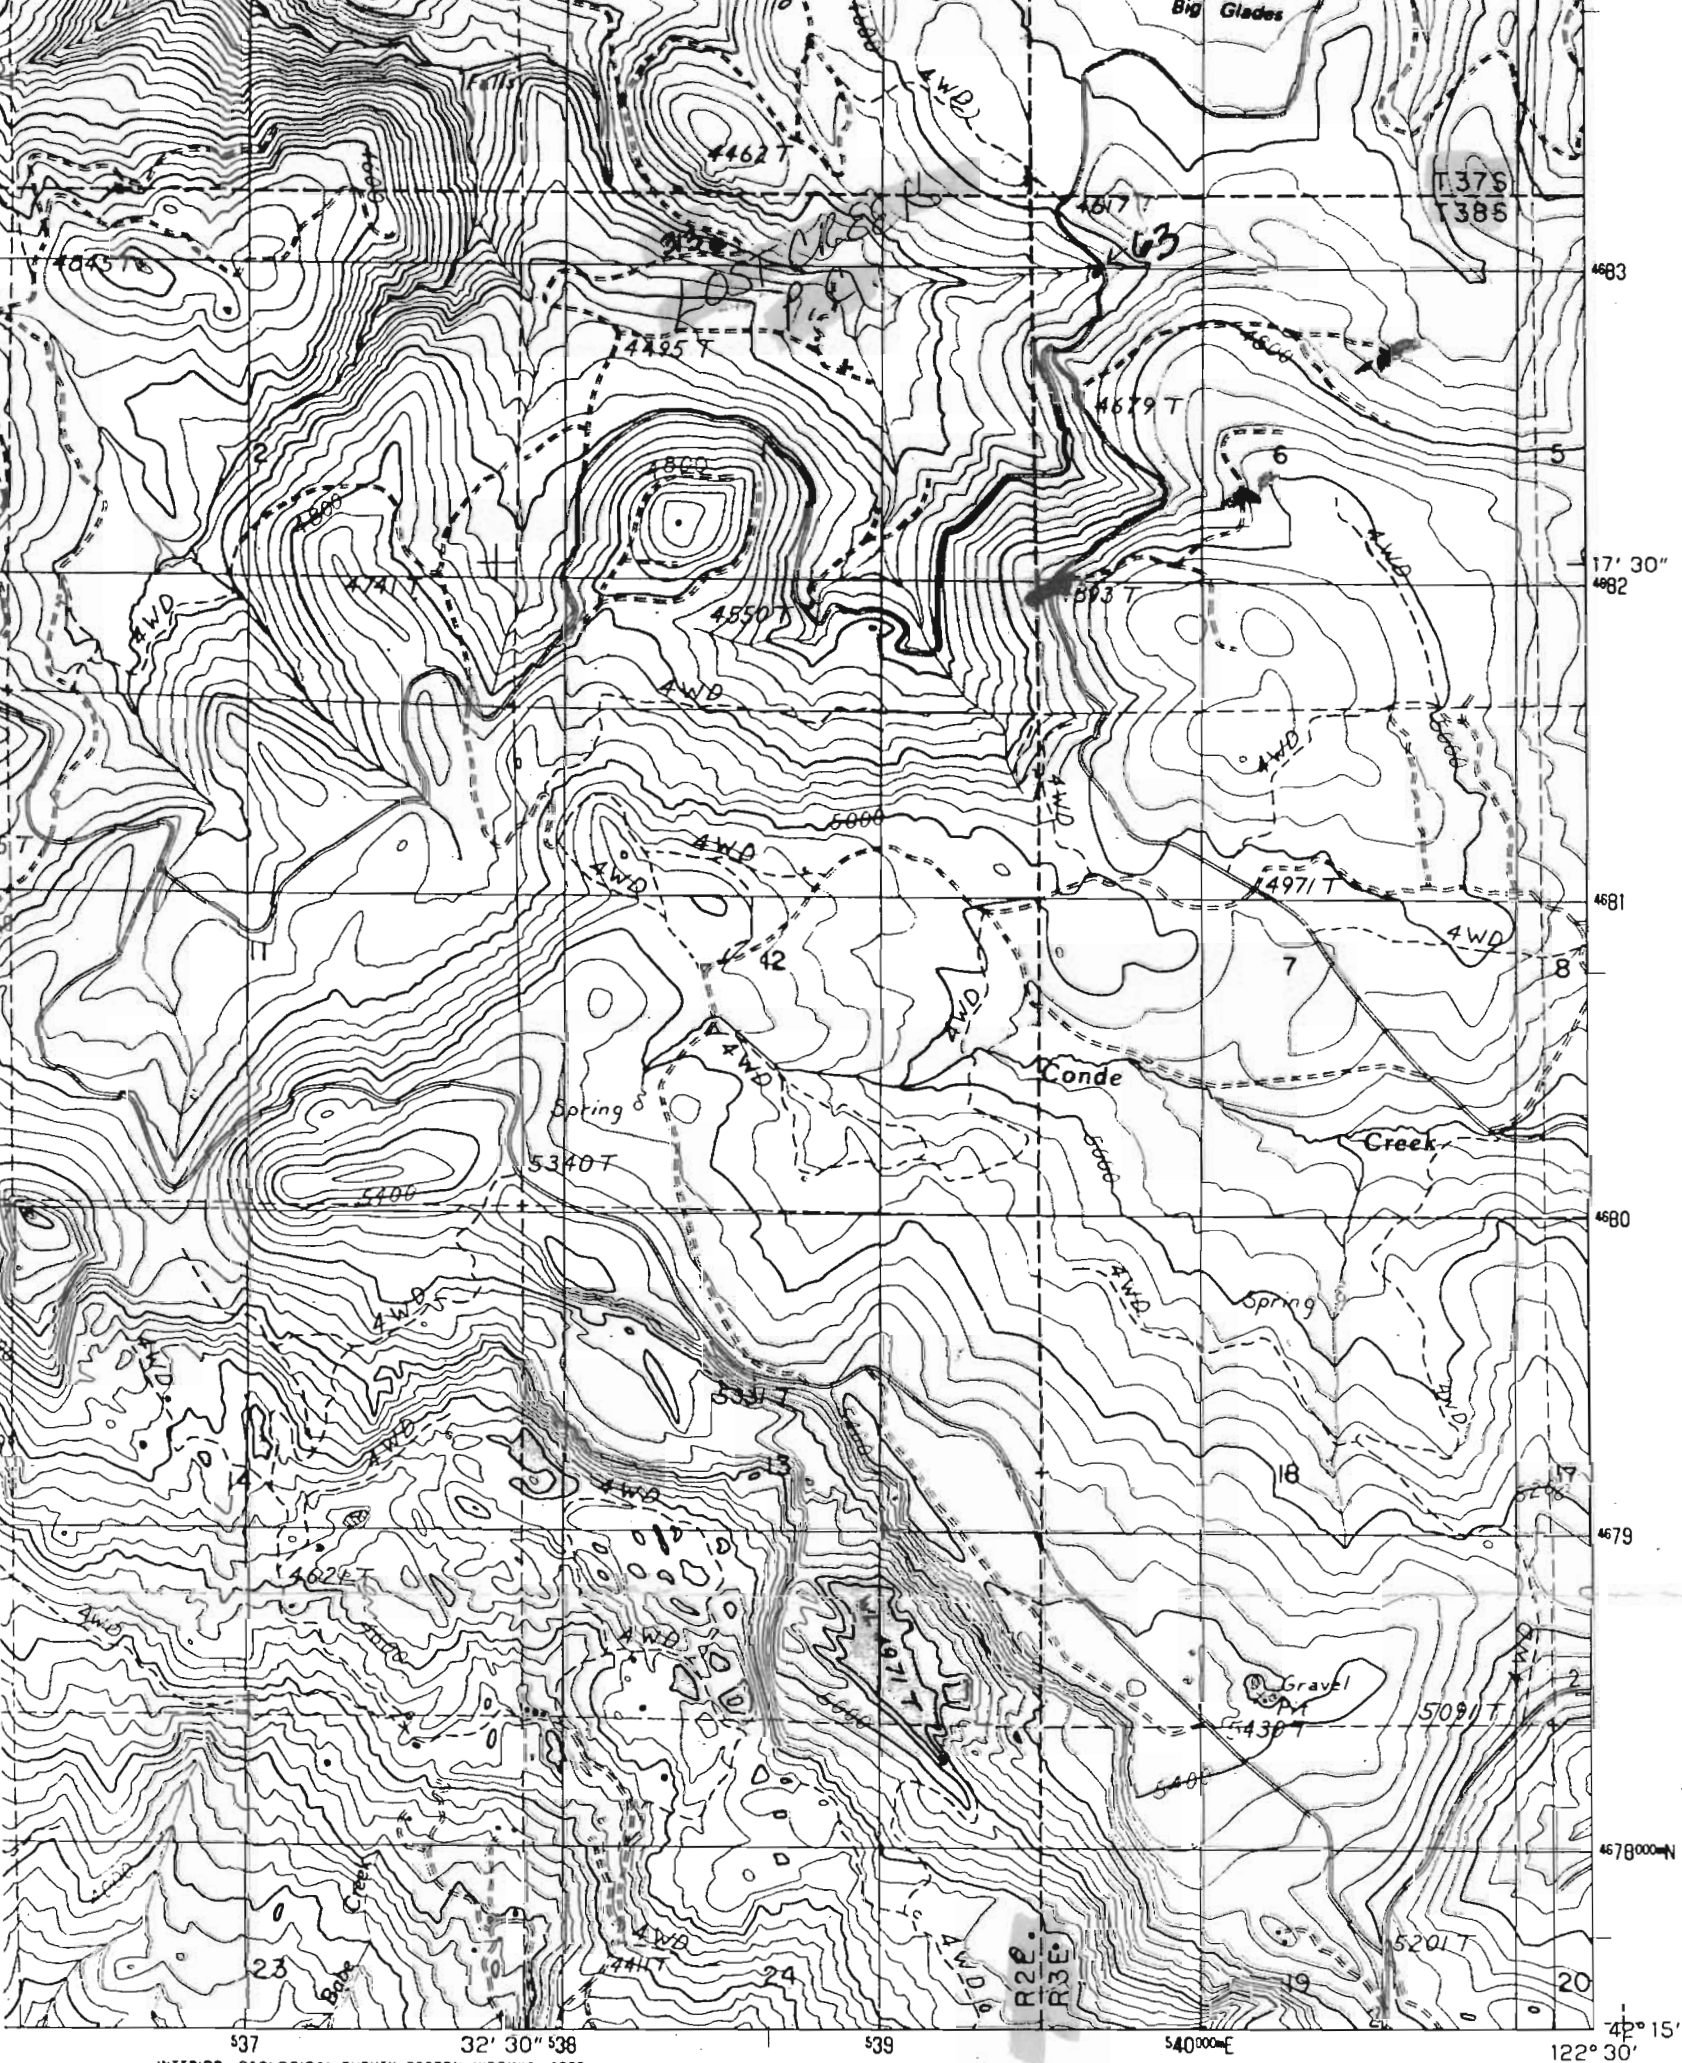

4 000

INTERIOR-GEOLOGICAL SURVEY, RESTON, VIRGINIA-1988

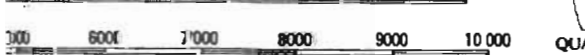

AL 40 FEET

THE NEAREST 0.1 FOOT
THE NEAREST FOOT
multiply by 3.2808
multiply by 0.3048

MAP ACCURACY STANDARDS
COLORADO 130223, OR RESTON, VIRGINIA 22092

1	2	3	1 Brownsboro
4		5	2 Lakecreek
			3 Willow Lake
			4 Rio Canyon
			5 Robinson Butte
6	7	8	6 Ashland
			7 Emigrant Lake
			8 Hyatt Reservoir

ADJOINING 7.5' QUADRANGLE NAMES



QUADRANGLE LOCATION

ROAD LEGEND

Improved Road
Unimproved Road
Trail

○ Interstate Route ○ U.S. Route ○ State Route

GRIZZLY PEAK, OREG.

PROVISIONAL EDITION 1988

42122-C5-TF-024

LAKECREEK SE

Application No. R-79238
Permit No.

71445

CERTIFICATE NO.

[Scale = 1:24000]

Mt. McLoughlin SW, Oreg.
Quadrangle

Scale = 1:24000

71445

CERTIFICATE NO.

UNITED STATES

DEPARTMENT OF INTERIOR

GEOLOGICAL SURVEY

MODIFIED FOR USDA FOREST SERVICE USE

R3E

122°30'
42°22'30"

542000m E.

27°30'

(MT MC LOUGHLIN)

4631000m N

Application No. L-79238
Permit No.

