


Siskiyou Pass,  
Oreg. & Calif. Quad

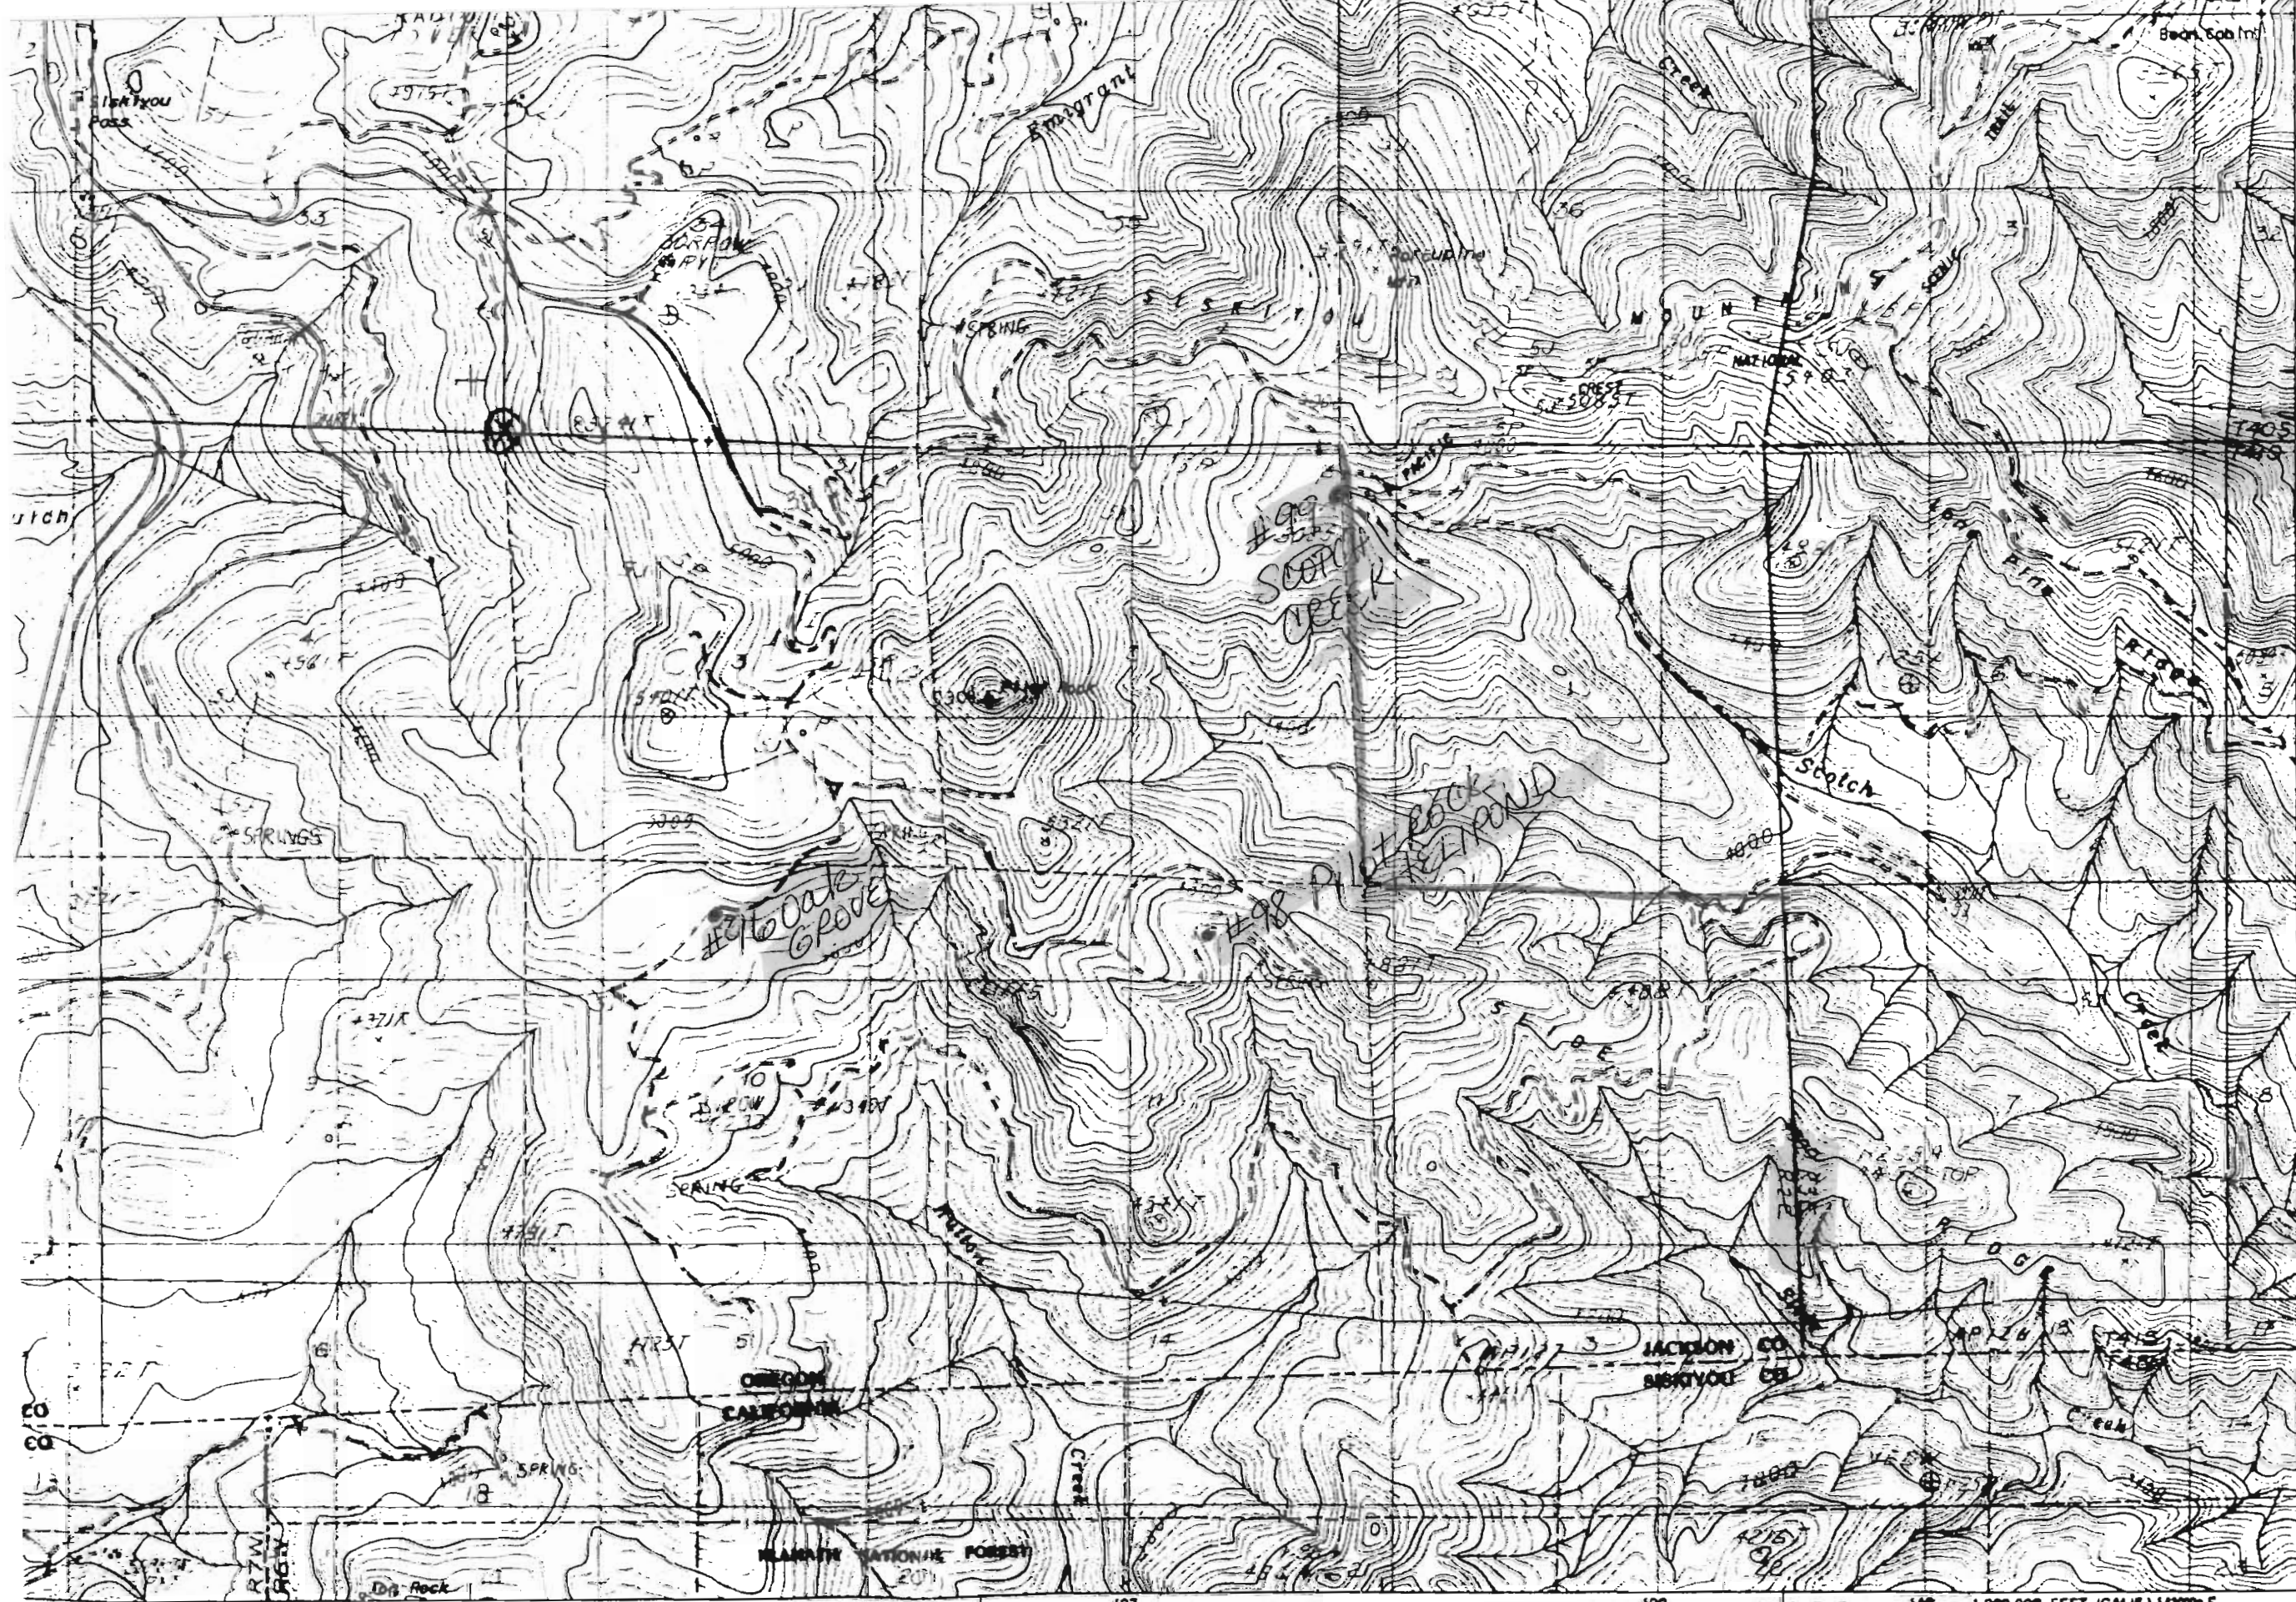

455  
2' 3  
454  
453  
980 000 FEET (CALIF.)  
452  
451  
450 000 N  
42° 00'

000 FEET (OREG.)

34

35

35

36

37

37

38

38

39

39

40

40

40

40

40

40

SCALE 1:24 000



CERTIFICATE NO. 71447

ROAD LEGEND

Application No. 12-79242

Permit No.

Improved Road

Unimproved Road

3ICAL SURVEY  
1878, NOS. 1800A  
1878  
1882  
FORMAL CONIC  
TOR... ZONE 18  
A.C.