



Application No. E-79244  
Permit No.

71448

Scale = 1:2400

900 000 FEET  
(CALIF.)

50000 N

OREGON  
CALIFORNIA

JACKSON CO  
SISKIYOU CO

BLANKET NATIONAL FOREST




Hyatt Reservoir, SW  
Quad

Application No. R 79244  
Permit No.

CERTIFICATE NO.

71448

1 010 000  
FEET (CALIF)

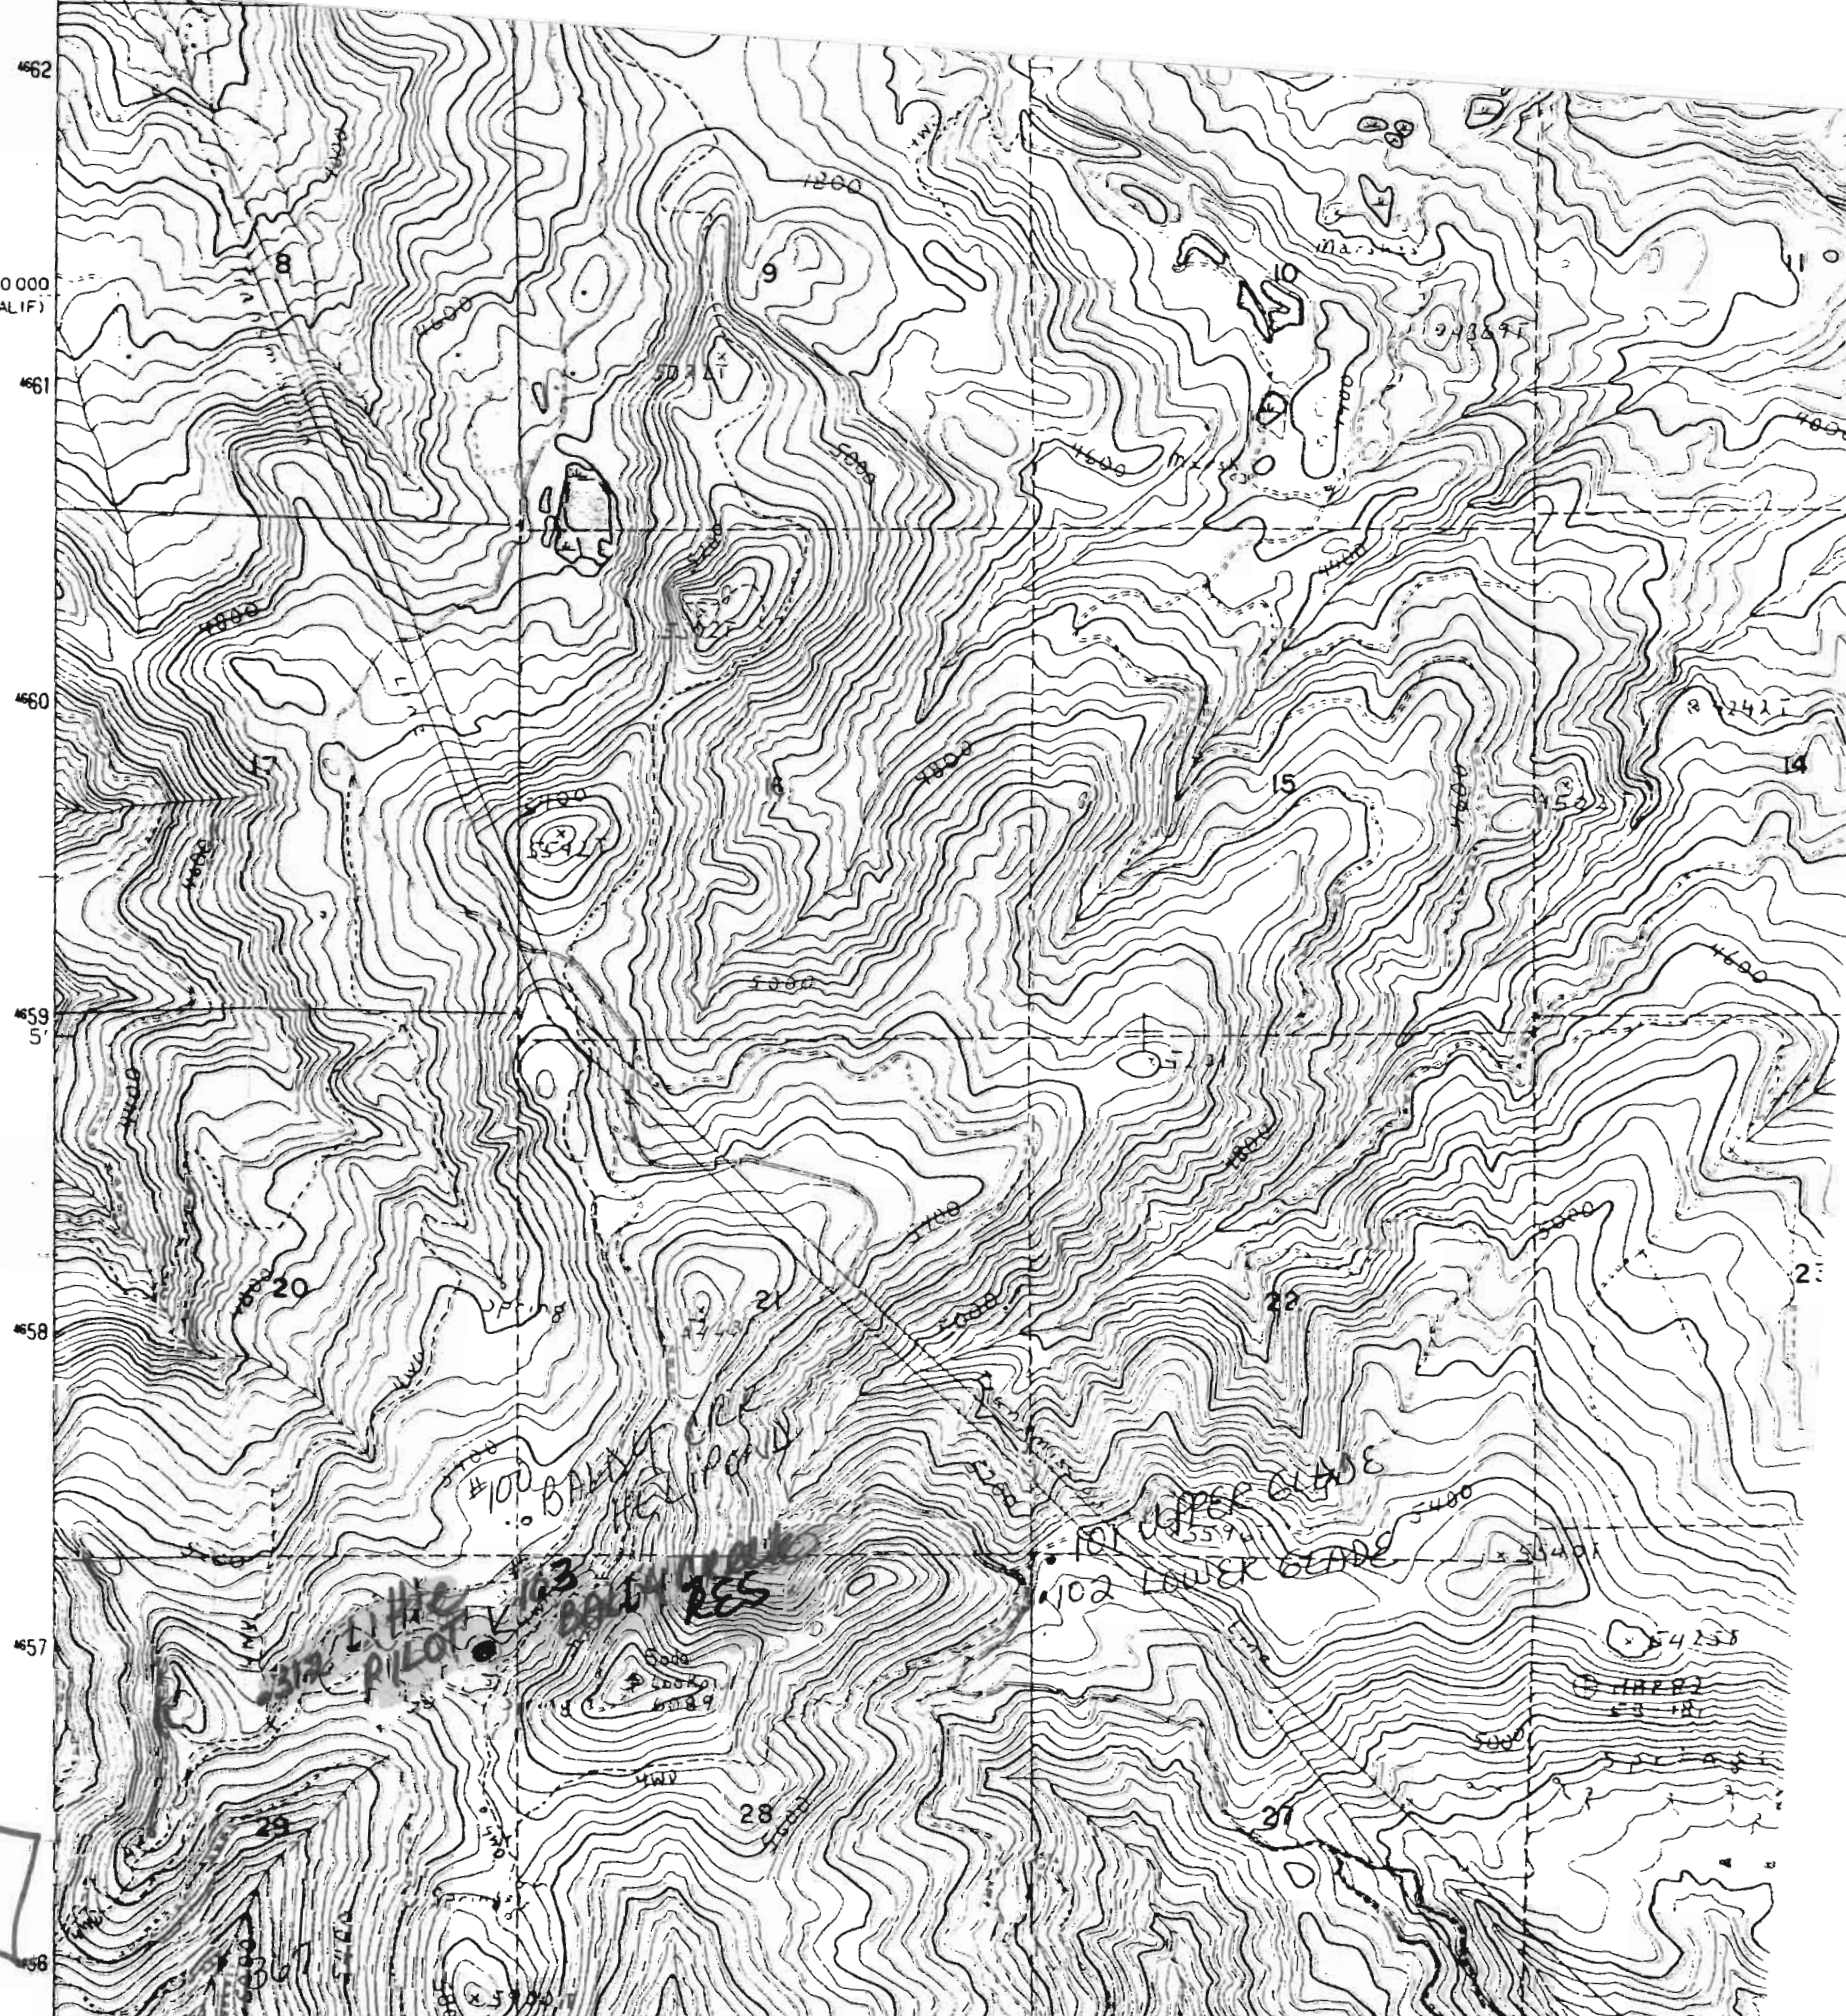

R3E

T40S

Scale = 1:24000