


Talent, Oreg. Quad

Scale = 1:24000

71451

Application No. R-79250
Permit No.

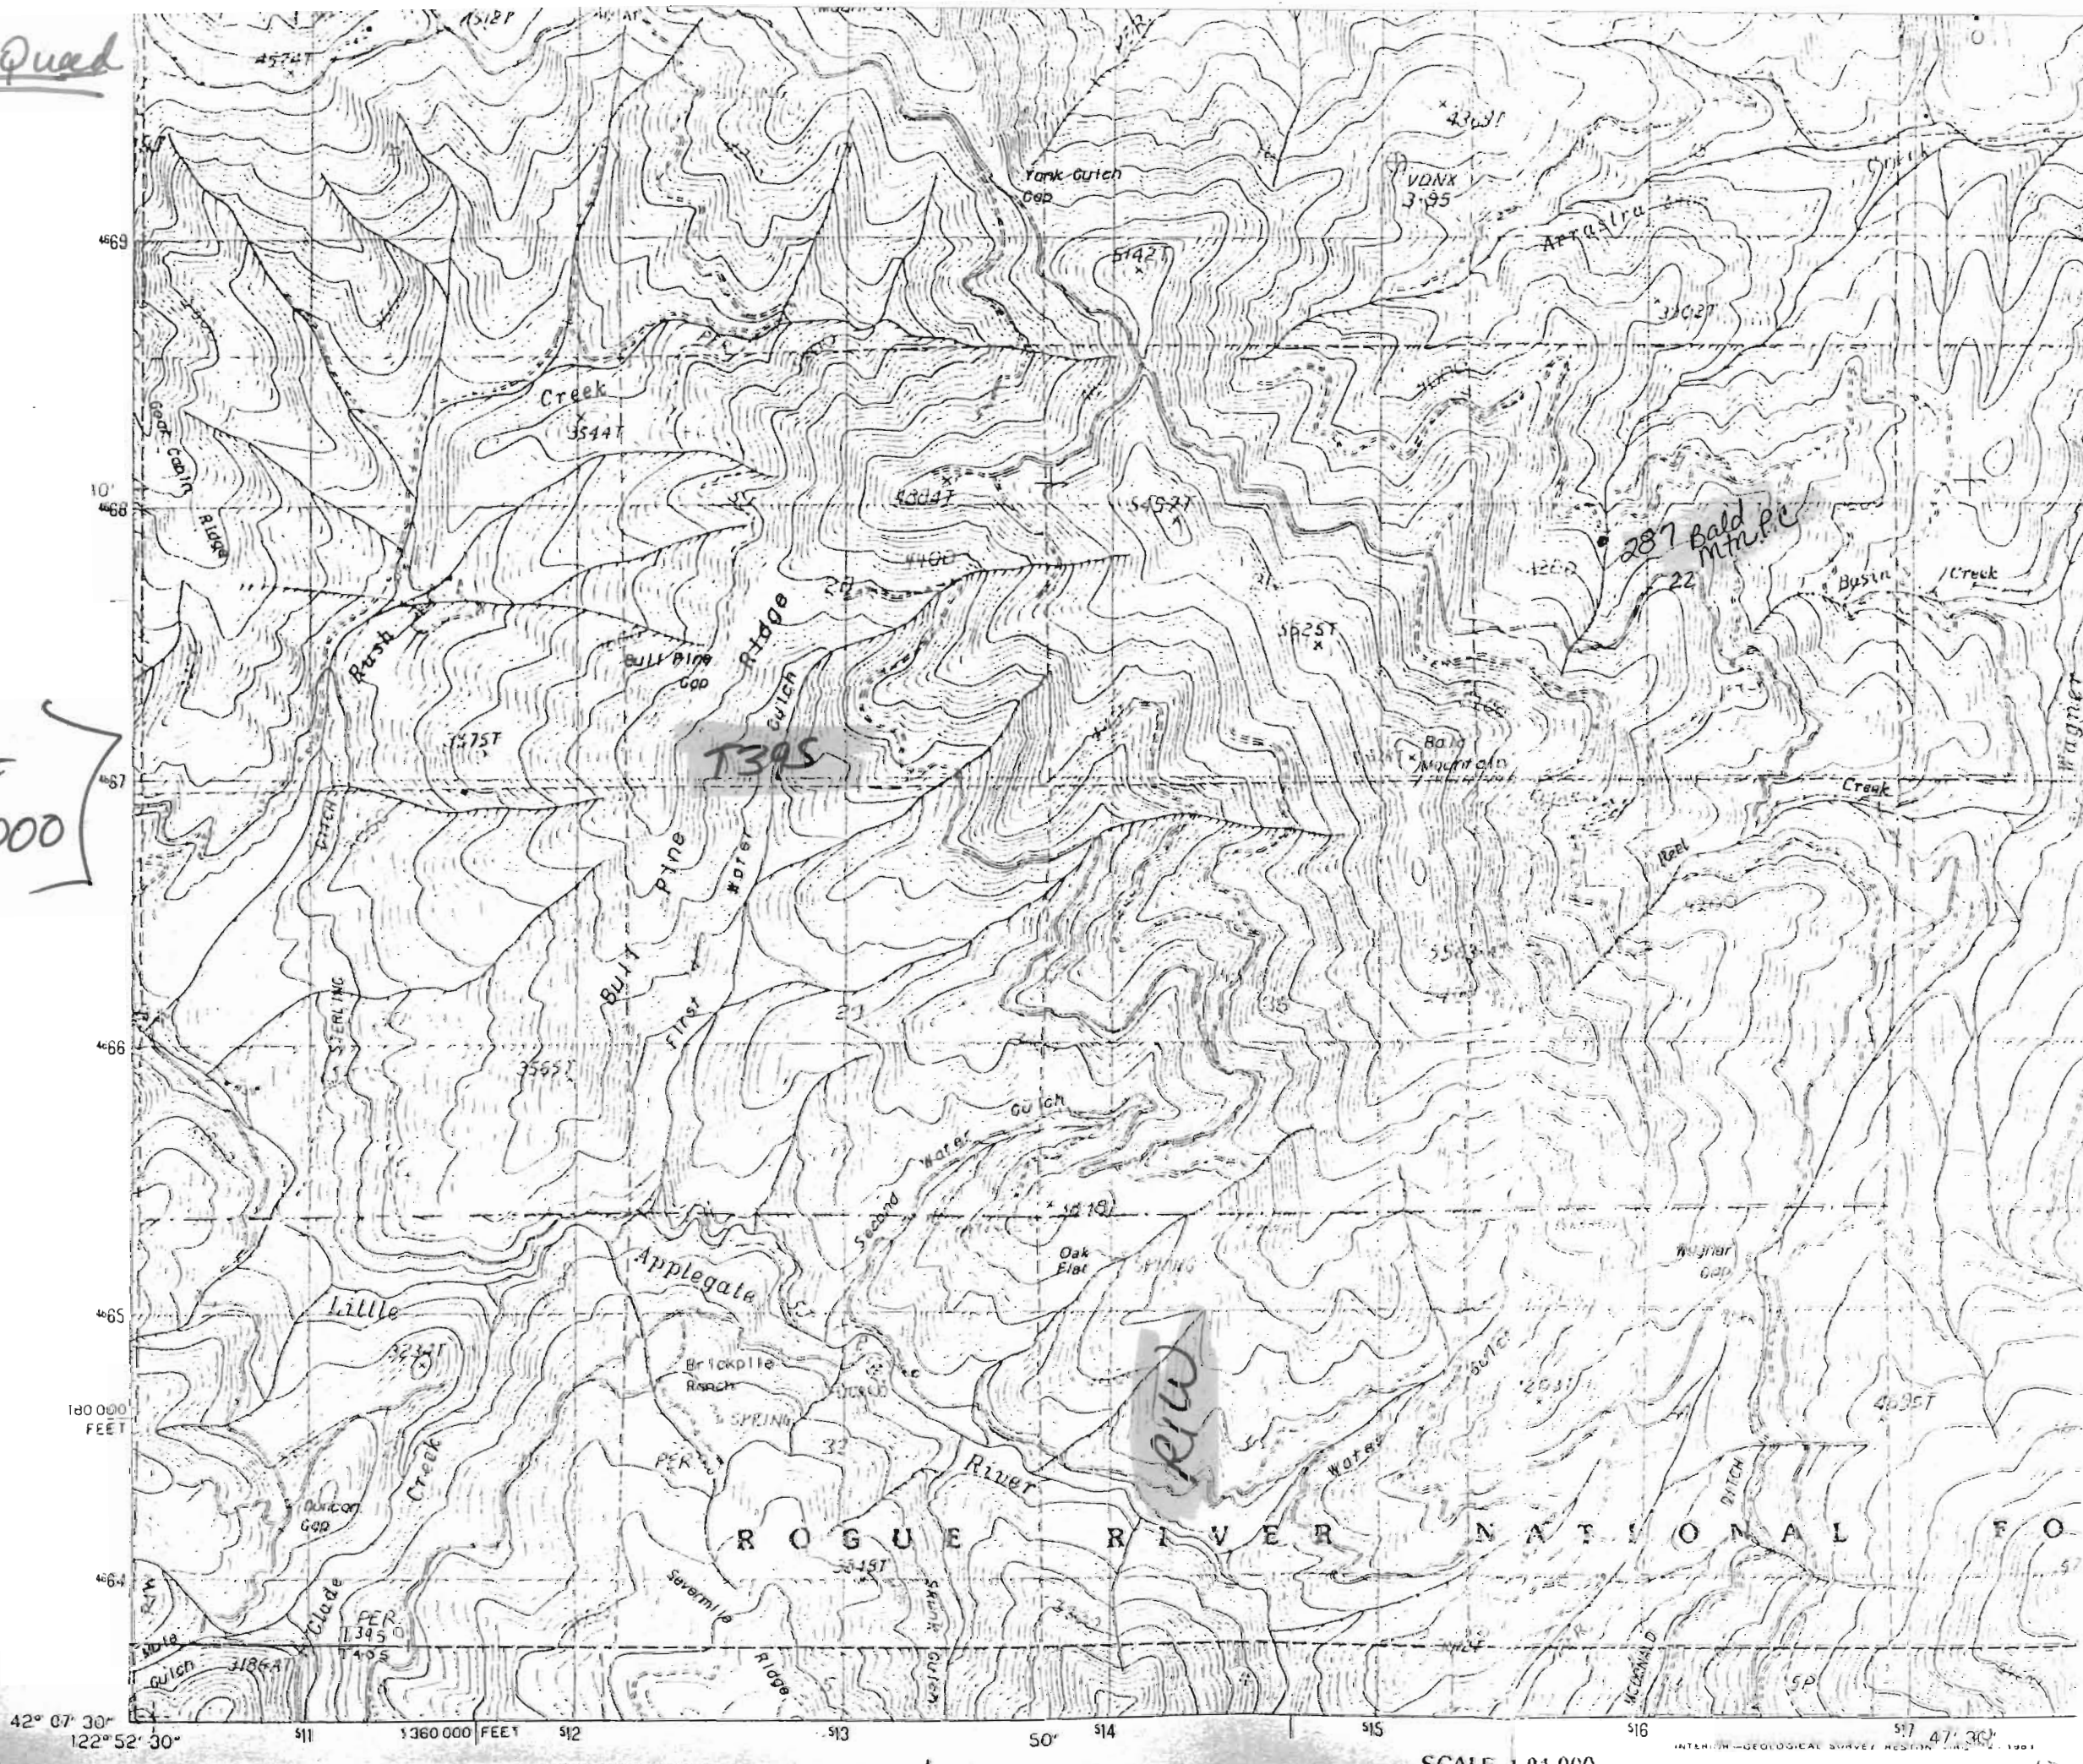

42° 07' 30" 122° 52' 30"

511 1360000 FEET 512

513 50' 514

515 516

517 47' 30" U.S. GEOLOGICAL SURVEY RESTON, VA 20192

SCALE 1:24000