


Scale 1:24,000

SQUAW LAKES QUADRANGLE  
OREGON—CALIFORNIA  
7.5 MINUTE SERIES (TOPOGRAPHIC)

← T403 →

UNITED STATES  
DEPARTMENT OF THE INTERIOR  
GEOLOGICAL SURVEY

DUTCHMAN PEAK QUAD.

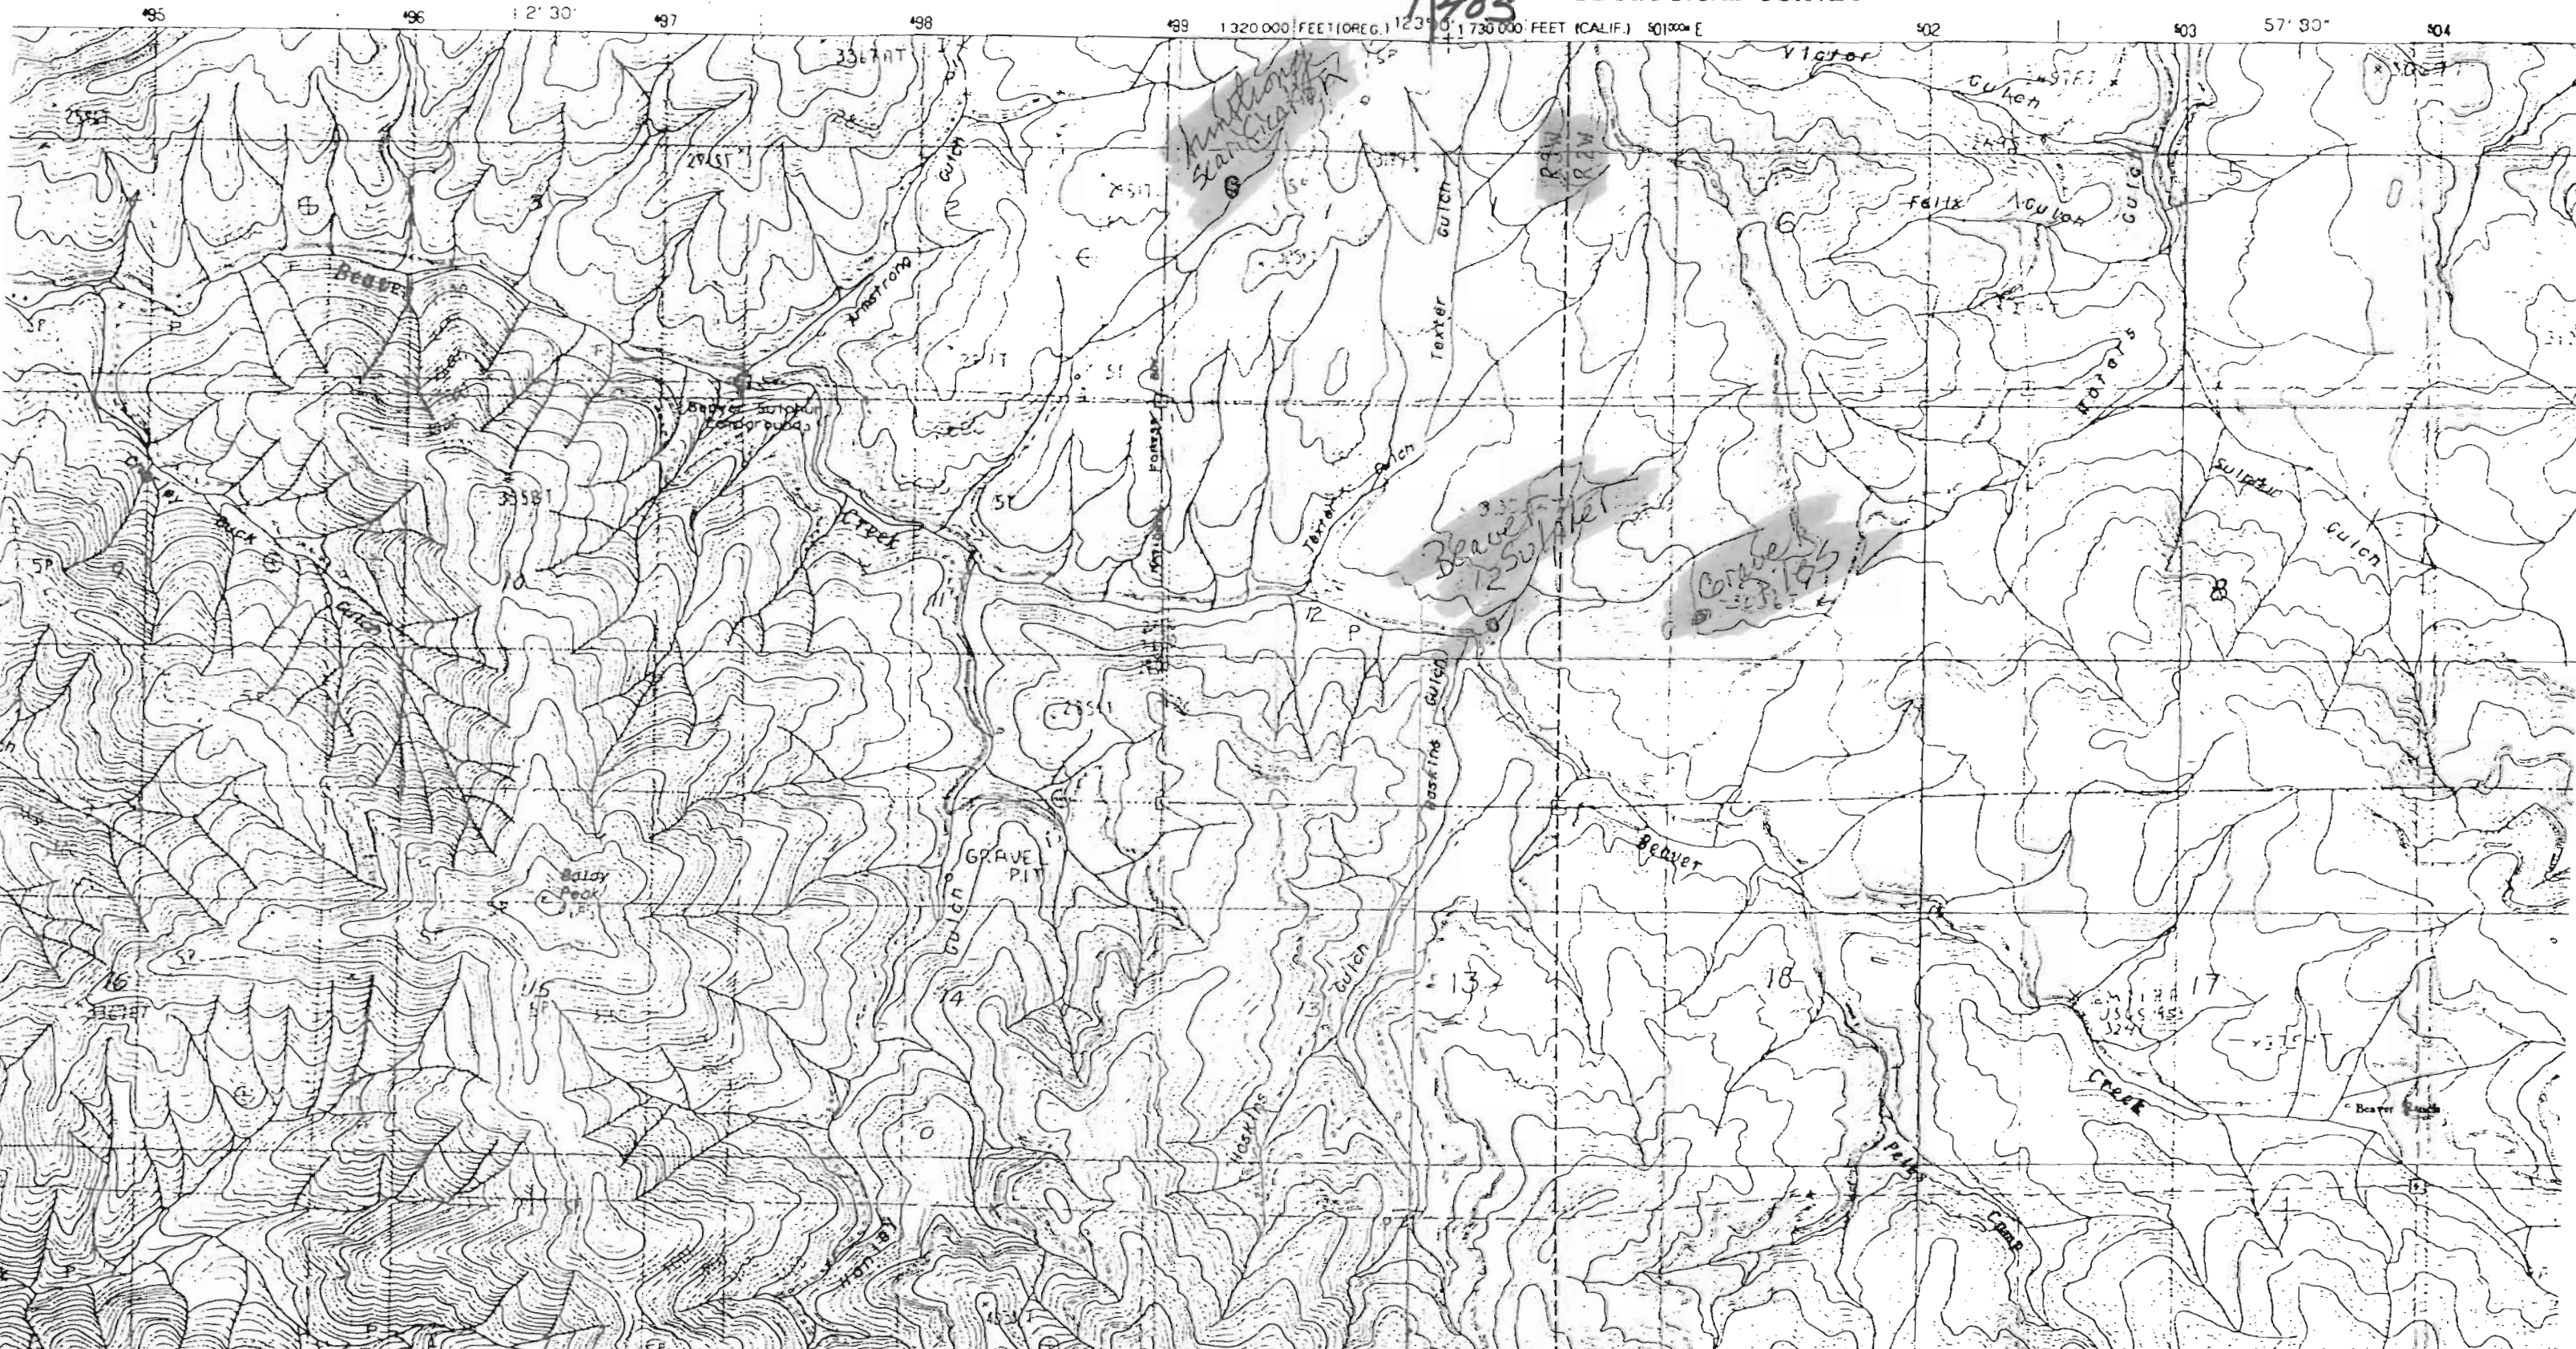


Application No. 12-79252

Permit No.

20

R O G U

71452

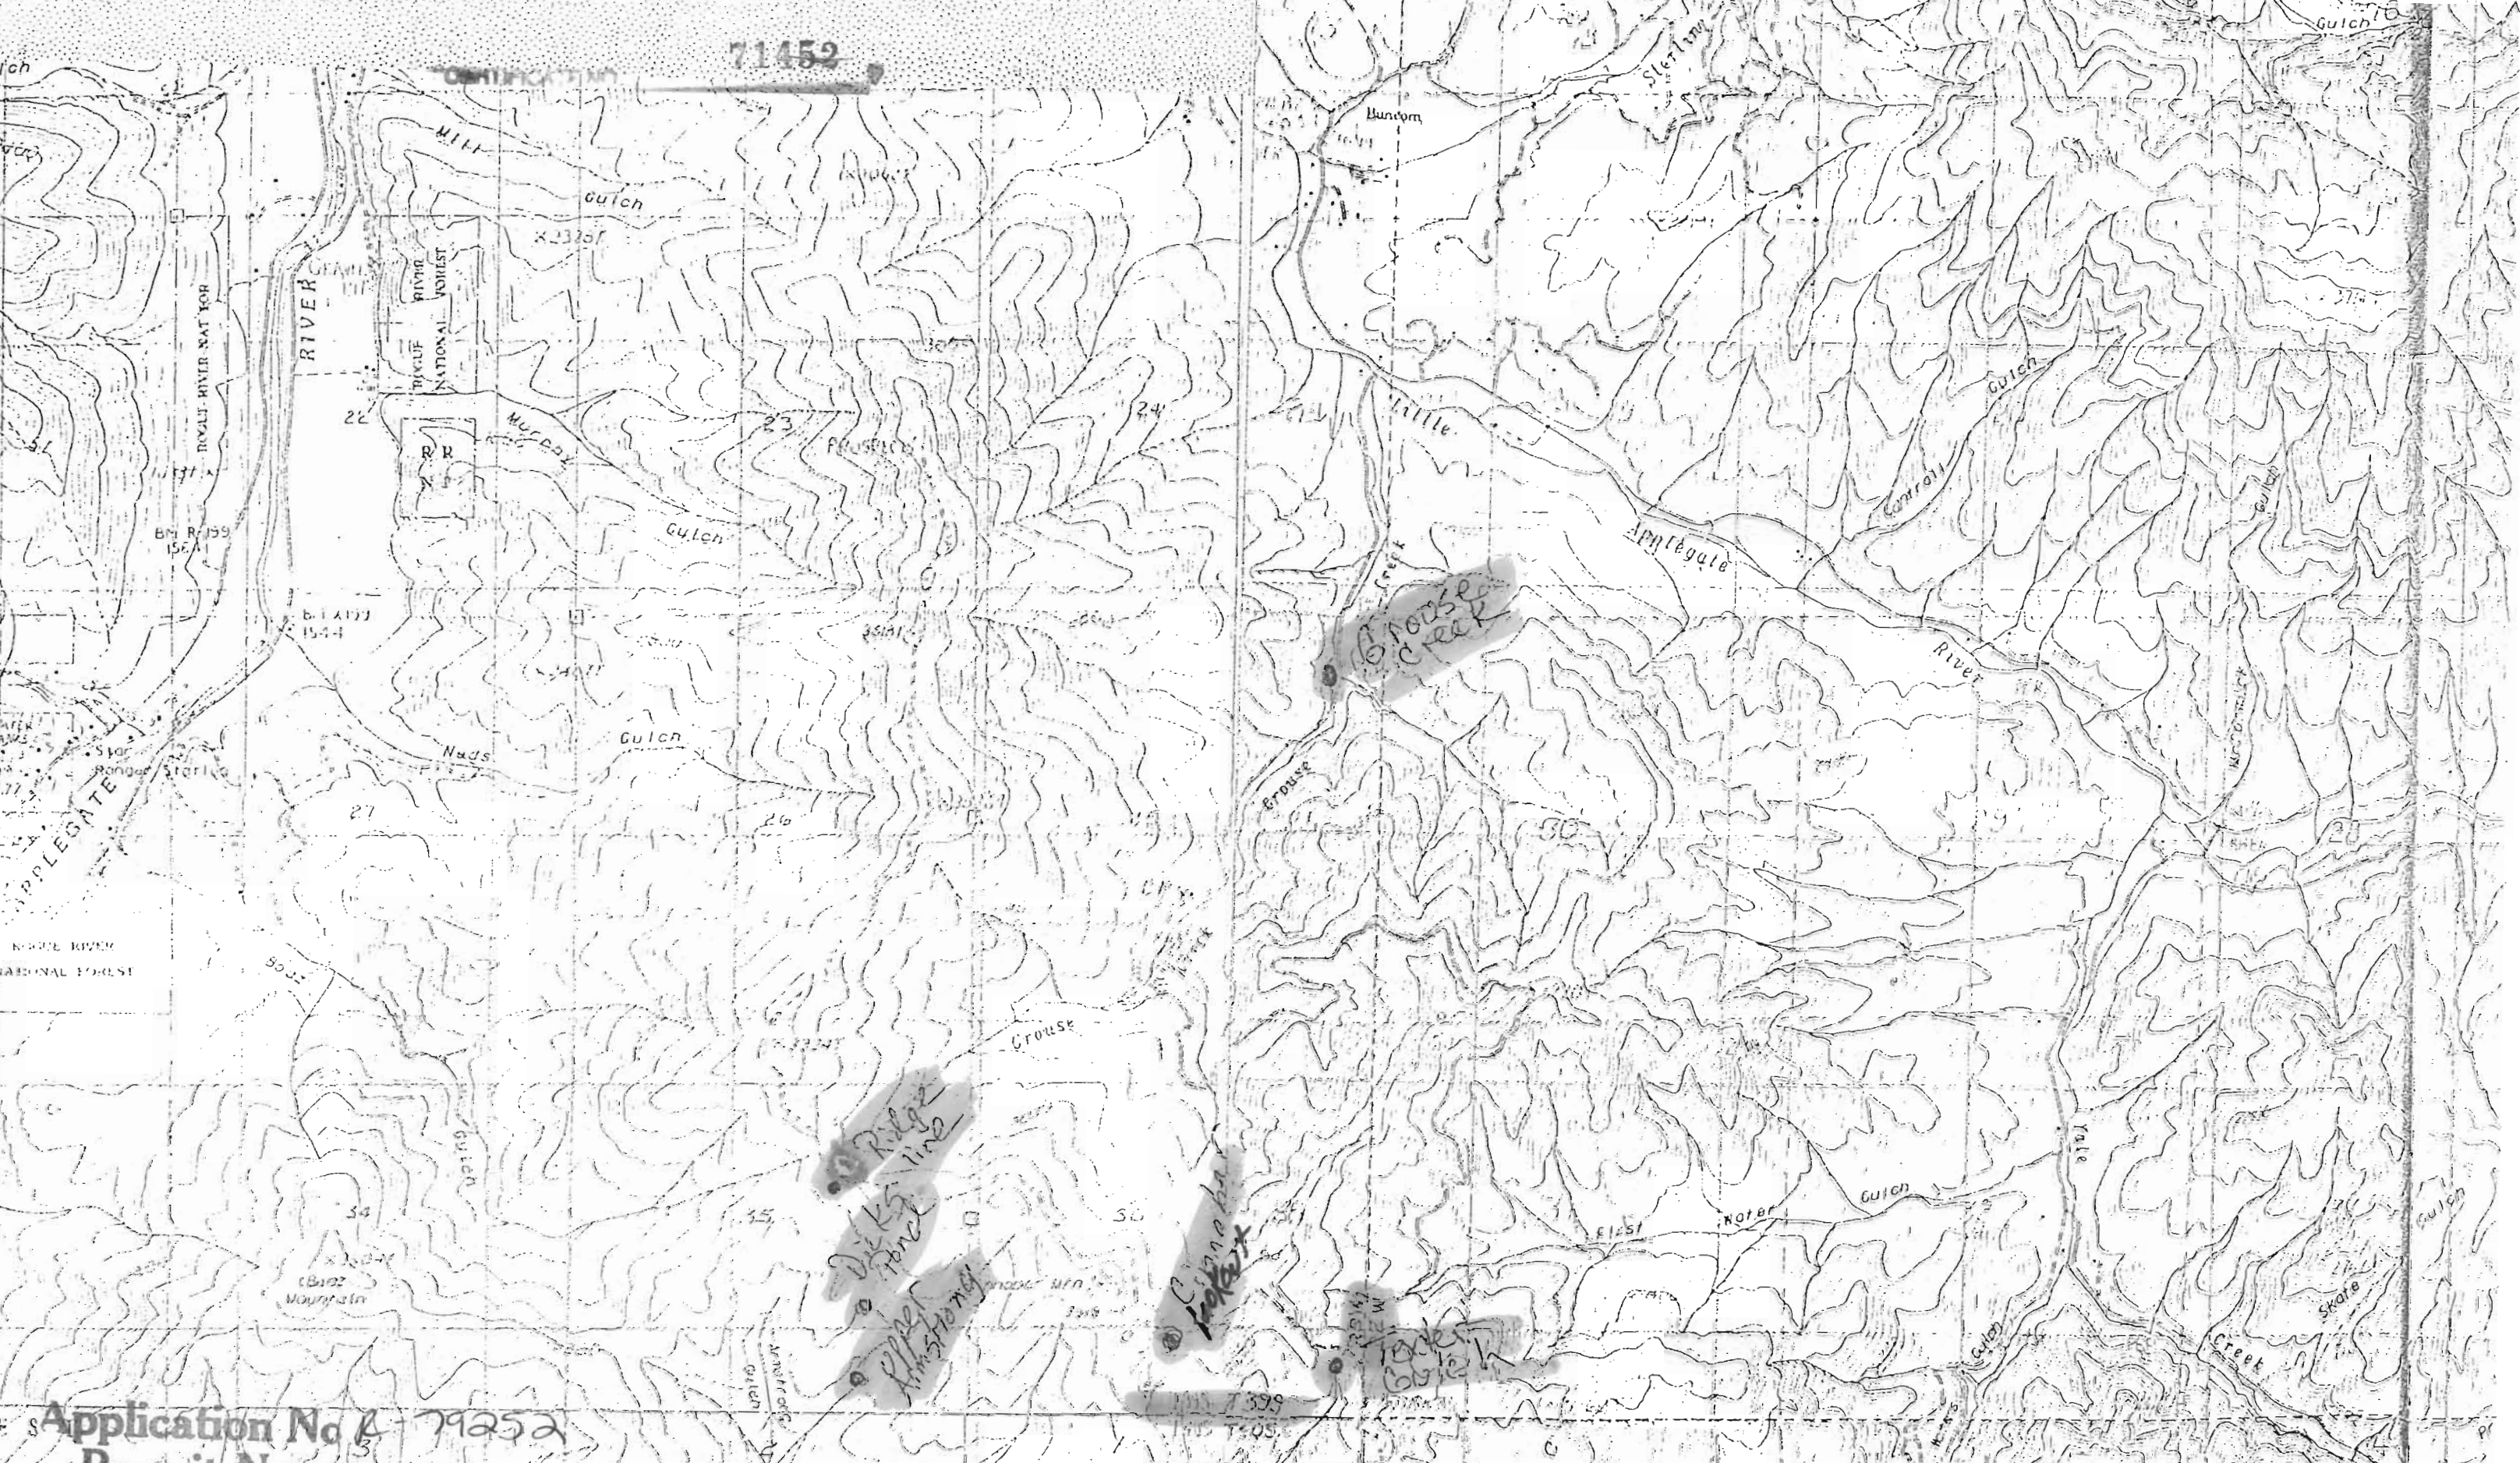

Application No. 79252  
Permit No. 3

RUCH QUADRANGLE

ROAD LEGEND

Improved Road

Scale 1:2400

PRODUCED BY THE UNITED STATES GEOLOGICAL SURVEY  
CONTROL BY USGS NOS. 500A  
COMPILED FROM AERIAL PHOTOGRAPHS TAKEN 1976  
FIELD CHECKED 1979 MAP SCALE 1:2400

STERLING CREEK QUADRANGLE

