


Weyerhaeuser Company

Water Storage Site Map

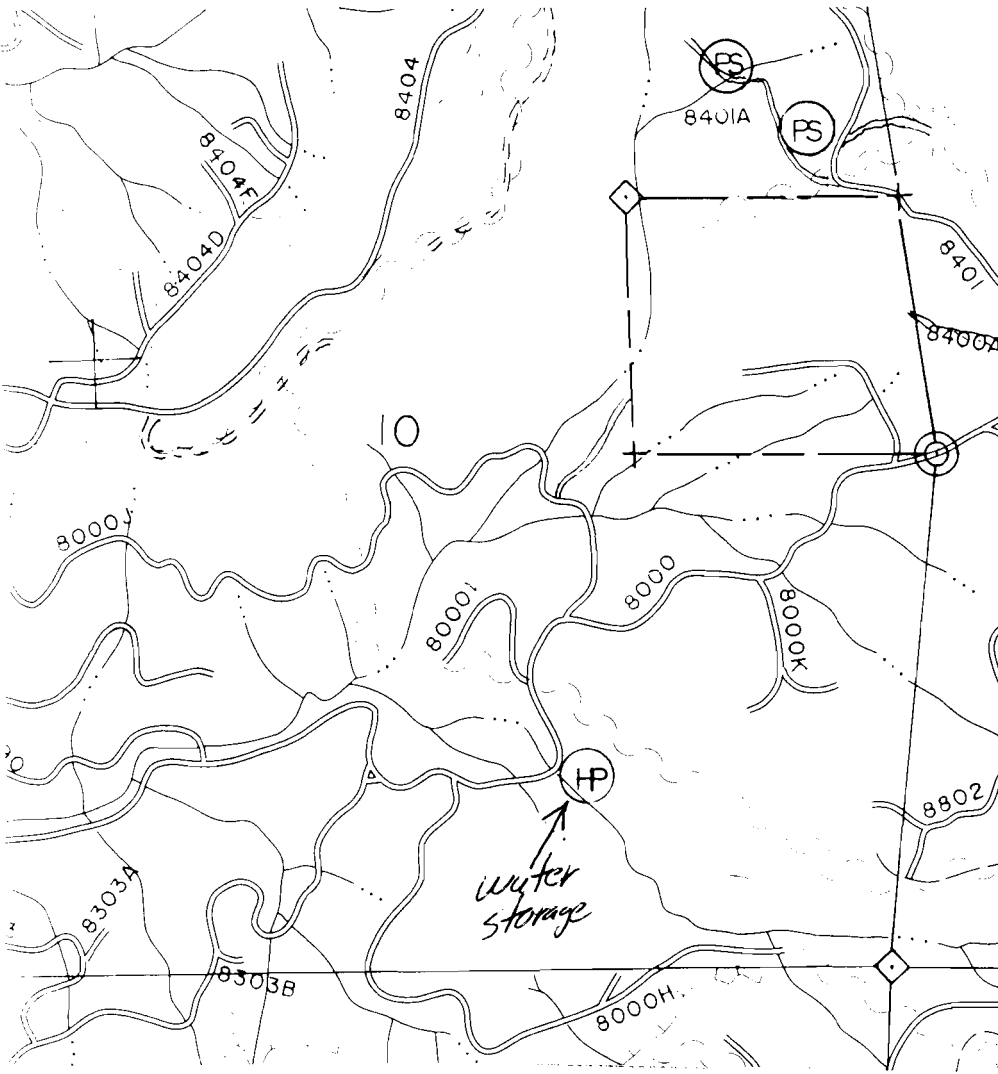

#5
RECEIVED

JAN - 3 1995
WATER RESOURCES DIV.
SALEM, OREGON

N↑

Map Scale: 1" = 1000 feet

Section 10

Township 26S

Range 8W

Forty SW 1/4, SE 1/4,

River Basin

COOS River

Application No. R-79295
Permit No.

Gallons of Water Stored: 238 425

Purpose of Impounded Water:

1. Emergency Fire Suppression

2. _____

"Certified" 12 172