

71474

Weyerhaeuser Company


REC...

JAN - 3 1995

WATER RES...
SALEM, OREGON

Water Storage Site Map

Water Storage

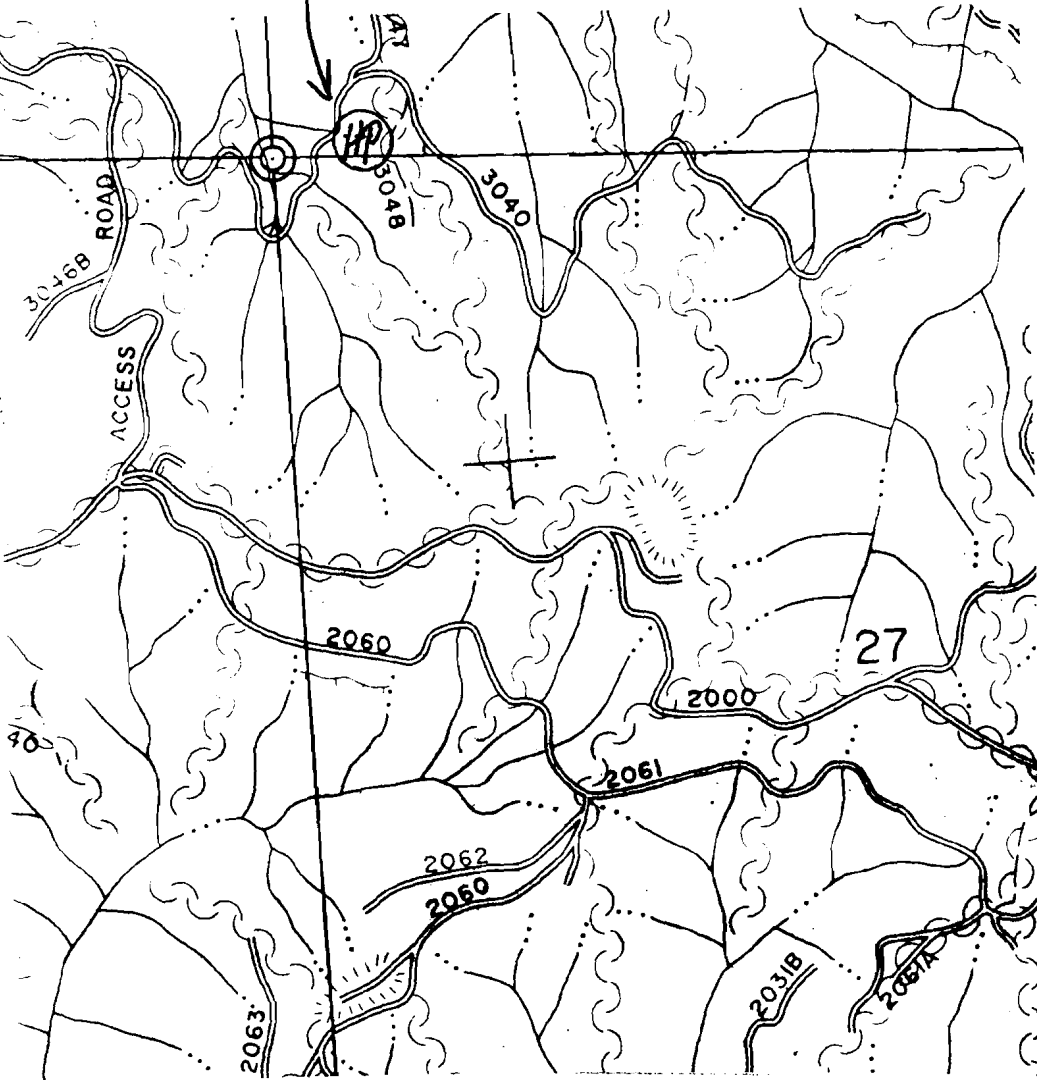

NT ↑

Map Scale: 1" = 1000 feet

Section 27

Township 24 South

Range 10 West

Forty SW 1/4, SW 1/4

River Basin Coos River

Gallons of Water Stored: 130,000

Purpose of Impounded Water:

1. Emergency Fire Suppression
2. _____

Application No. 6-79297
 Permit No.