

71175


Weyerhaeuser Company

RECEIVED

JAN - 3 1995

WATER RESOURCES
SALEM, OREGON

Water Storage Site Map

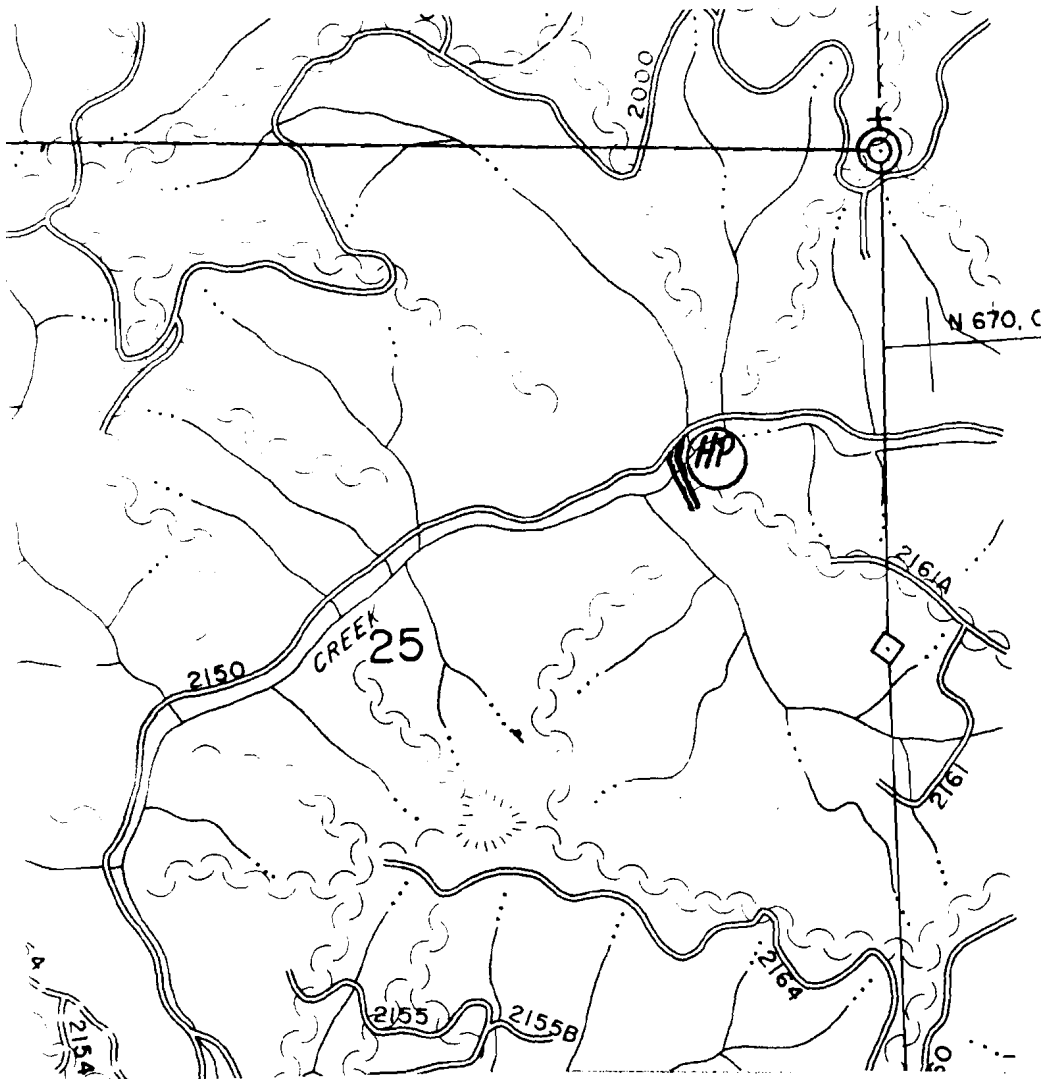

N↑

Map Scale: 1" = 1000 feet

Section 25

Township 24 South

Range 10 West

Forty SE 1/4, NE 1/4

River Basin Coos River

Gallons of Water Stored: 51,800

Purpose of Impounded Water:

1. Emergency Fire Suppression

2. _____

Application No. 12-79298
Permit No.

71175

Weyerhaeuser Company

Water Storage Site Map

RECEIVED

JAN - 3 1995

WATER RESOURCES
SALEM, OREGON

N↑

Map Scale: 1" = 1000 feet


Section 6

Township 26S

Range 9W

Forty NE 1/4, SE 1/4

River Basin Coos River

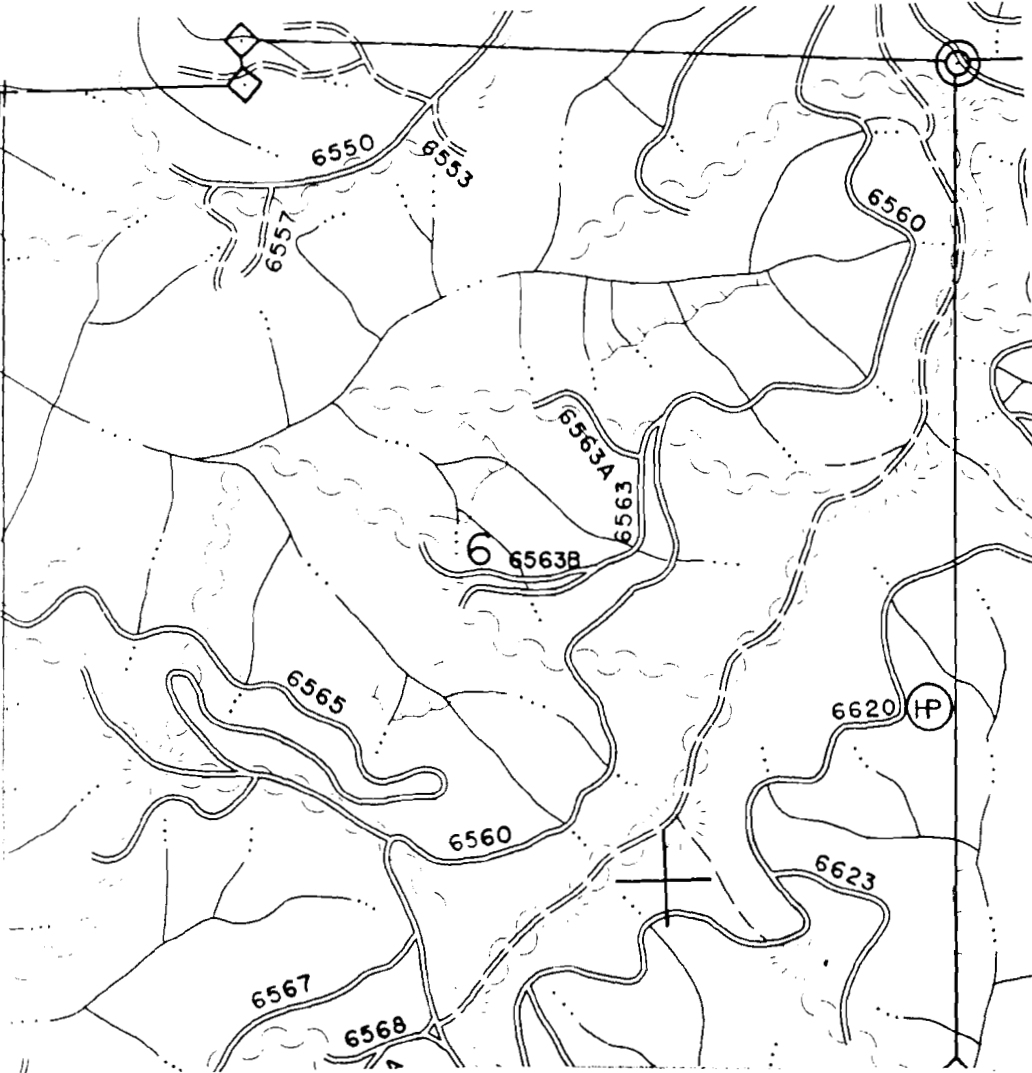

Gallons of Water Stored: 6800

Purpose of Impounded Water:

1. Emergency Fire Suppression,

2. _____

Application No. R-79298
Permit No.

71175


Weyerhaeuser Company

Water Storage Site Map

RECEIVED

JAN - 3 1995

WATER RESOURCES
SALEM, OREGON

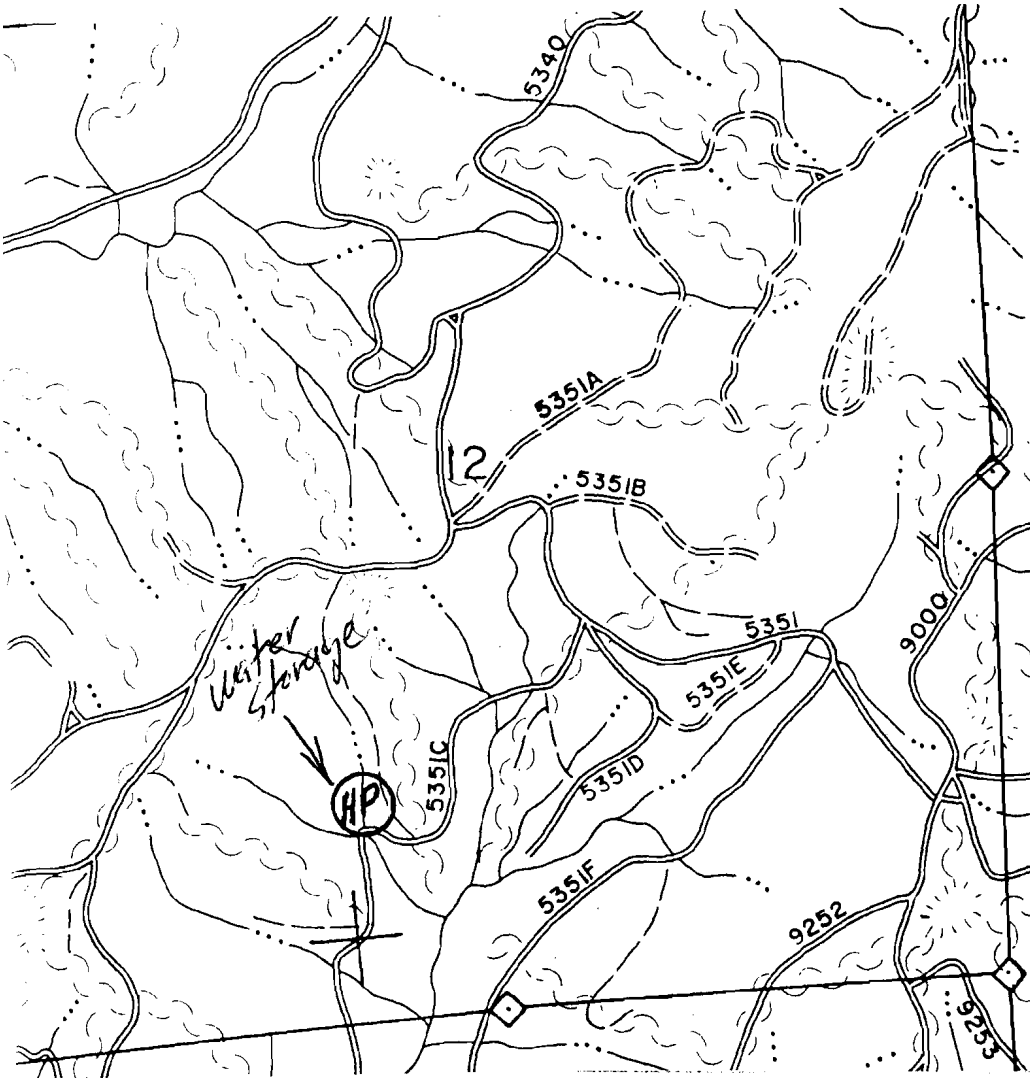

N↑

Map Scale: 1" = 1000 feet

Section 12

Township 27S

Range 8W

Forty SE 1/4, SW 1/4

River Basin Coos River

Gallons of Water Stored: 26900

Purpose of Impounded Water:


1. Emergency Fire Suppression .

2. _____

Application No. 12-79298
Permit No.

Weyerhaeuser Company

Water Storage Site Map

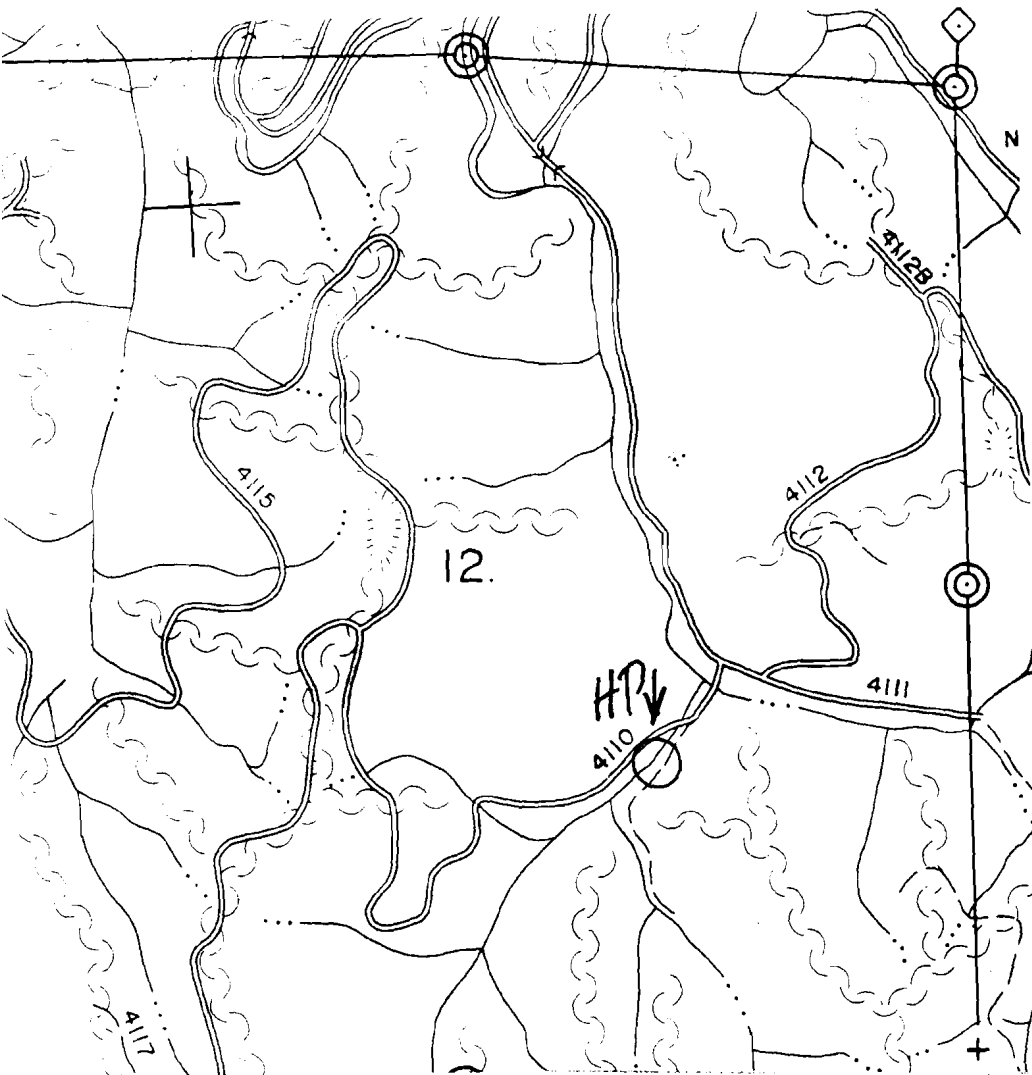

RECEIVED

JAN - 3 1995

WATER RESOURCES
SALEM, OREGON

N↑

Map Scale: 1" = 1000 feet

Section 12

Township 25S

Range 10W

Forty NW 1/4, SE 1/4

River Basin Coos River

Gallons of Water Stored: 91600

Purpose of Impounded Water:

1. Emergency Fire Suppression

2. _____


Application No. R-79298
Permit No.

92475

Weyerhaeuser Company

Water Storage Site Map

RECEIVED
JAN - 3 1995
WATER RESOURCES
SALEM, OREGON - O.R.

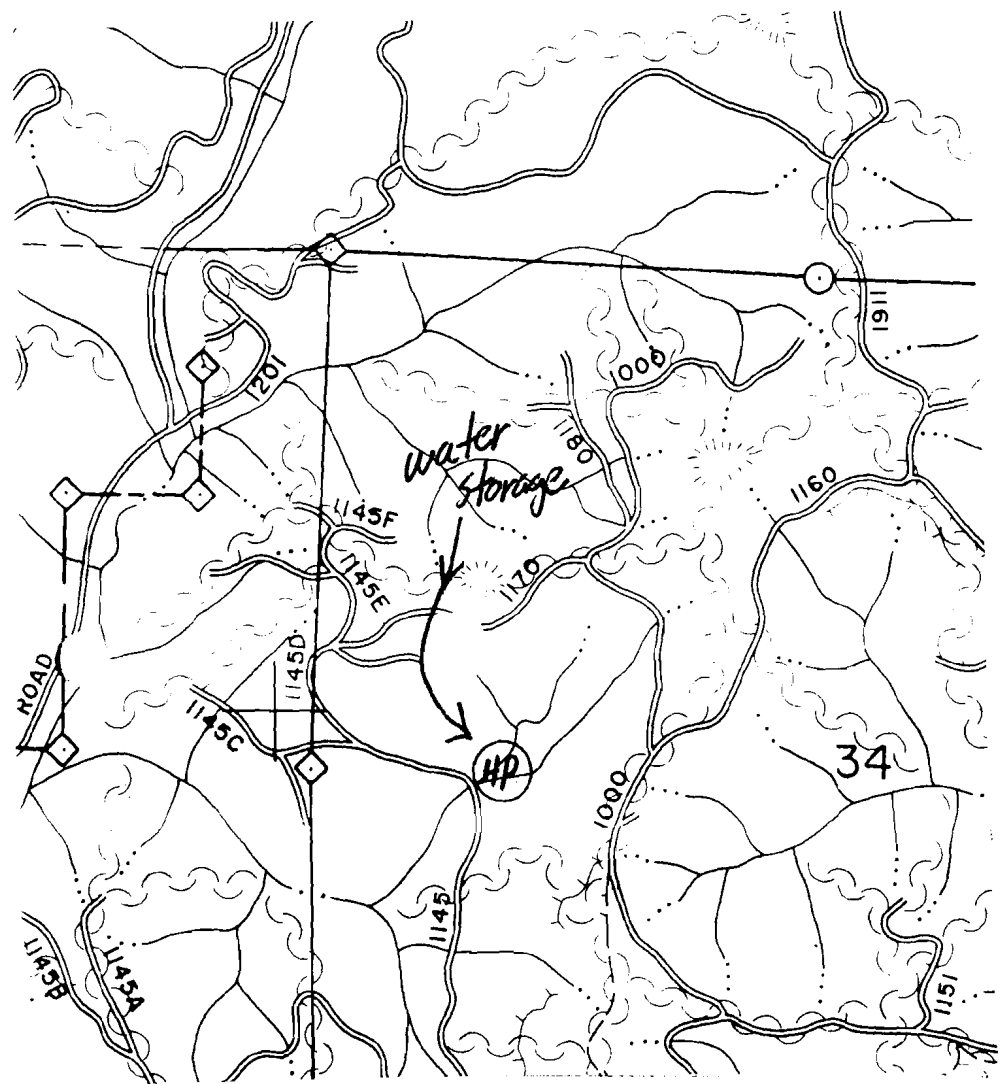

N↑

Map Scale: 1" = 1000 feet

Section 34

Township 23 South

Range 10 West

Forty sw 1/4, nw 1/4

River Basin Cow River

Gallons of Water Stored: 142200

Purpose of Impounded Water:

1. Emergency Fire Suppression,
2. _____

Application No. K-79298
Permit No.


71175
Weyerhaeuser Company

RECEIVED

JAN - 3 1995

WATER RESOURCES DIV.
SALEM, OREGON

Water Storage Site Map

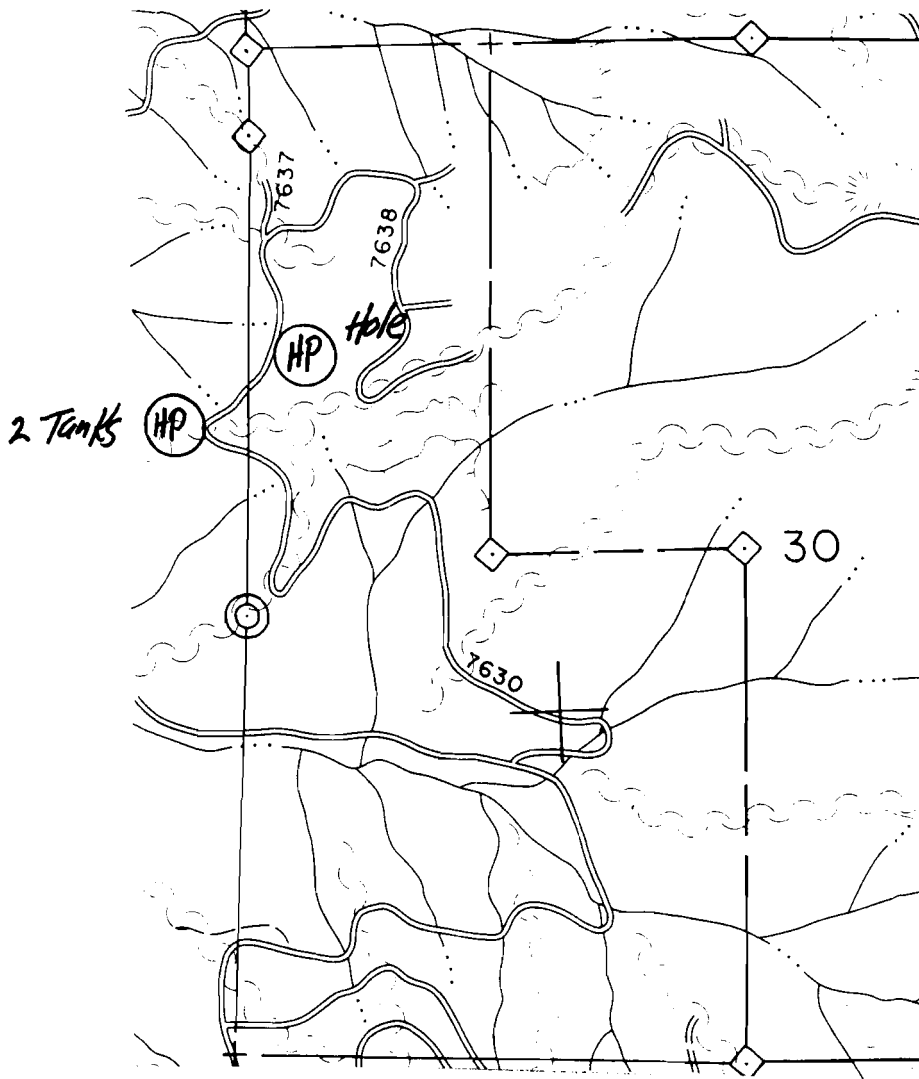

N↑

Map Scale: 1" = 1000 feet

Section 30 + 25

Township 25S + 25S

Range 8W + 9W

Forty SW 1/4, NW 1/4 + SE 1/4, NE 1/4

River Basin Coos River

Gallons of Water Stored: 35000 Total (10000 in 2 tanks, 25000 in an excavated hole)

Purpose of Impounded Water:

1. Emergency Fire Suppression .

2. _____

Application No. K-79298
Permit No. _____

72175


Weyerhaeuser Company

RECEIVED

JAN - 3 1995

WATER RESOURCES
SALEM, OREGON

Water Storage Site Map

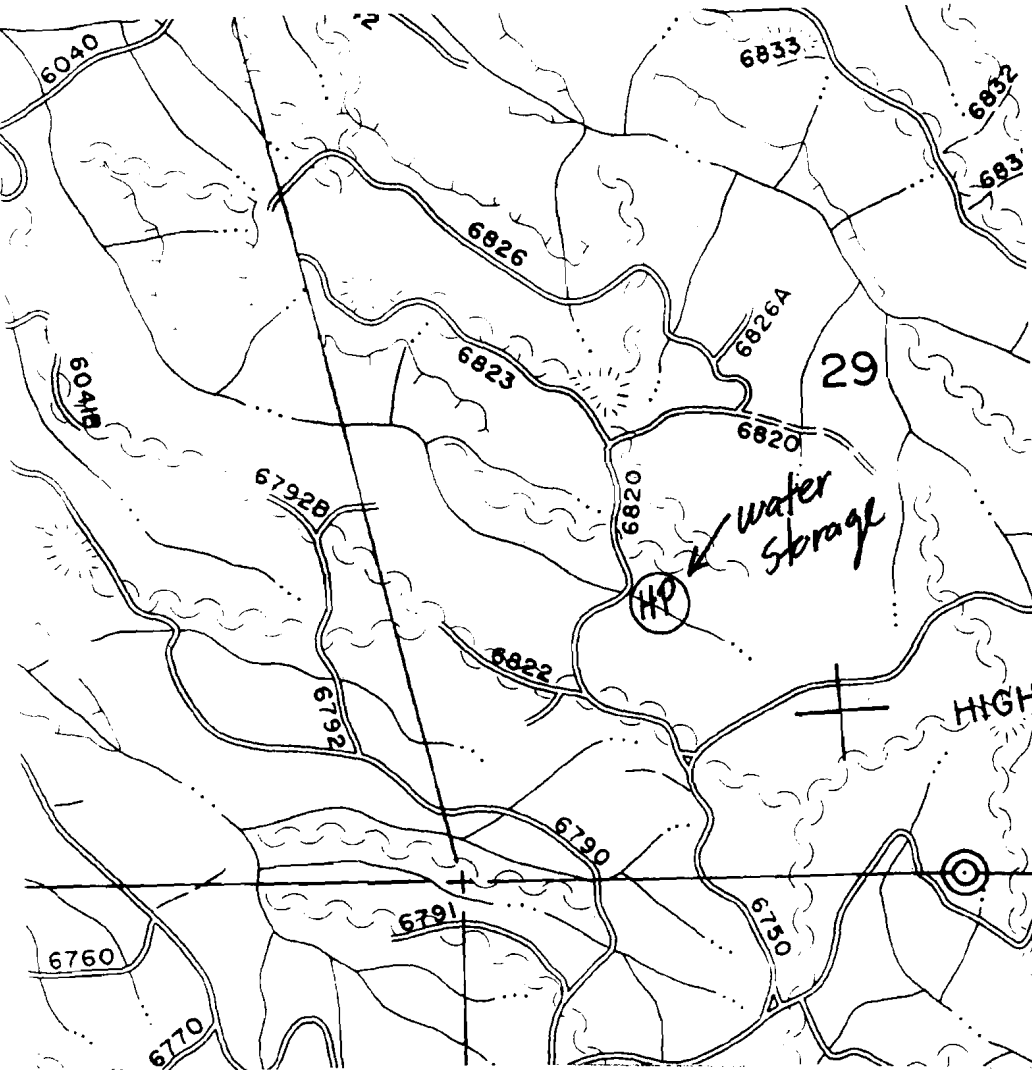

N↑

Map Scale: 1" = 1000 feet

Section 29

Township 25 South

Range 9 West

Forty SW 1/4, SW 1/4

River Basin Coos River

Gallons of Water Stored: 80 750

Purpose of Impounded Water:

1. Emergency Fire Suppression
2. _____

Application No. 12-79298
Permit No.

7175


Weyerhaeuser Company

Water Storage Site Map

RECEIVED

JAN - 3 1995

WATER DIVISION
SALEM, OREGON

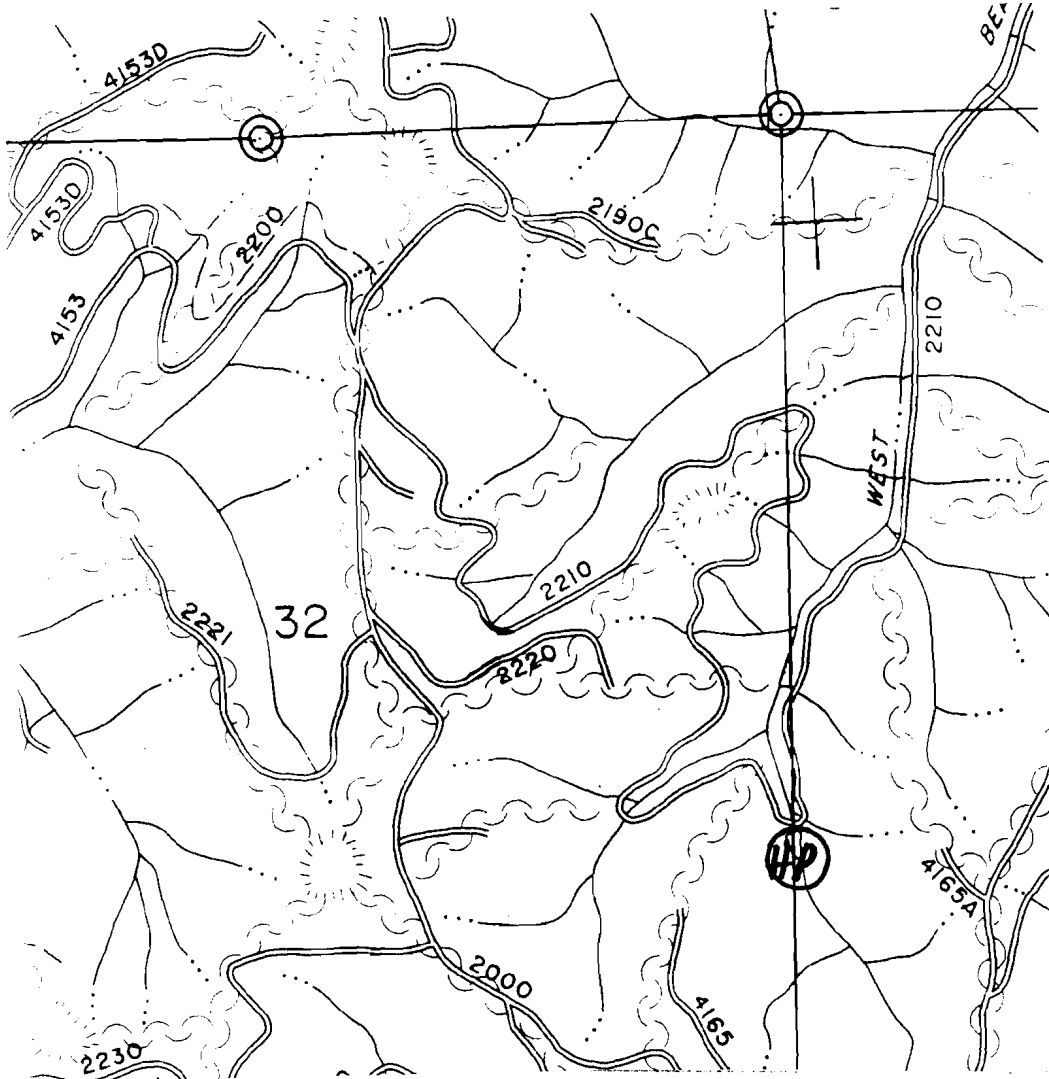

N↑

Map Scale: 1" = 1000 feet

Section 32 | 33

Township 24 South

Range 9 West

Forty NE 1/4, SE 1/4 + NW 1/4, SW 1/4

River Basin Coos River

Gallons of Water Stored: 125,600

Purpose of Impounded Water:

1. Emergency Fire Suppression,

2. _____

Application No. R-79298
Permit No.

71475


Weyerhaeuser Company

Water Storage Site Map

RECEIVED

JAN - 3 1995

WATER
SALEM, OREGON

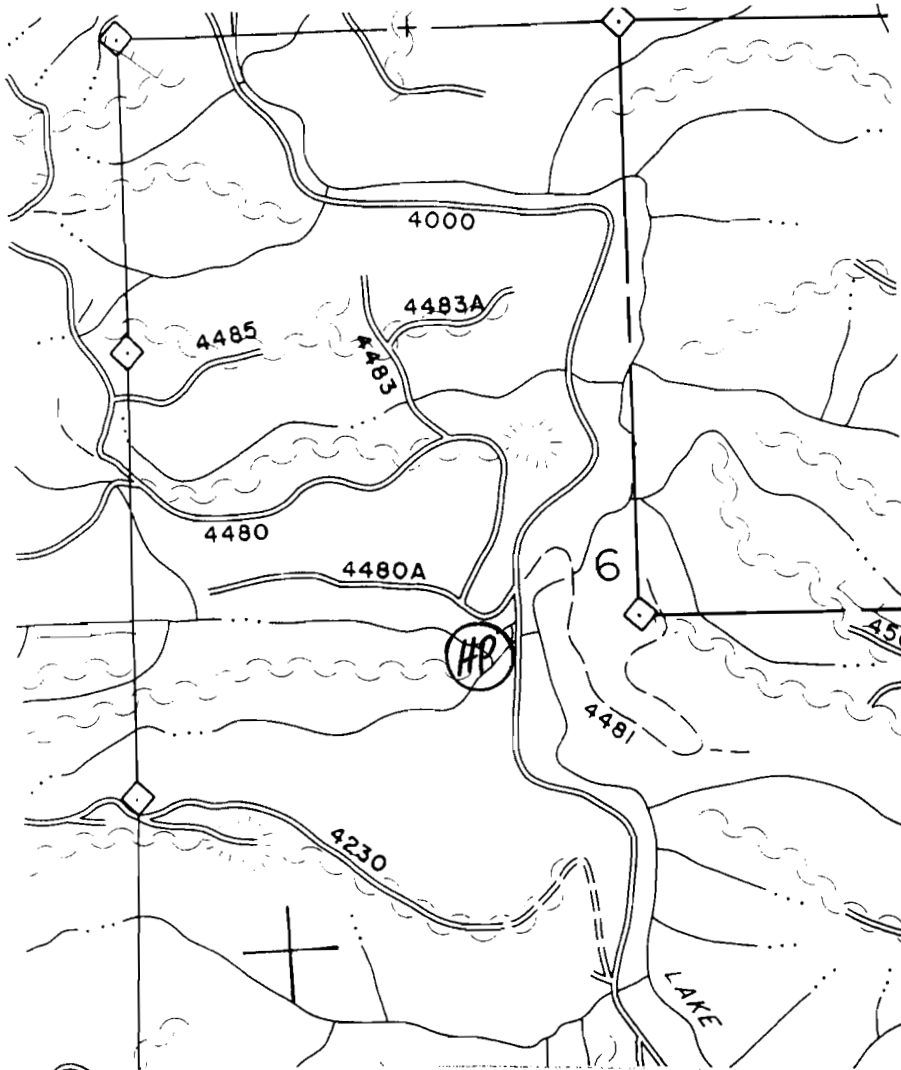

N↑

Map Scale: 1" = 1000 feet

Section 6

Township 25S

Range 8W

Forty NE 1/4, SW 1/4

River Basin Coos River

Gallons of Water Stored: 95700

Purpose of Impounded Water:

1. Emergency Fire Suppression .

2. _____

Application No. K-79298
Permit No. _____

