

7-176


Weyerhaeuser Company

RECEIVED

JAN - 3 1995

WATER DIVISION
SALEM, OREGON

Water Storage Site Map

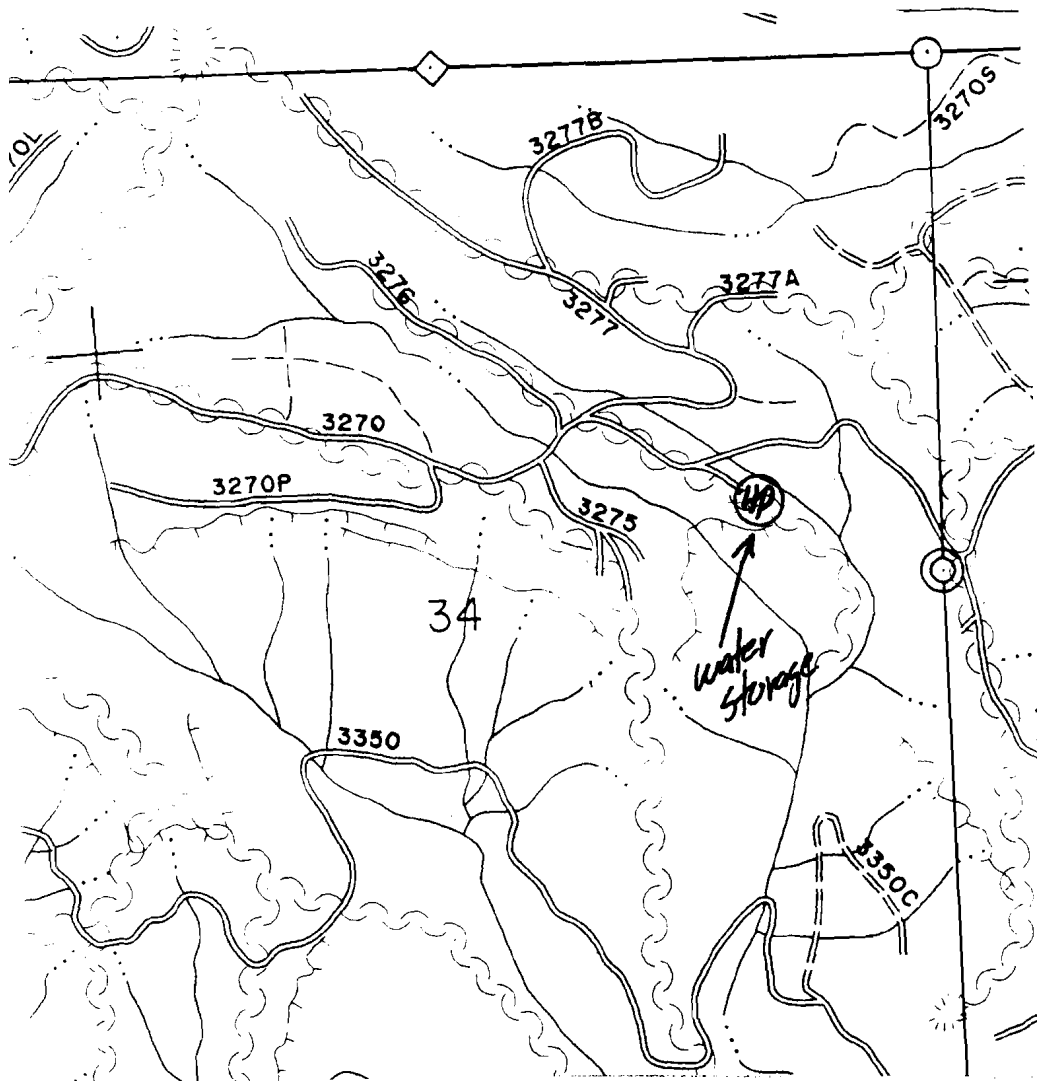

N↑

Map Scale: 1" = 1000 feet

Section 34

Township 23 South

Range 9 West

Forty SE 1/4, NE 1/4

River Basin Coxs River

Gallons of Water Stored: 11100

Purpose of Impounded Water:

1. Emergency Fire Suppression
2. _____

Application No. 2-79299
Permit No.

71476


Weyerhaeuser Company

Water Storage Site Map

RECEIVED

JAN - 3 1995

WATER
SALEM, OREGON

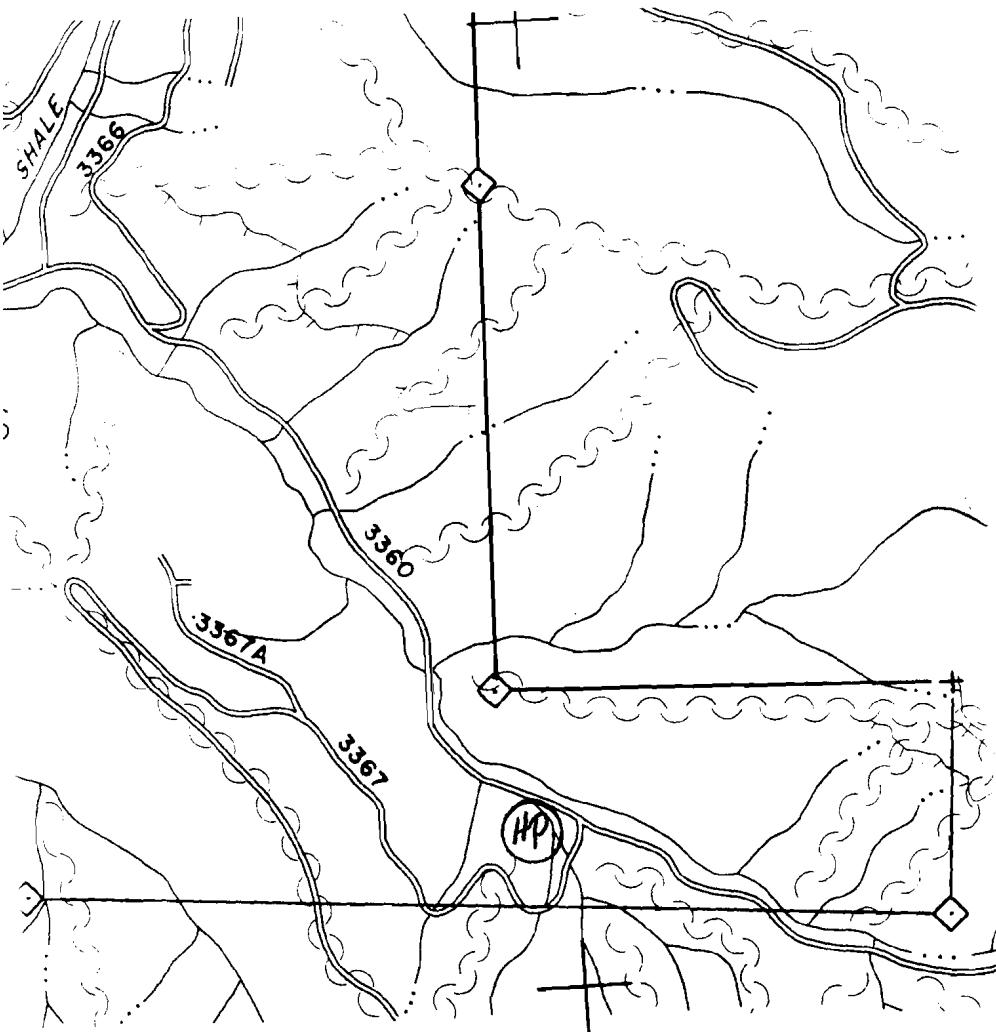

N↑

Map Scale: 1" = 1000 feet

Section 36

Township 23 South

Range 9 West

Forty SE 1/4, SE 1/4

River Basin Coos River

Gallons of Water Stored: 102 700

Purpose of Impounded Water:

1. Emergency Fire Suppression

2. _____

Application No 12-79299
Permit No.

71176


Weyerhaeuser Company

RECEIVED

JAN - 3 1995

WATER RES.
SALEM, OREGON

Water Storage Site Map

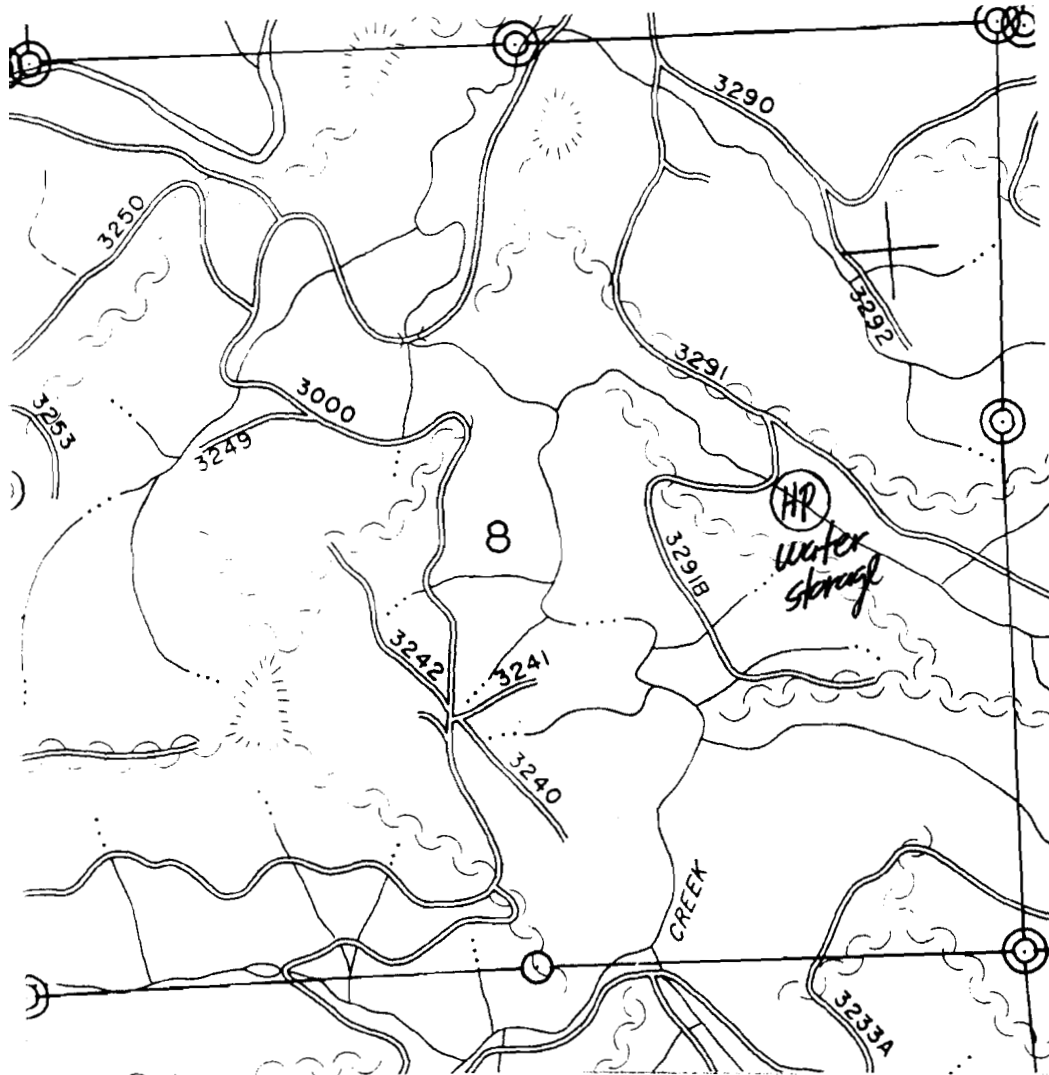

N↑

Map Scale: 1" = 1000 feet

Section 8

Township 24 South

Range 9 West

Forty SE 1/4, NE 1/4

River Basin Coos River

Gallons of Water Stored: 1,000,000

Purpose of Impounded Water:

1. Emergency Fire Suppression ,
2. _____

Application No. R-79299
Permit No.

71476


Weyerhaeuser Company

RECEIVED

JAN - 3 1995

WATER RES.
SALEM, OREGON

Water Storage Site Map

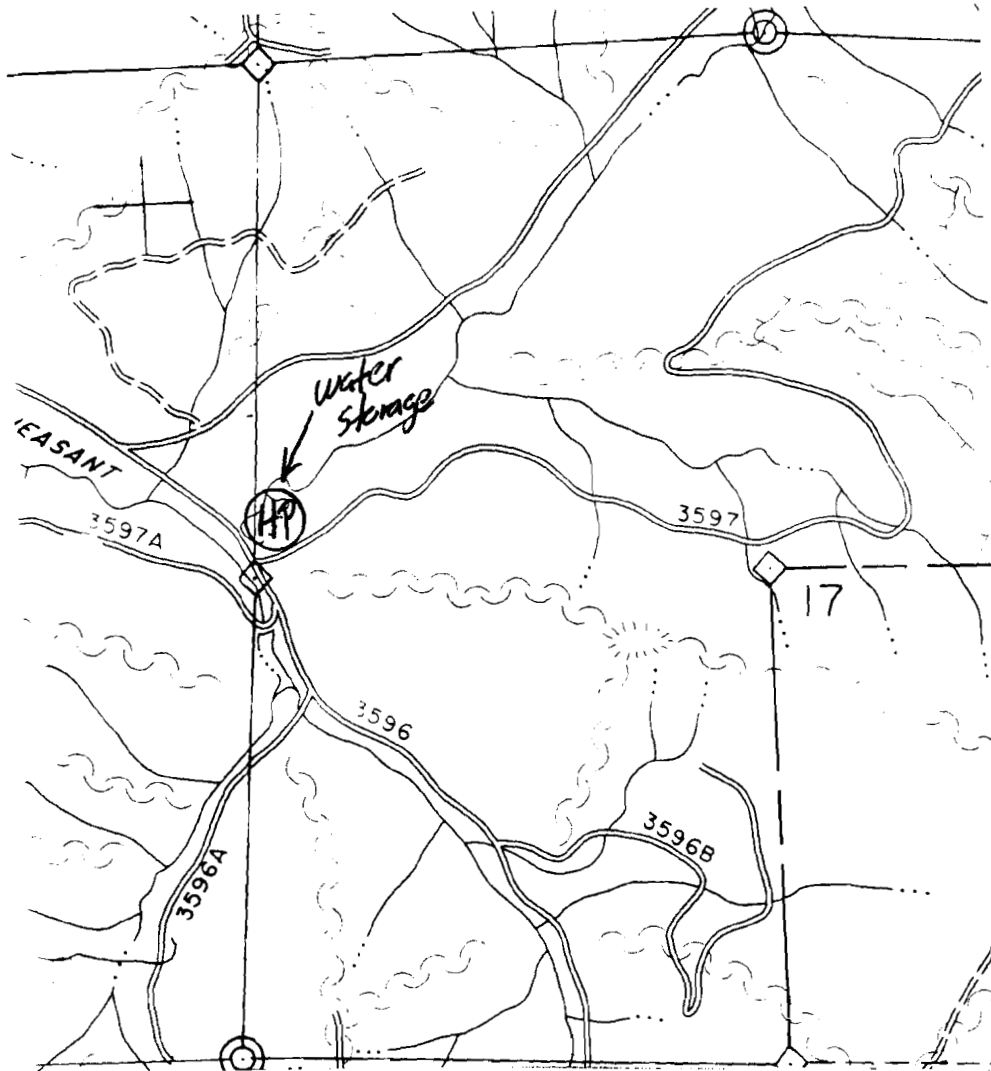

N↑

Map Scale: 1" = 1000 feet

Section 17

Township 24 South

Range 8 West

Forty SW 1/4, NW 1/4

River Basin Coos River

Gallons of Water Stored: 83600

Purpose of Impounded Water:

1. Emergency Fire Suppression

2. _____

Application No R-79299
Permit No.

7-176


Weyerhaeuser Company

Water Storage Site Map

RECEIVED

JAN - 3 1995

WATER RESOURCES
SALEM, OREGON - P.T.

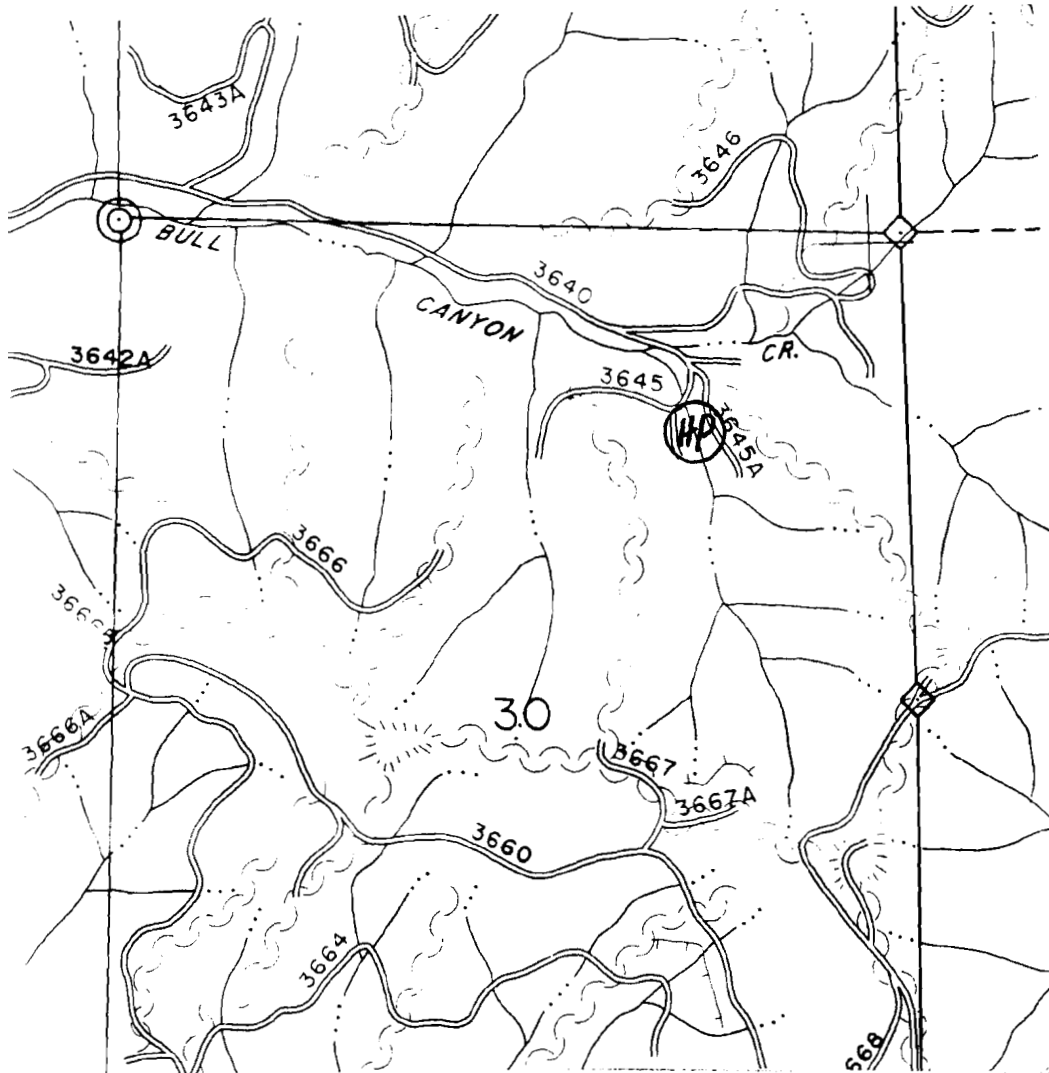

N↑

Map Scale: 1" = 1000 feet

Section 30

Township 24 South

Range 8 West

Forty NW 1/4, NE 1/4

River Basin Coos River

Gallons of Water Stored: 90 950

Purpose of Impounded Water:

1. Emergency Fire Suppression ,

2. _____

Application No R-79299
Permit No.

71476


Weyerhaeuser Company

Water Storage Site Map

RECEIVED

JAN - 3 1995

WATER RESOURCES
SALEM, OREGON

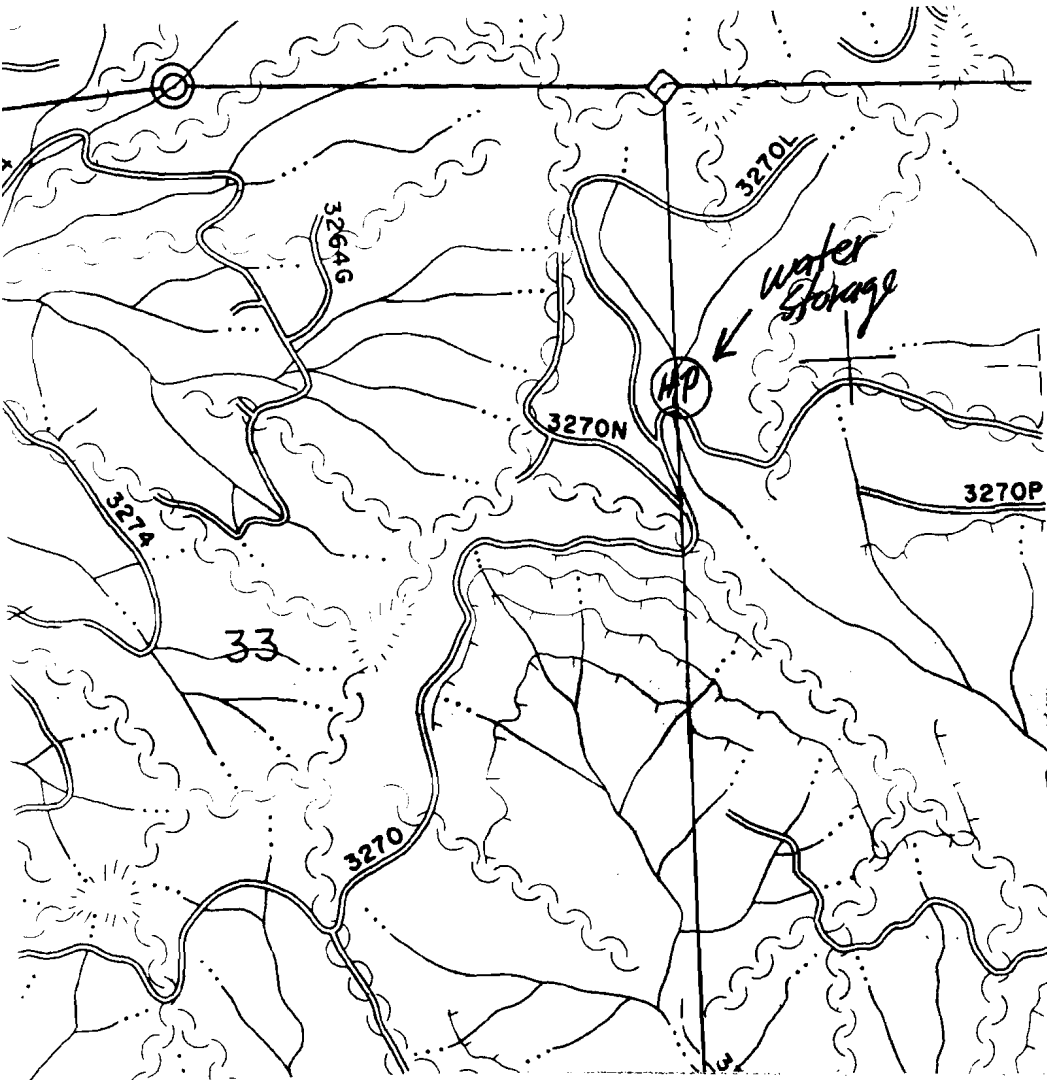

N↑

Map Scale: 1" = 1000 feet

Section 33 & 34

Township 23 South

Range 9 west

Forty SE 1/4, NE 1/4 & SW 1/4, NW 1/4

River Basin Coos River

Gallons of Water Stored: 67000

Purpose of Impounded Water:

1. Emergency Fire Suppression,

2. _____

Application No.
Permit No.

R-79299

71176

CERTIFICATE NO.

Weyerhaeuser Company

#2

RECEIVED

JAN - 3 1995

WATER RESOURCES
SALEM, OREGON

Water Storage Site Map

N↑

Map Scale: 1" = 1000 feet


Section 27

Township 25S

Range 8W
NE 1/4, SE 1/4

Forty SE 1/4, SE 1/4

River Basin Umpqua
River

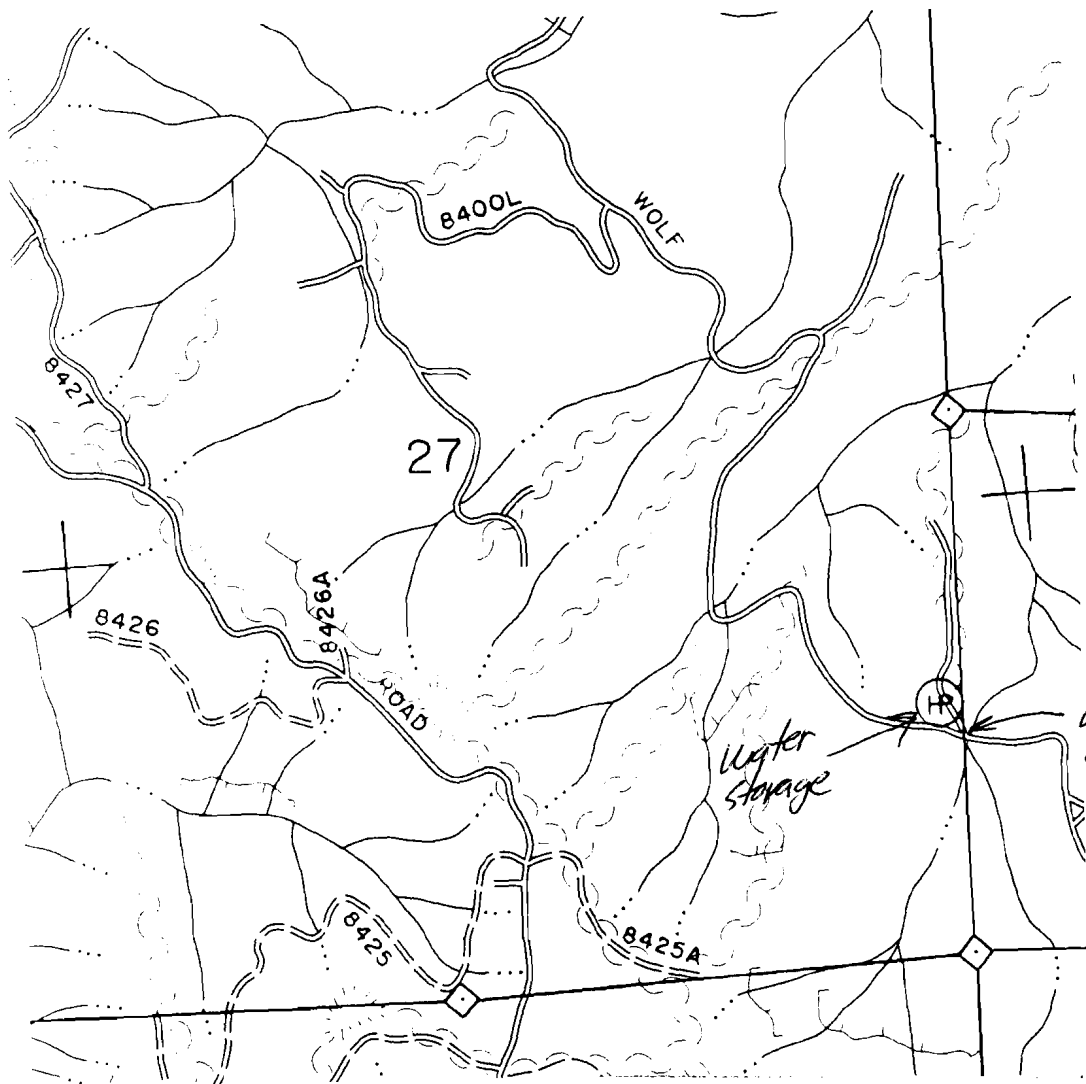

Gallons of Water Stored: 44500

Purpose of Impounded Water:

1. Emergency Fire Suppression

2. _____

Application No. R-79299
Permit No.