

71178

Weyerhaeuser Company

Water Storage Site Map

RECEIVED

JAN - 3 1995

WATER RESOURCES DEPT.
SALEM, OREGON

N↑

Map Scale: 1" = 1000 feet


Section 10

Township 25 South

Range 9 West

Forty NW 1/4, NW 1/4

River Basin COOS River

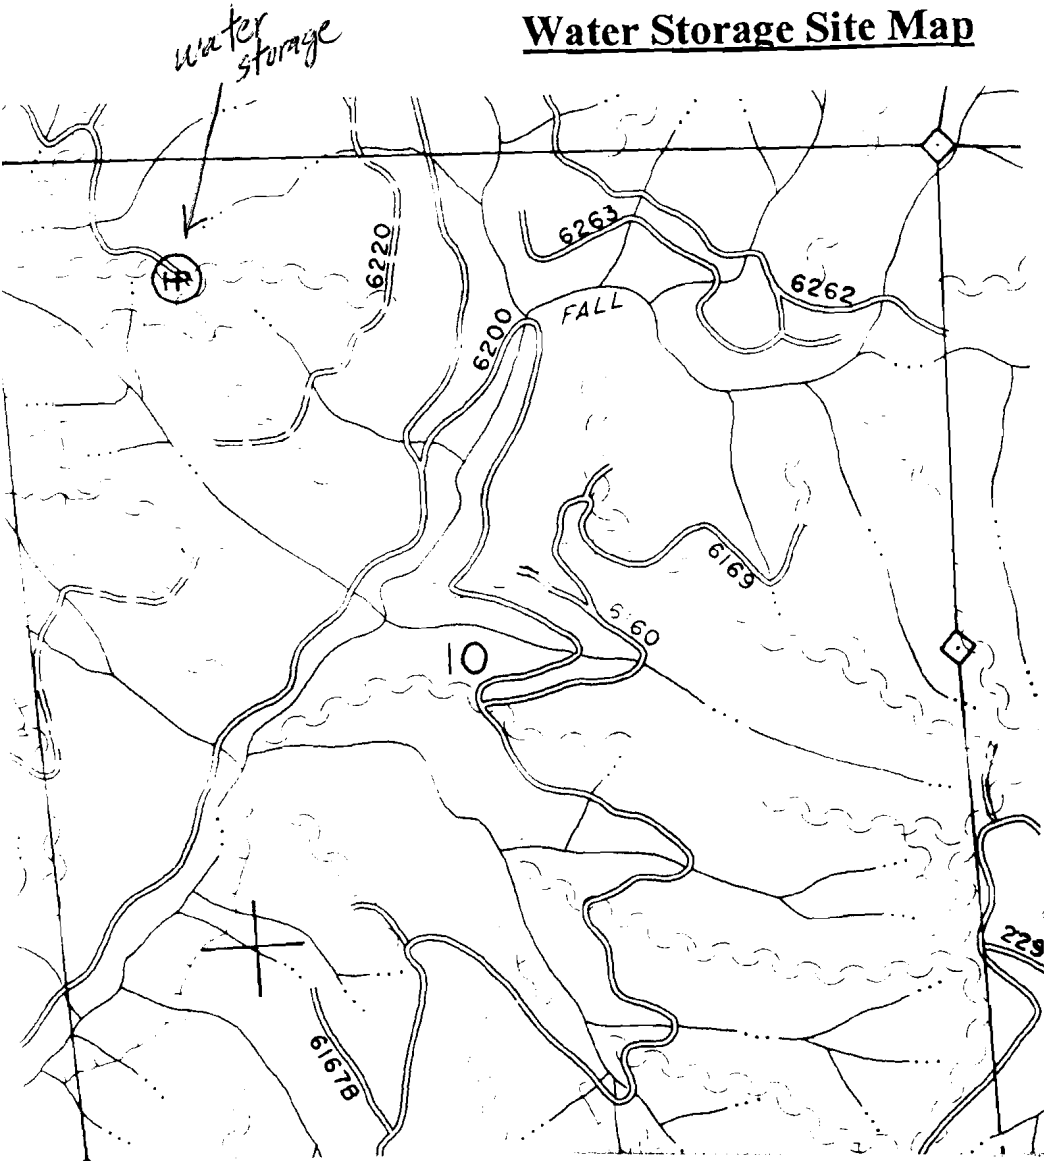

Gallons of Water Stored: 12400

Purpose of Impounded Water:

1. Emergency Fire Suppression
2. _____

Application No. 2-79528
Permit No.

71178

Weyerhaeuser Company

Water Storage Site Map

RECEIVED

JAN - 3 1995

WATER RESOURCES
SALEM, OREGON

N↑

Map Scale: 1" = 1000 feet


Section 16

Township 27S

Range 8W

Forty NW 1/4, SE 1/4

River Basin COOS River

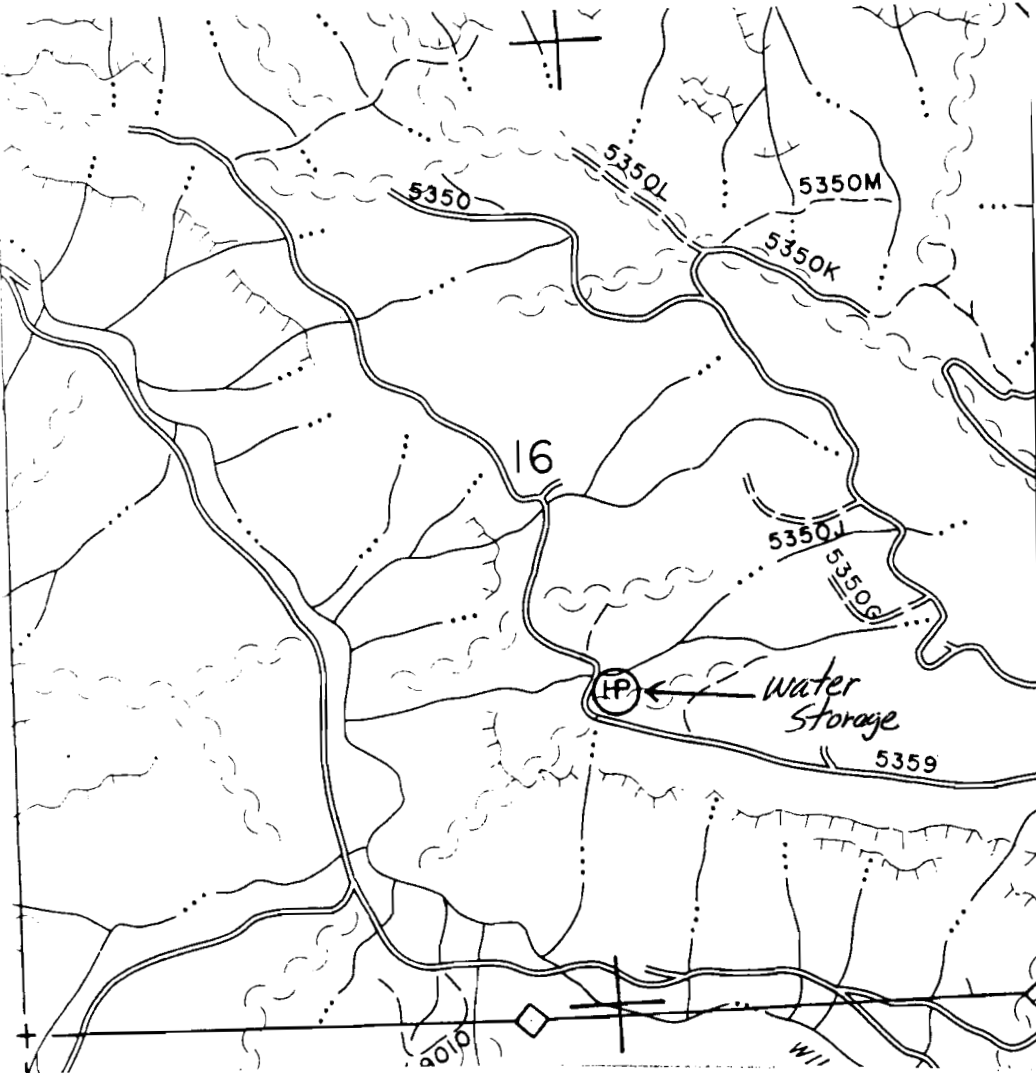

Gallons of Water Stored: 43197

Purpose of Impounded Water:

1. Emergency Fire Suppression.
2. _____


Application No. K-79528
Permit No. _____

71178

Weyerhaeuser Company

Water Storage Site Map

RECEIVED
JAN - 3 1995
WATER RESOURCES DIV.
SALEM, OREGON

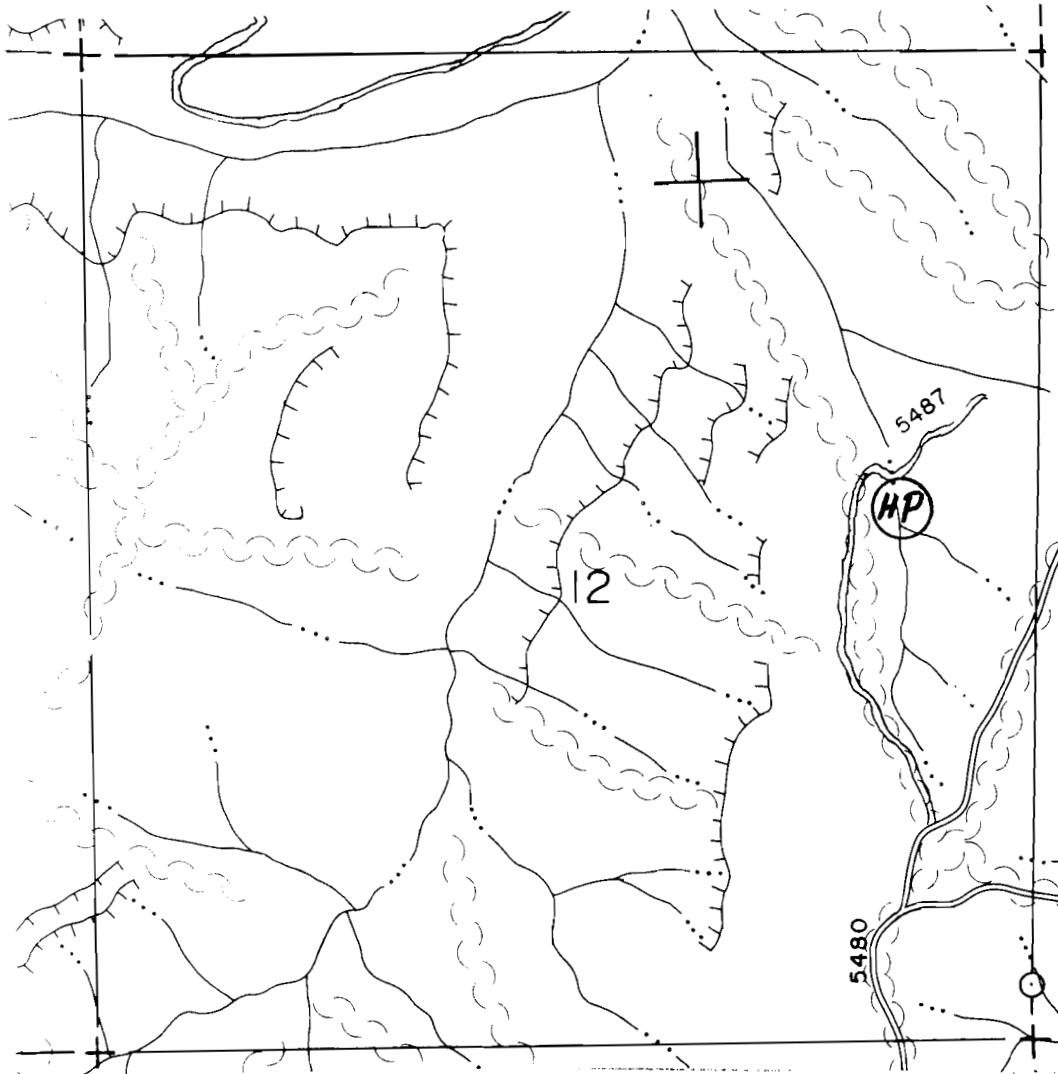

N↑

Map Scale: 1" = 1000 feet

Section 12

Township 27.5

Range 9W

Forty SE 1/4, NE 1/4

River Basin COOS River

Gallons of Water Stored: 98735

Purpose of Impounded Water:

1. Emergency Fire Suppression

2. _____

Application No R-79528
Permit No. _____

71478

Weyerhaeuser Company

Water Storage Site Map

RECEIVED #19

JAN - 3 1995

WATER RESOURCES DEPT.
SALEM, OREGON

N↑

Map Scale: 1" = 1000 feet


Section 13

Township 27 S

Range 9 W

Forty SE 1/4, NE 1/4

River Basin COOS
River

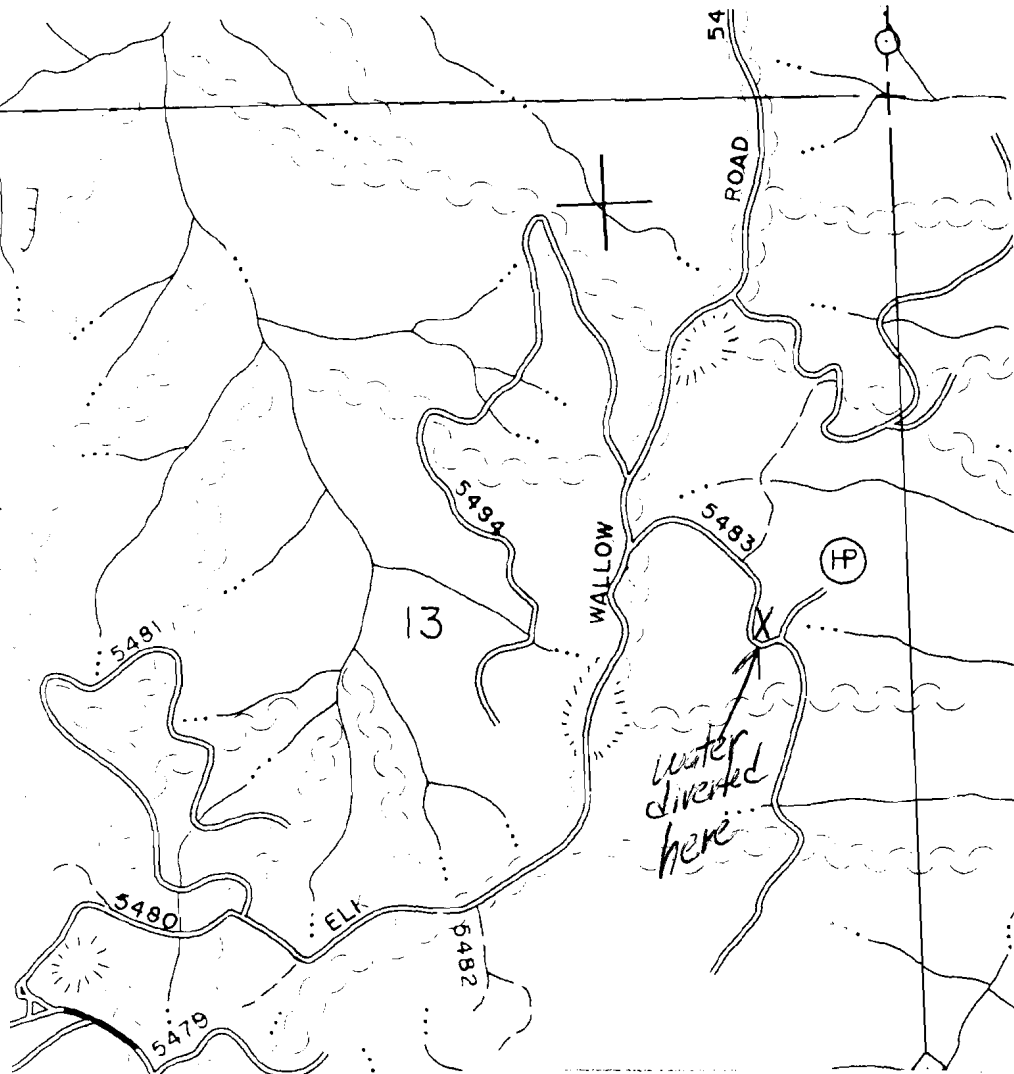

Gallons of Water Stored: 9200

Purpose of Impounded Water:

1. Emergency Fire Suppression

2. _____

Application No. 12-79528
Permit No.

23-8

RECEIVED

JAN - 3 1995

WATER RESOURCES DEPT.
SALEM, OREGON

Weyerhaeuser Company

Water Storage Site Map

N↑

Map Scale: 1" = 1000 ft


Section 33

Township 27S

Range 8W

Forty SE 1/4, Sec 14

River Basin Cos. River

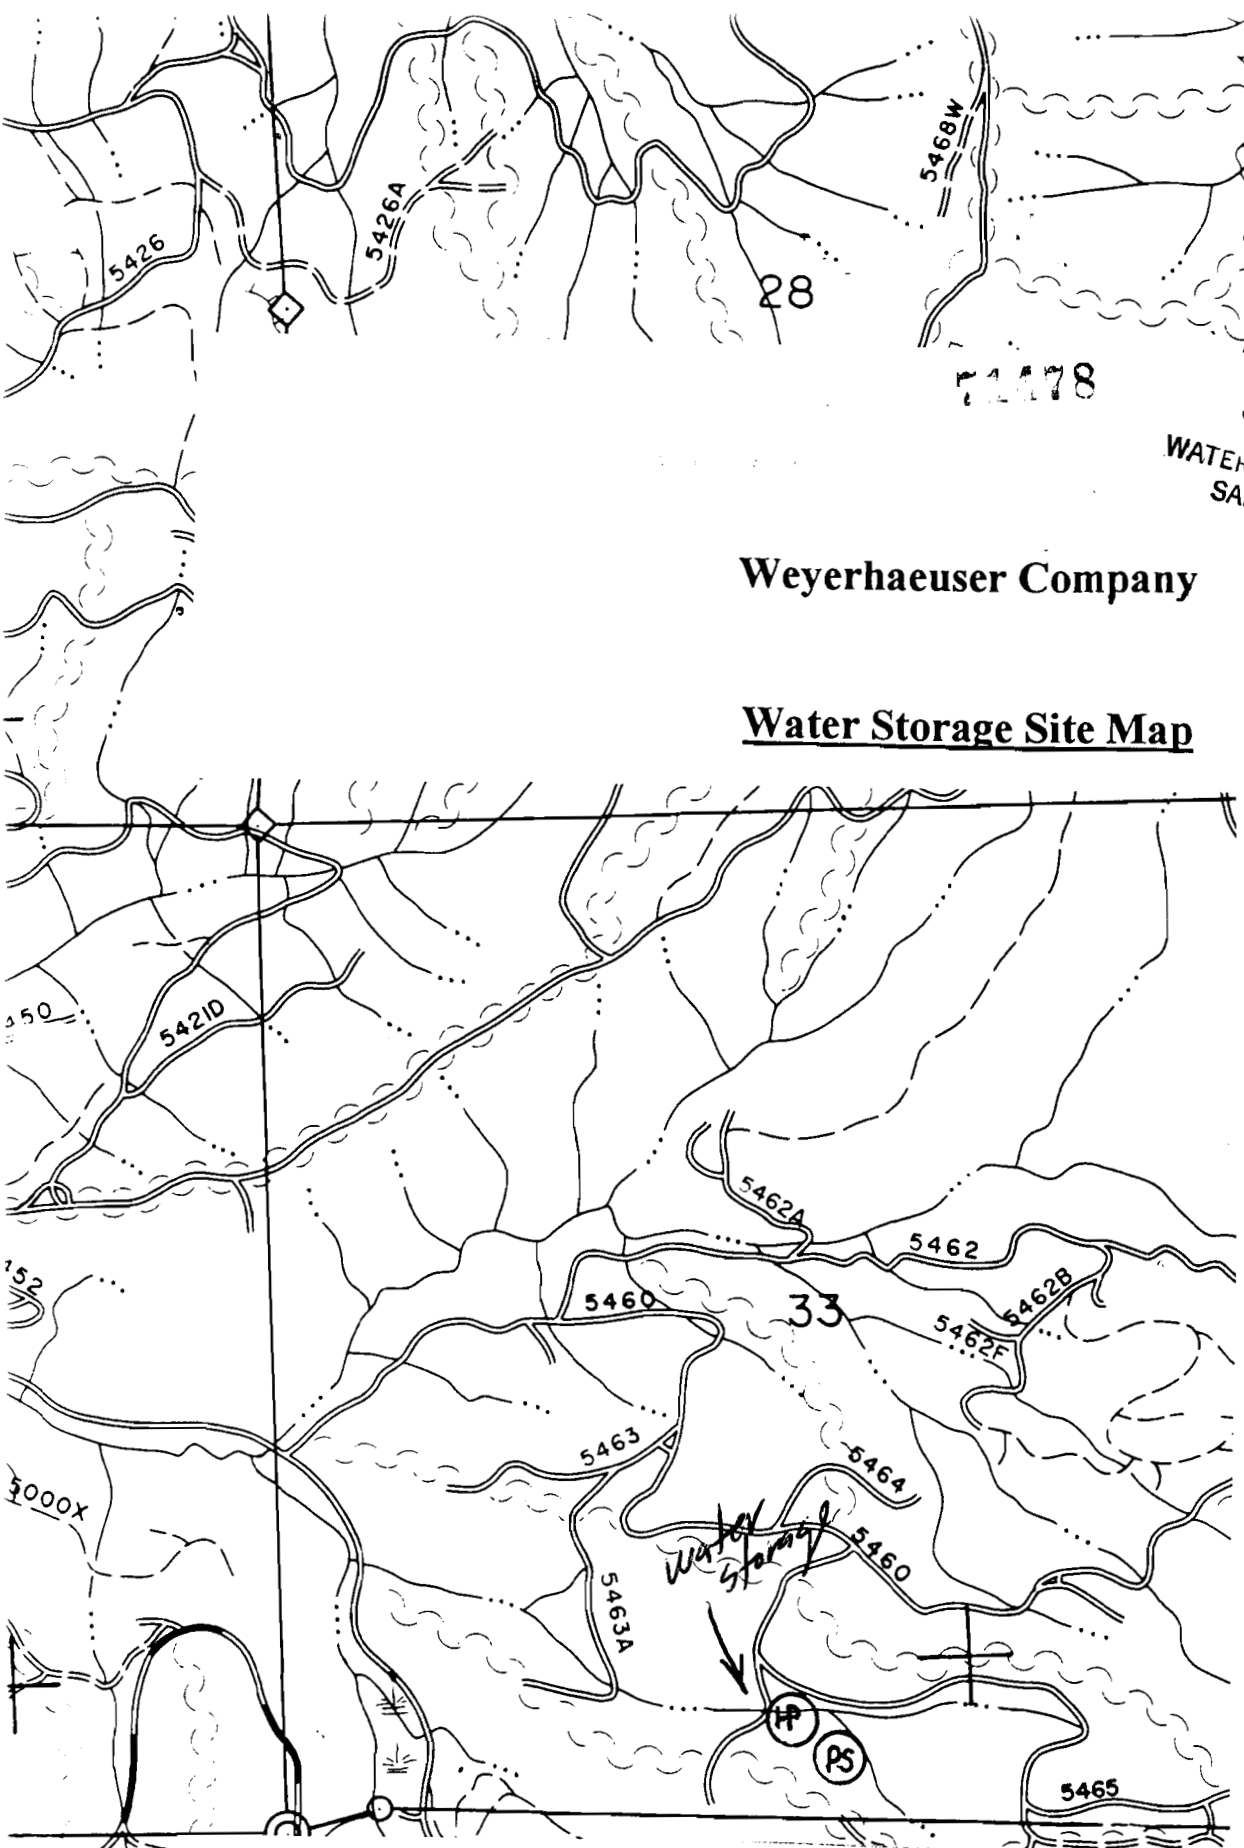

Application No. R-79528

Permit No.

Gallons of Water Stored: 110,975

Purpose of Impounded Water:

Fire Suppression

71278

Weyerhaeuser Company

#12

Water Storage Site Map

RECEIVED

JAN - 3 1995

WATER ...
SALEM, OREGON

N ↑

Map Scale: 1" = 1000 feet


Section 5

Township 27S

Range 8W

Forty SW 1/4, NW 1/4

River Basin
Coos River

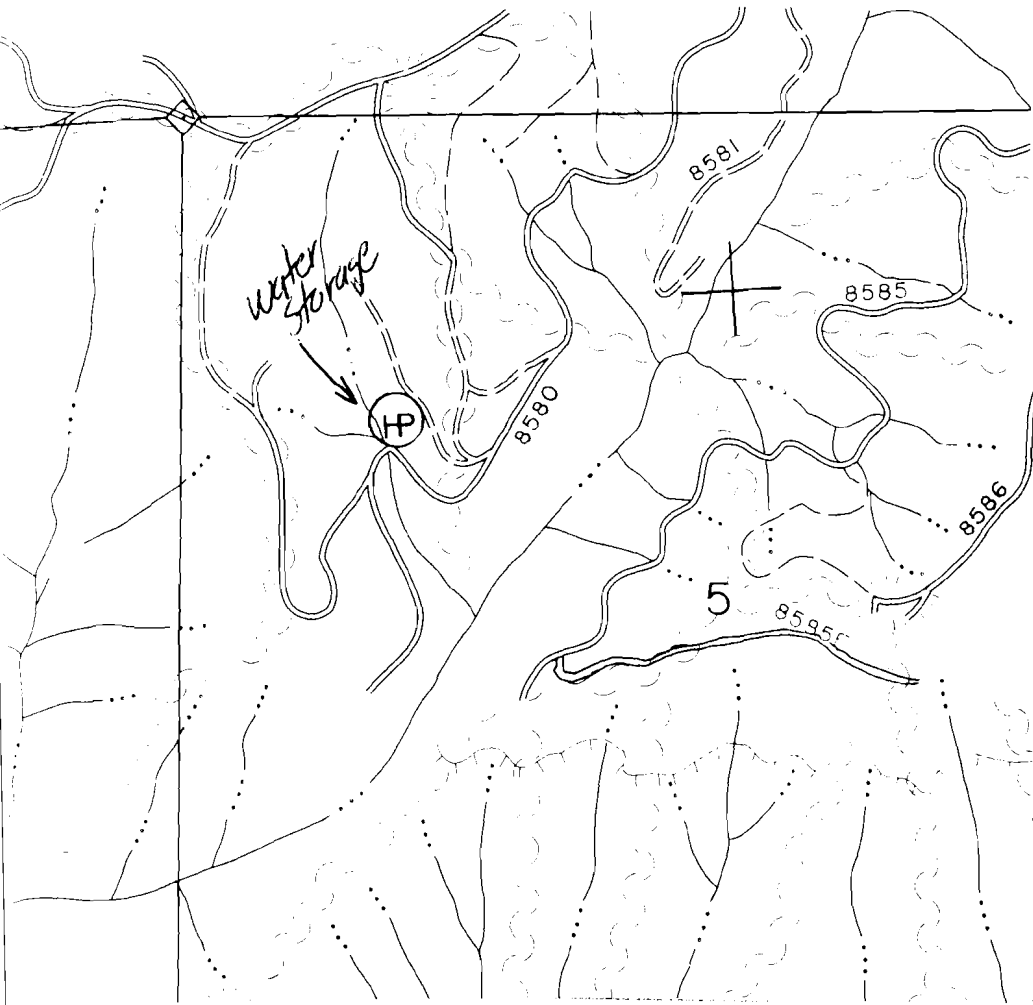

Gallons of Water Stored: 55539

Purpose of Impounded Water:

1. Emergency Fire Suppression .
2. _____

Application No. R-79528
Permit No.

71178

Weyerhaeuser Company



RECEIVED

JAN - 3 1995

WATER DIVISION
SALEM, OREGON



Map Scale: 1" = 1000 feet

Section 36


Township 26 S

Range 9 W

Forty SE 1/4, SE 1/4

River Basin COOS

River

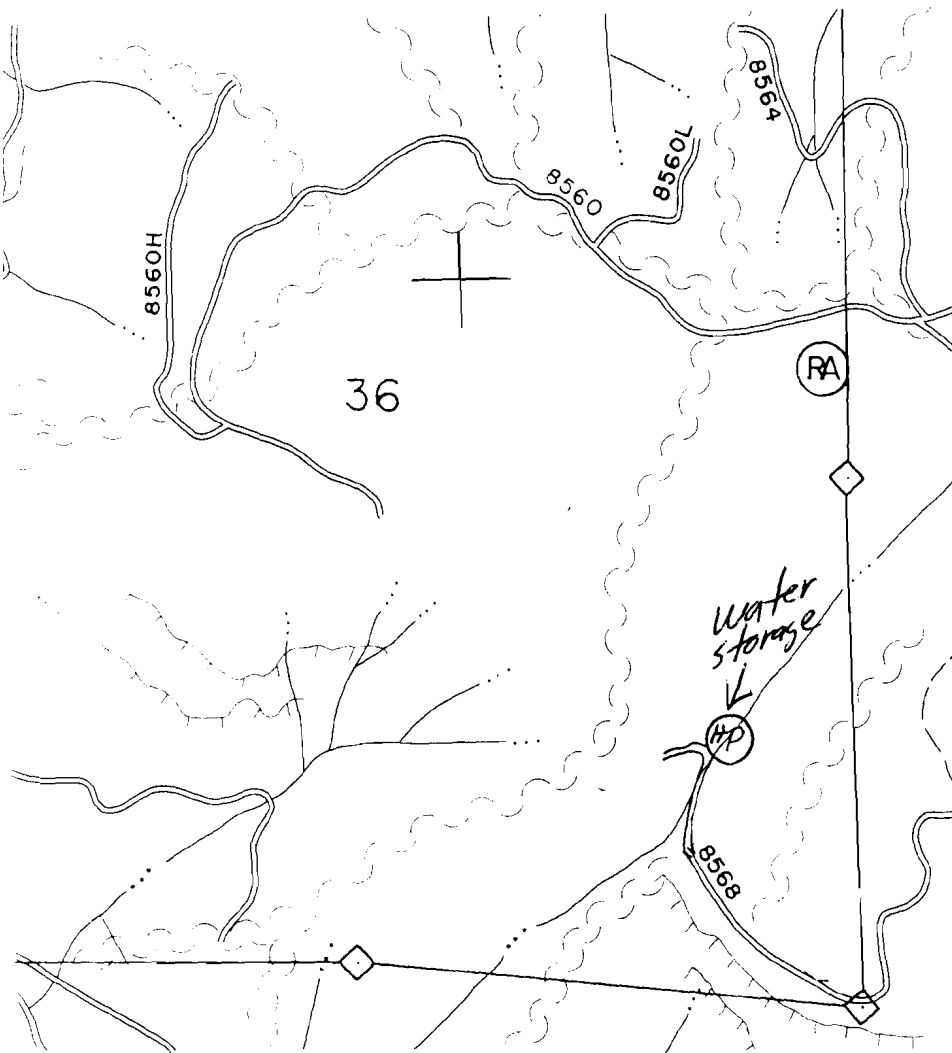

Gallons of Water Stored: 75735

Purpose of Impounded Water:

1. Emergency Fire Suppression .

2. _____

Application No. R-79528
Permit No.

71178

71178

CONTINUING

#17

Weyerhaeuser Company


RECEIVED

JAN - 3 1995

Water Storage Site MapWATER RES.
SALEM, OREGON

N↑

Map Scale: 1" = 1000

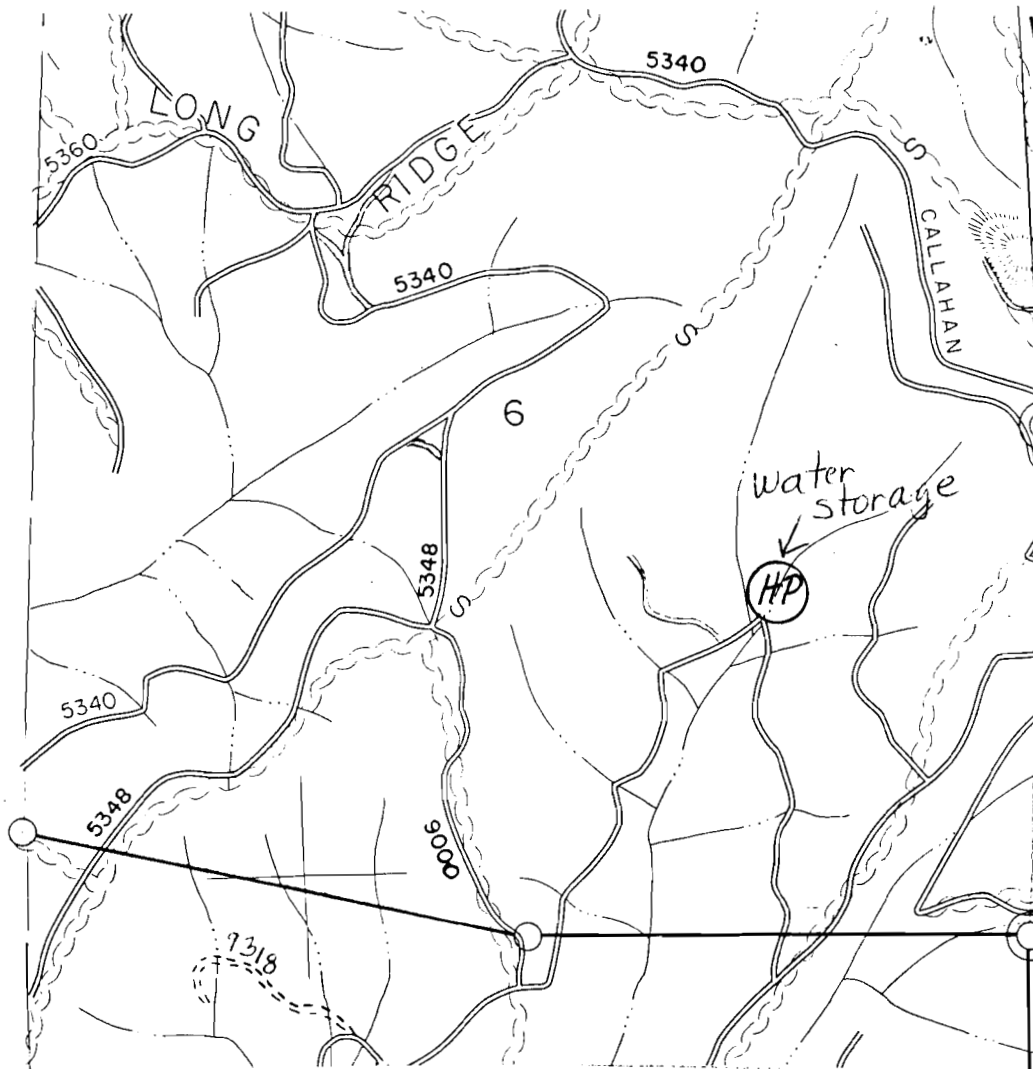Section 6Township 27SRange 7WForty NW 1/4 NE 1/2
SE 1/4River Basin COOS
RiverGallons of Water Stored: 165682

Purpose of Impounded Water:

1. Emergency Fire Suppression

2. _____

Application No. R-79528
Permit No.

72118

Weyerhaeuser Company

Water Storage Site Map



N↑

Map Scale: 1" = 1000 feet


Section 27

Township 26

Range 8

Forty NE 1/4, NW 1/4

River Basin COOS River

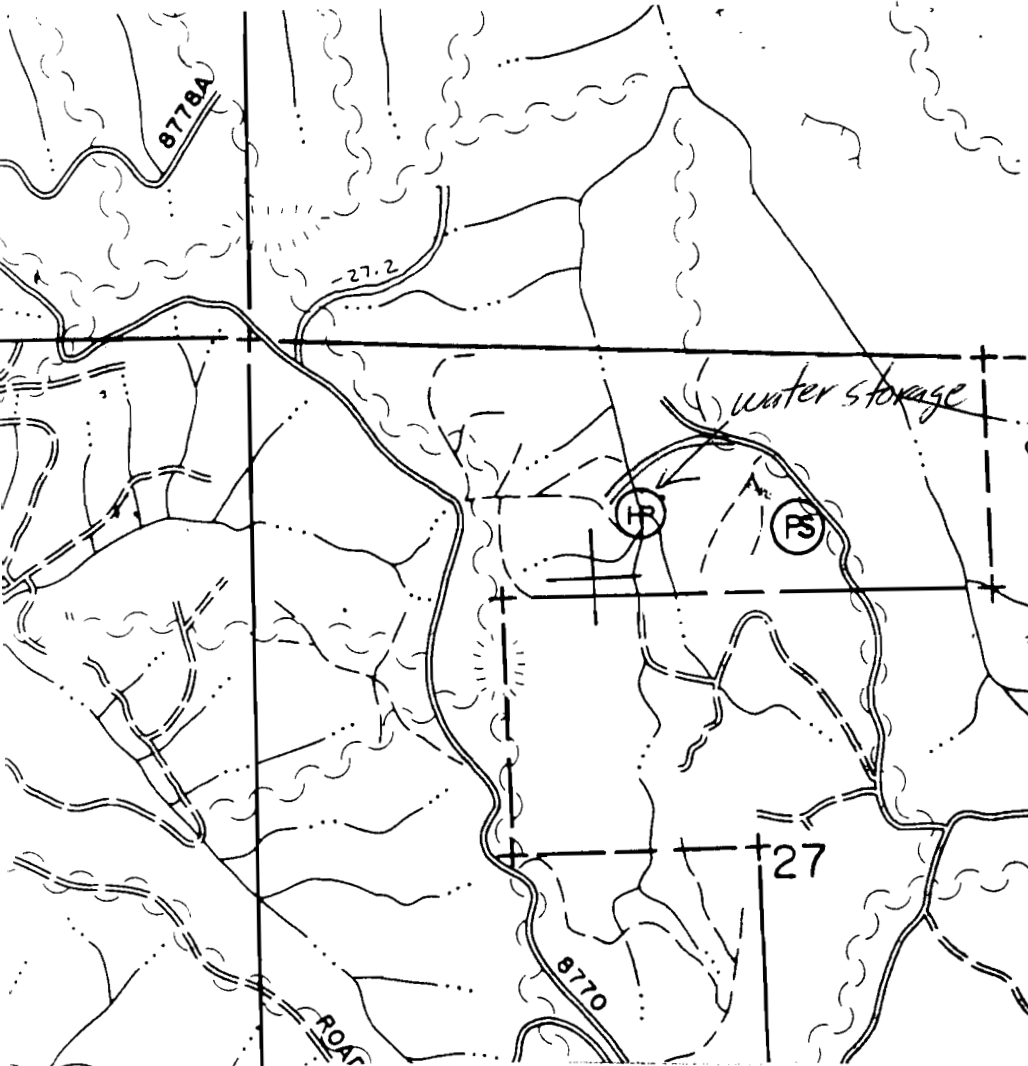

Gallons of Water Stored: 127,234

Purpose of Impounded Water:

1. Emergency Fire Suppression .

2. _____


Application No. R-79528
Permit No.

71178

Weyerhaeuser Company

Water Storage Site Map

RECEIVED
JAN - 3 1995
WATER RESOURCES
SALEM, OREGON

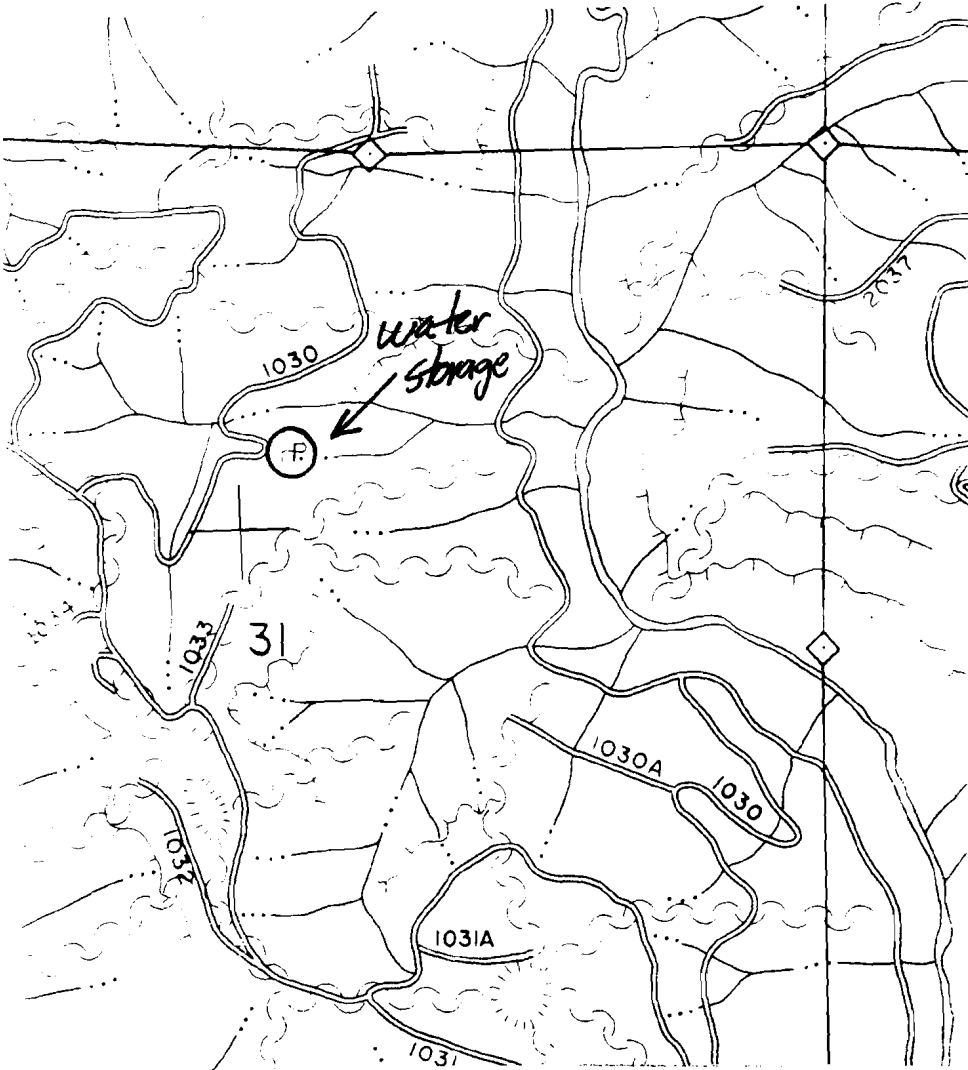

N↑

Map Scale: 1" = 1000 feet

Section 31/32

Township 24 South

Range 10 West

Forty SE 1/4, NW 1/4

River Basin Coos River

Gallons of Water Stored: 22600

Purpose of Impounded Water:

1. Emergency Fire Suppression

2. _____

Application No. R 79528
Permit No.